



PARENT PARCEL: 21-09-000-000-004, -008 21-16-000-000-001, 21-15-000-000-009
 CHILD PARCEL: 21-09-000-000-009
 STARTING POINT: TRACT LINE OF 16 AND 15 AMD CENTER LINE OF NEW LONDON RD.

12-03019-1

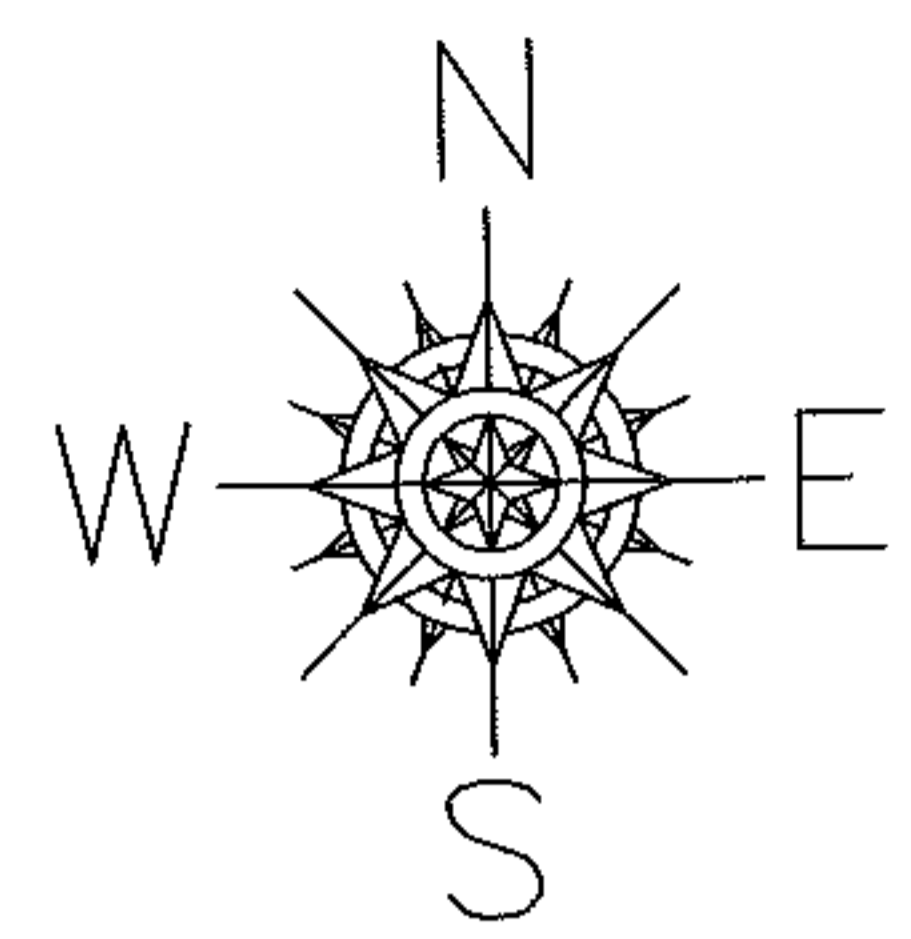

MAP 1 OF 3

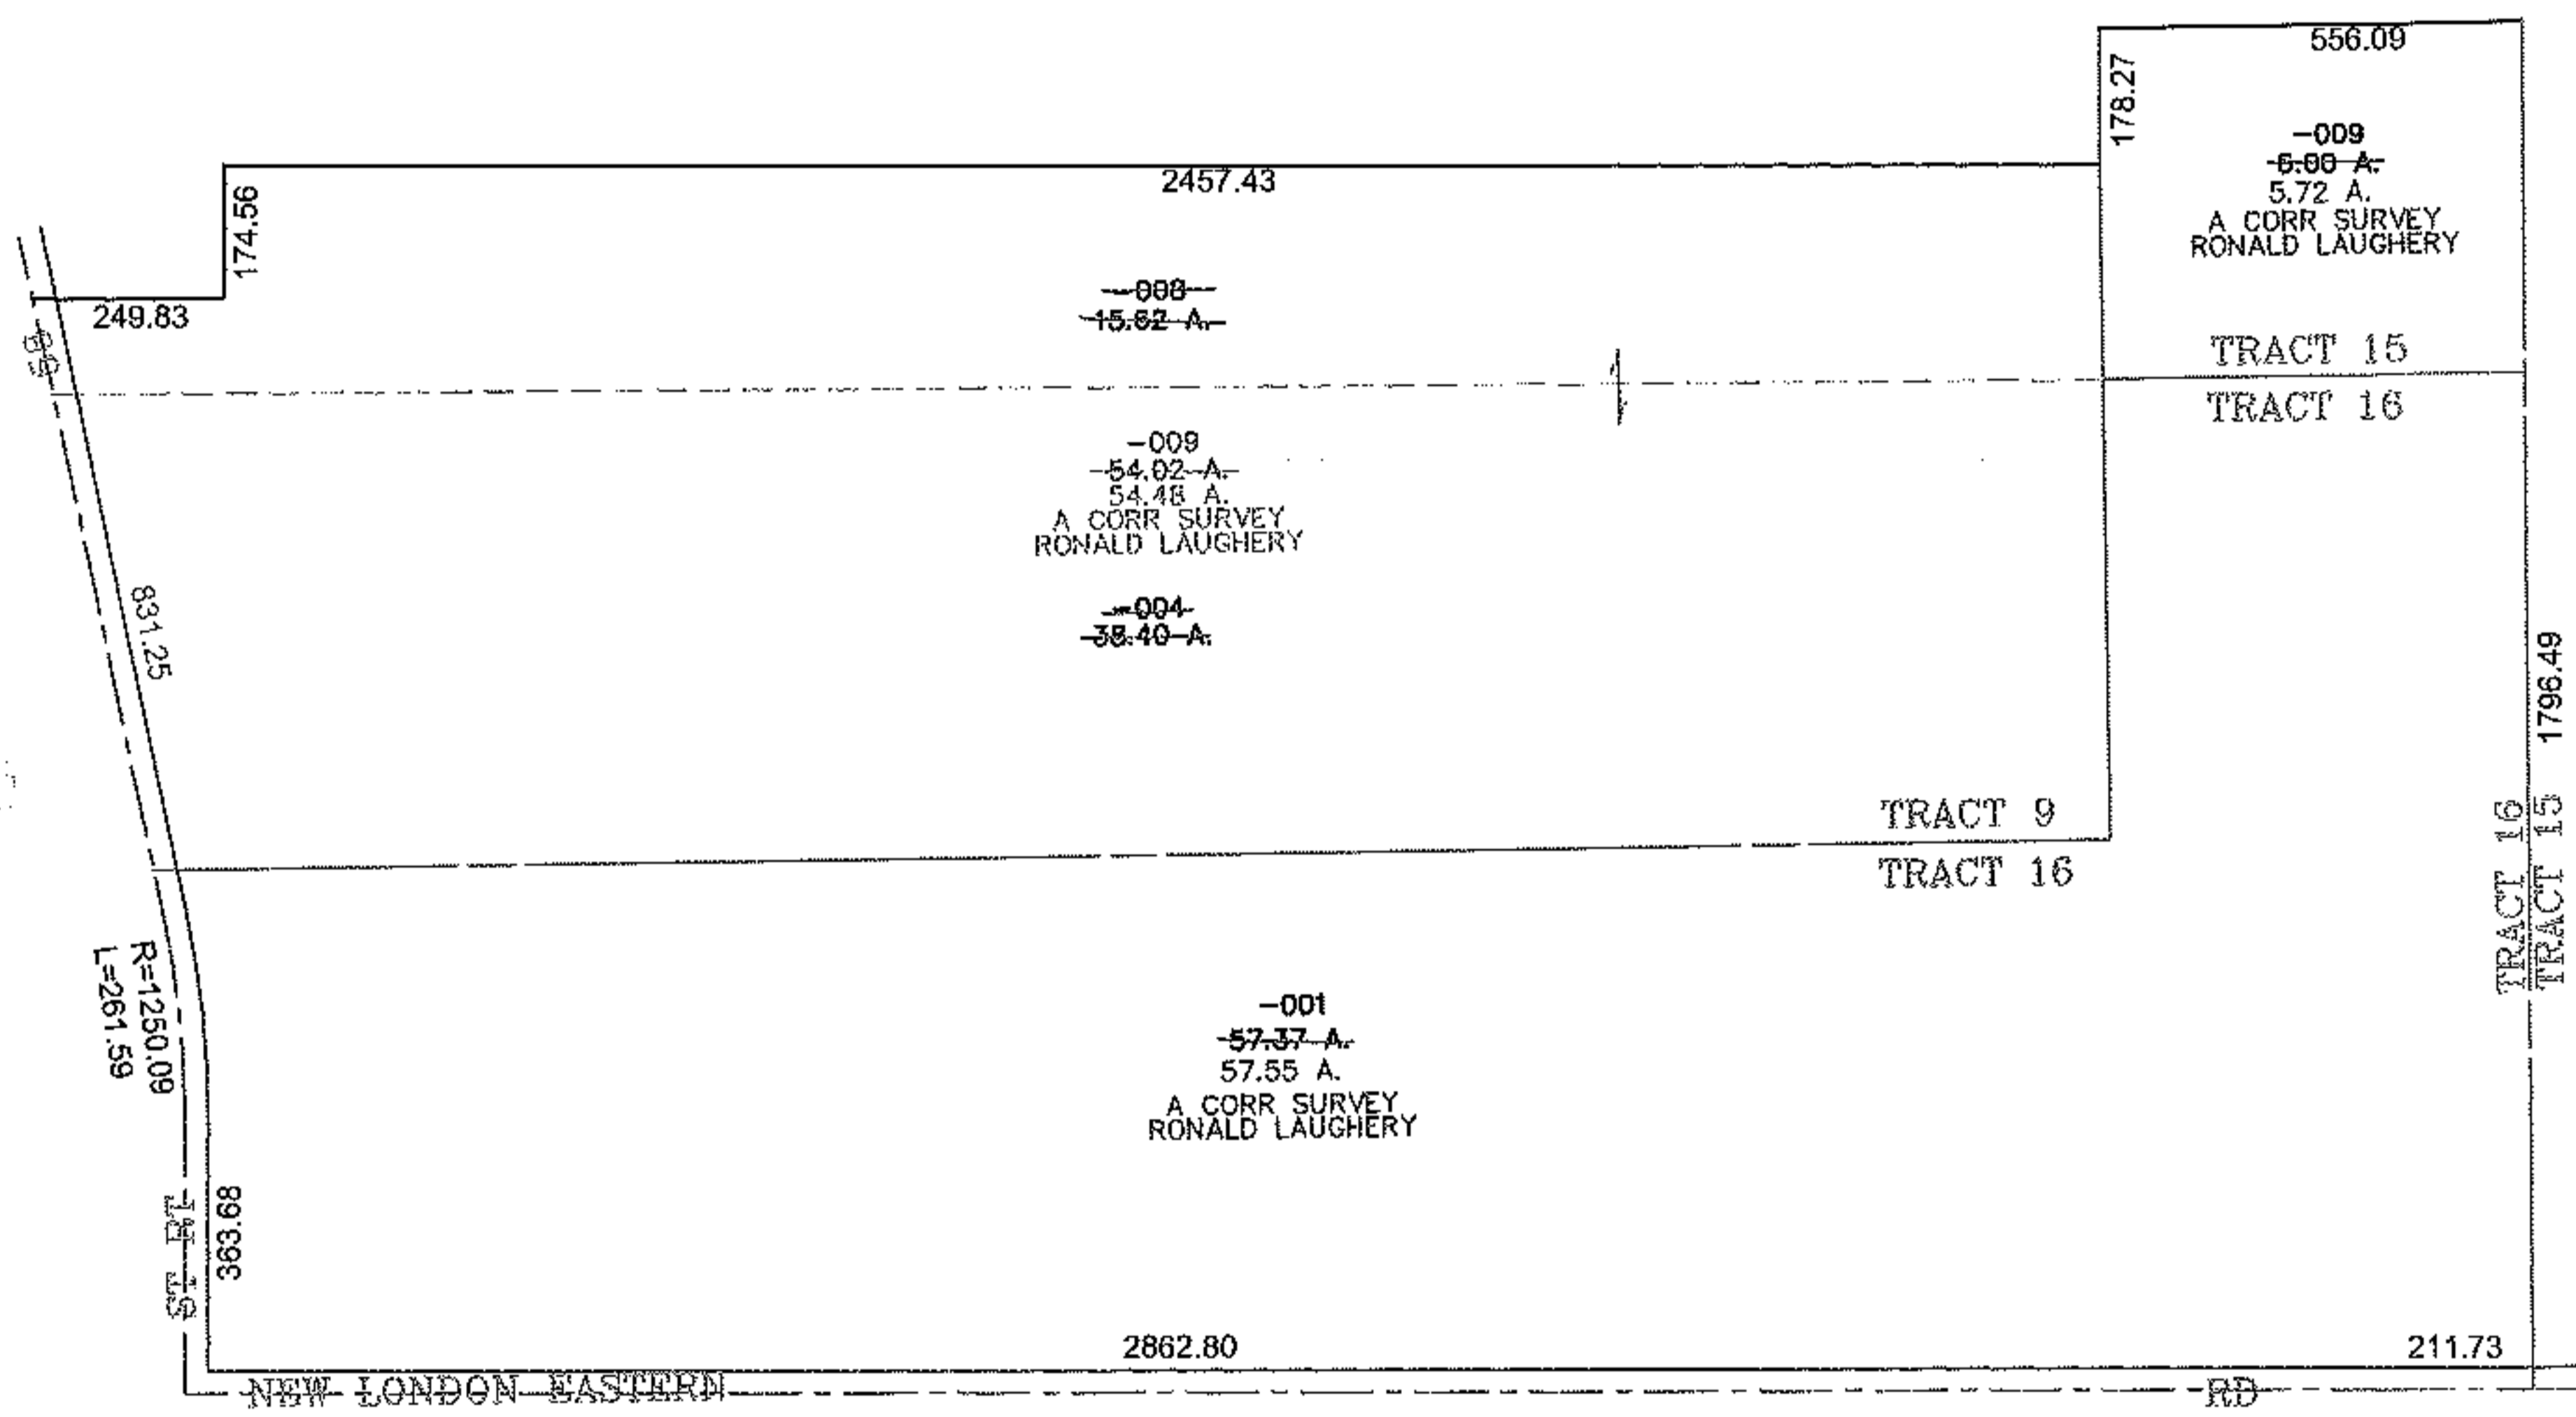

SPLITS/DEEDS PROCESSED

LORAIN COUNTY TAX MAP DEPARTMENT
 226 MIDDLE AVE. ELYRIA, OHIO

SURVEYED BY: RONALD LAUGHERY
 CLOSURE: 0.00 : 10.000
 MAP PAGE(S): 21-G
 APPROVED BY: JAH DATE: 4-30-2012
 SCALE: 1" = 500 PRIOR INSTRUMENT: 20060142711