
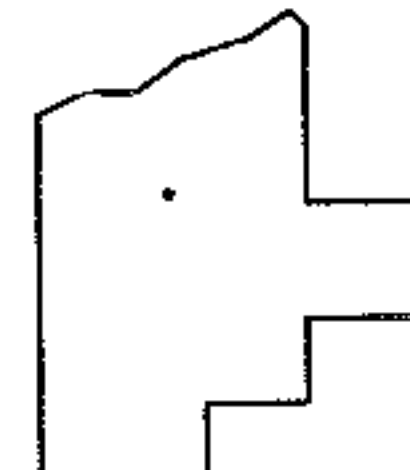


PARENT PARCEL: 21-01-015-000-007 21-01-014-000-001 21-01-016-000-009
 CHILD PARCEL: 21-01-013-000-002 NO CHILD PARCELS STRAIGHT TRANSFERS
 STARTING POINT: CENTERLINE OF NEW LONDON EASTERN RD & TRACT 1 O.L. 15

12-03019-2

MAP 2 OF 3

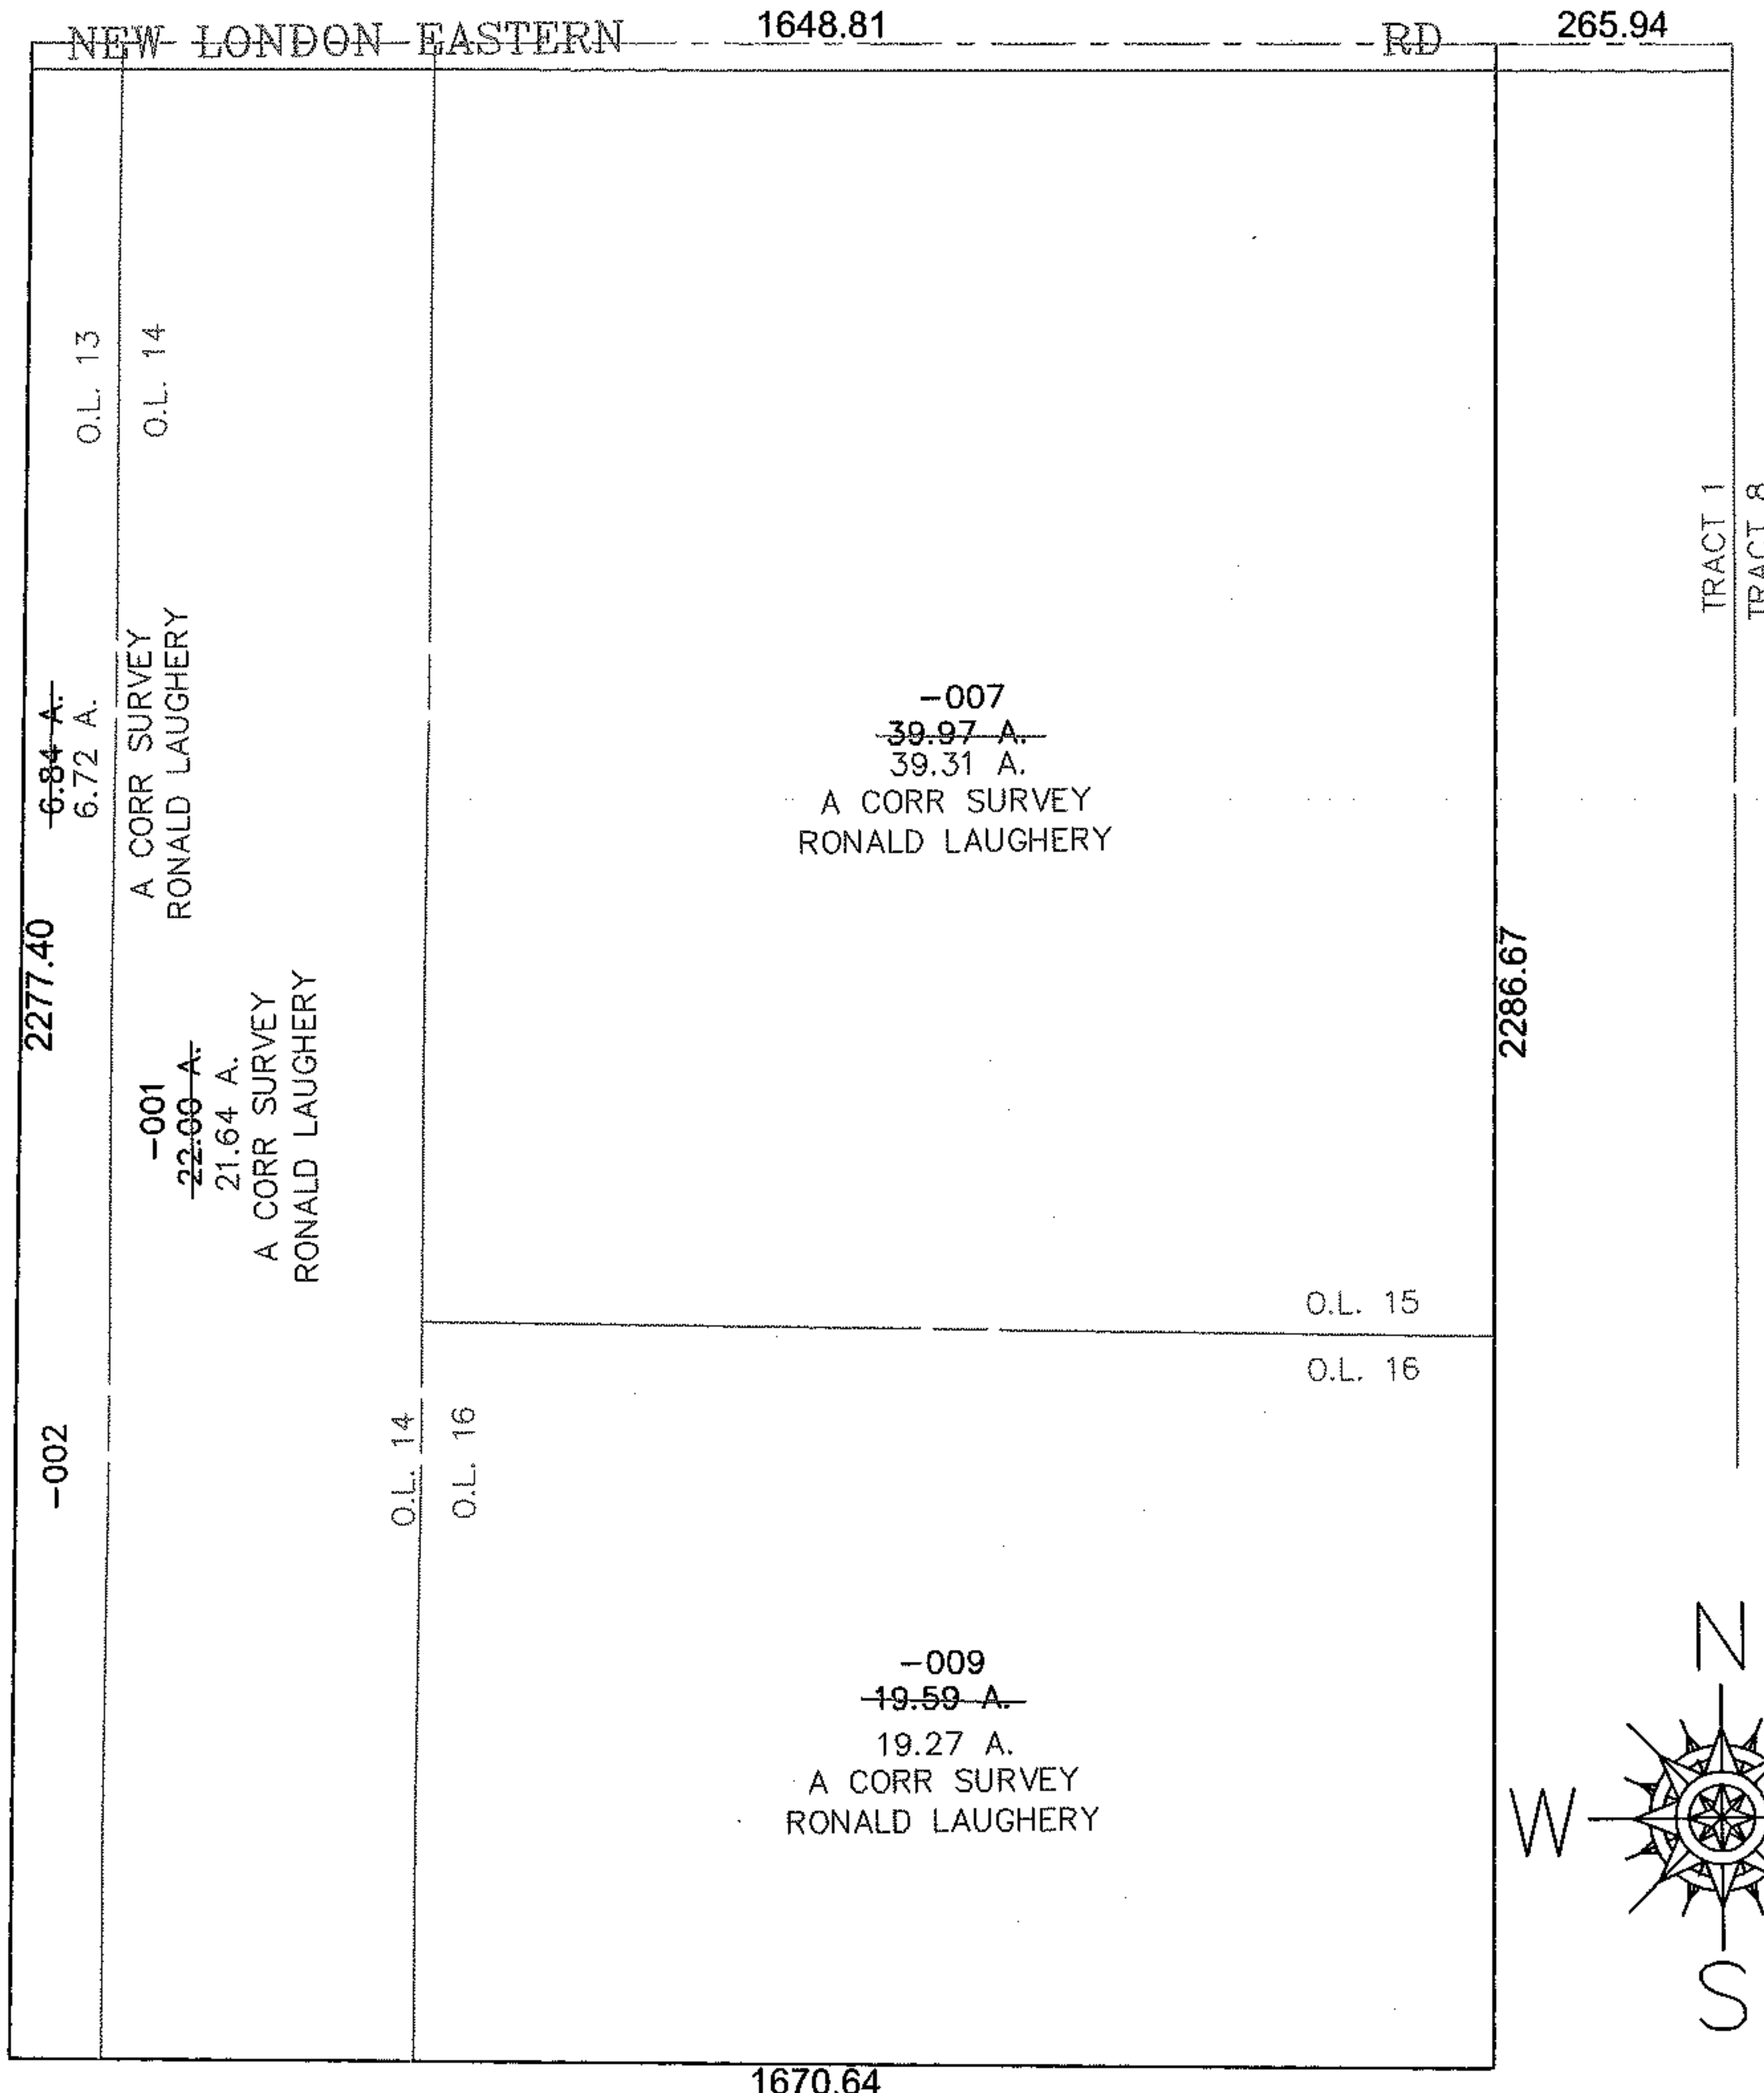

SPLITS/DEEDS PROCESSED
 LORAIN COUNTY TAX MAP DEPARTMENT
 226 MIDDLE AVE. ELYRIA, OHIO

SURVEYED BY: RONALD LAUGHERY
 CLOSURE: 0.01 : 10,000
 MAP PAGE(S): 21-G
 APPROVED BY: JAH DATE: 4/30/2012
 SCALE: 1" = 300 PRIOR INSTRUMENT: 20060142711