


PARENT PARCEL: 21-02-008-000-009 21-02-002-000-001 21-02-001-000-001 ****

CHILD PARCEL: ADD TO DUP 21-09-000-000-010, 21-16-000-000-002


STARTING POINT: SOUTHEASTERLY CORNER OF O.L. 1 & TRACT 2

***21-02-009-000-011

12-03019-3

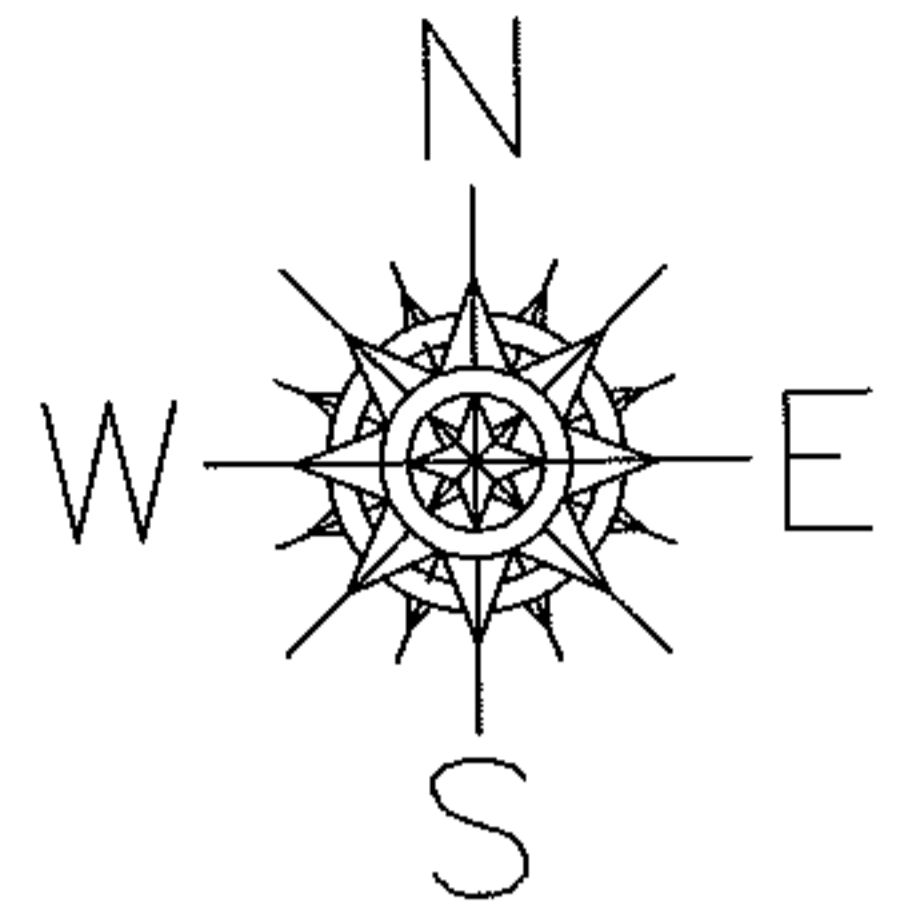

MAP 3 OF 3

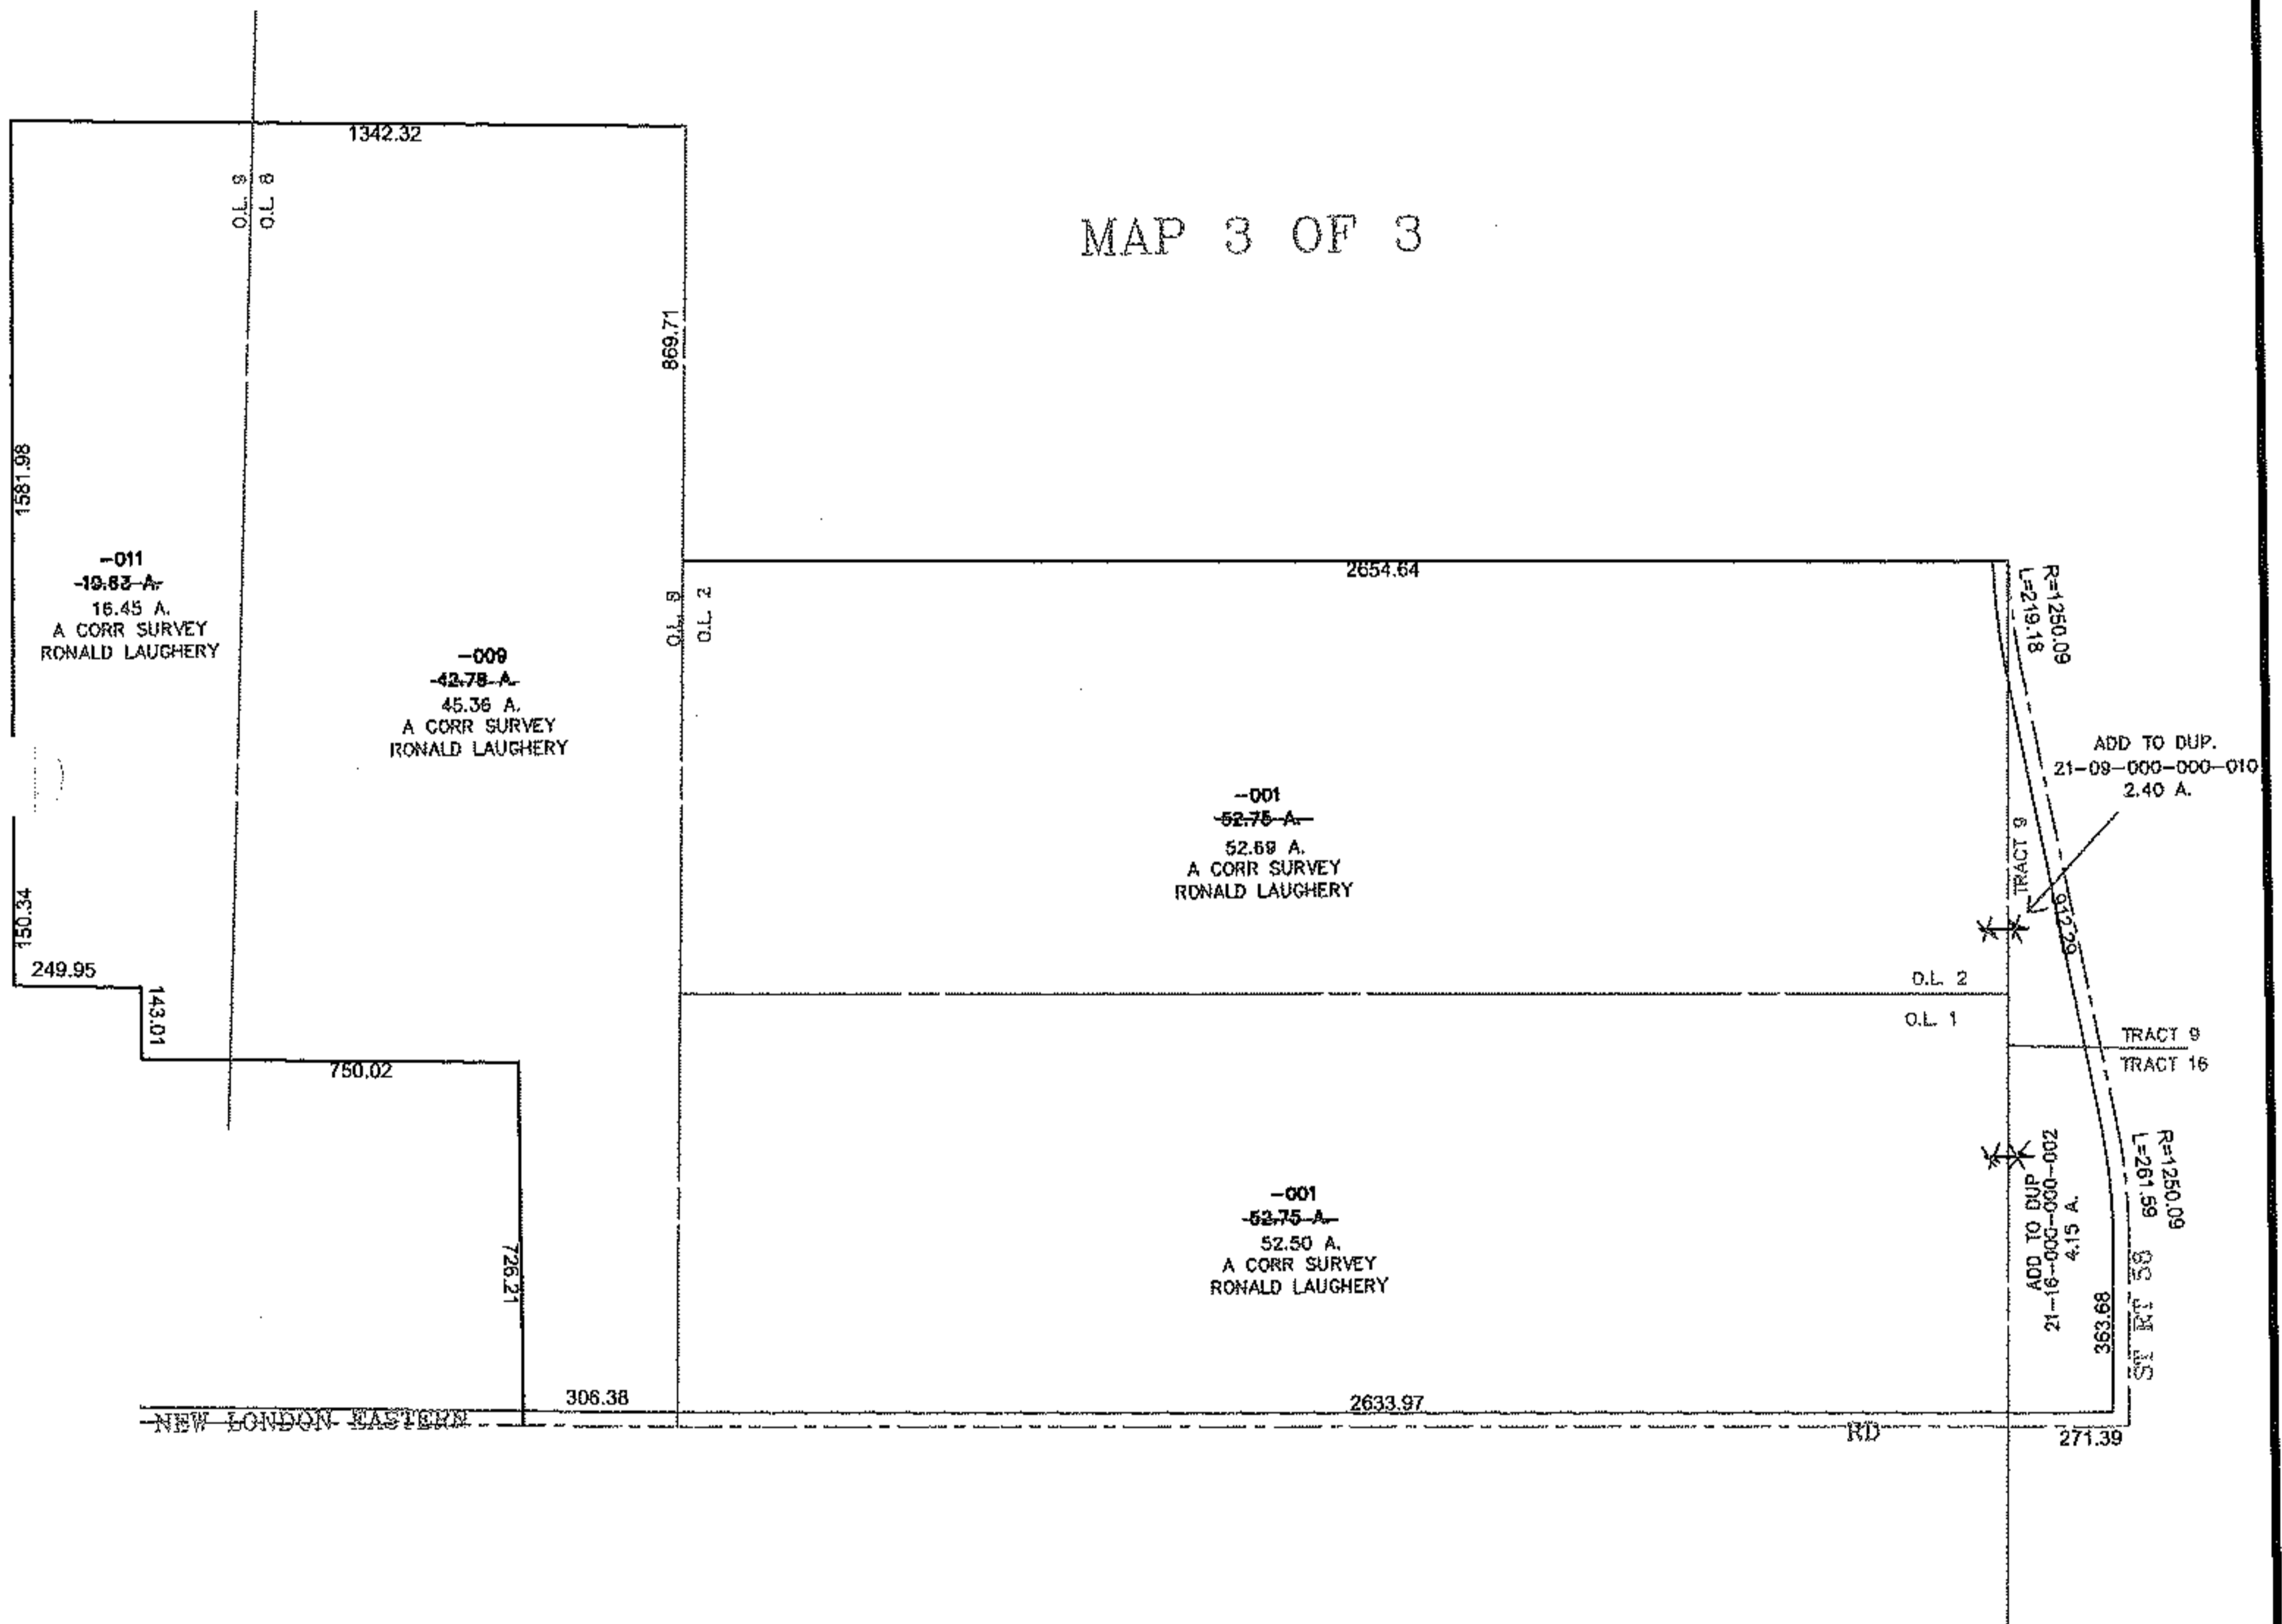

SPLITS/DEEDS PROCESSED

LORAIN COUNTY TAX MAP DEPARTMENT
226 MIDDLE AVE. ELYRIA, OHIO

SURVEYED BY: RONALD LAUGHERY

CLOSURE: 0.00 : 10.000

MAP PAGE(S): 21-G

APPROVED BY: JAH DATE: 4-30-2012

SCALE: 1" = 600 PRIOR INSTRUMENT: 20060142711