
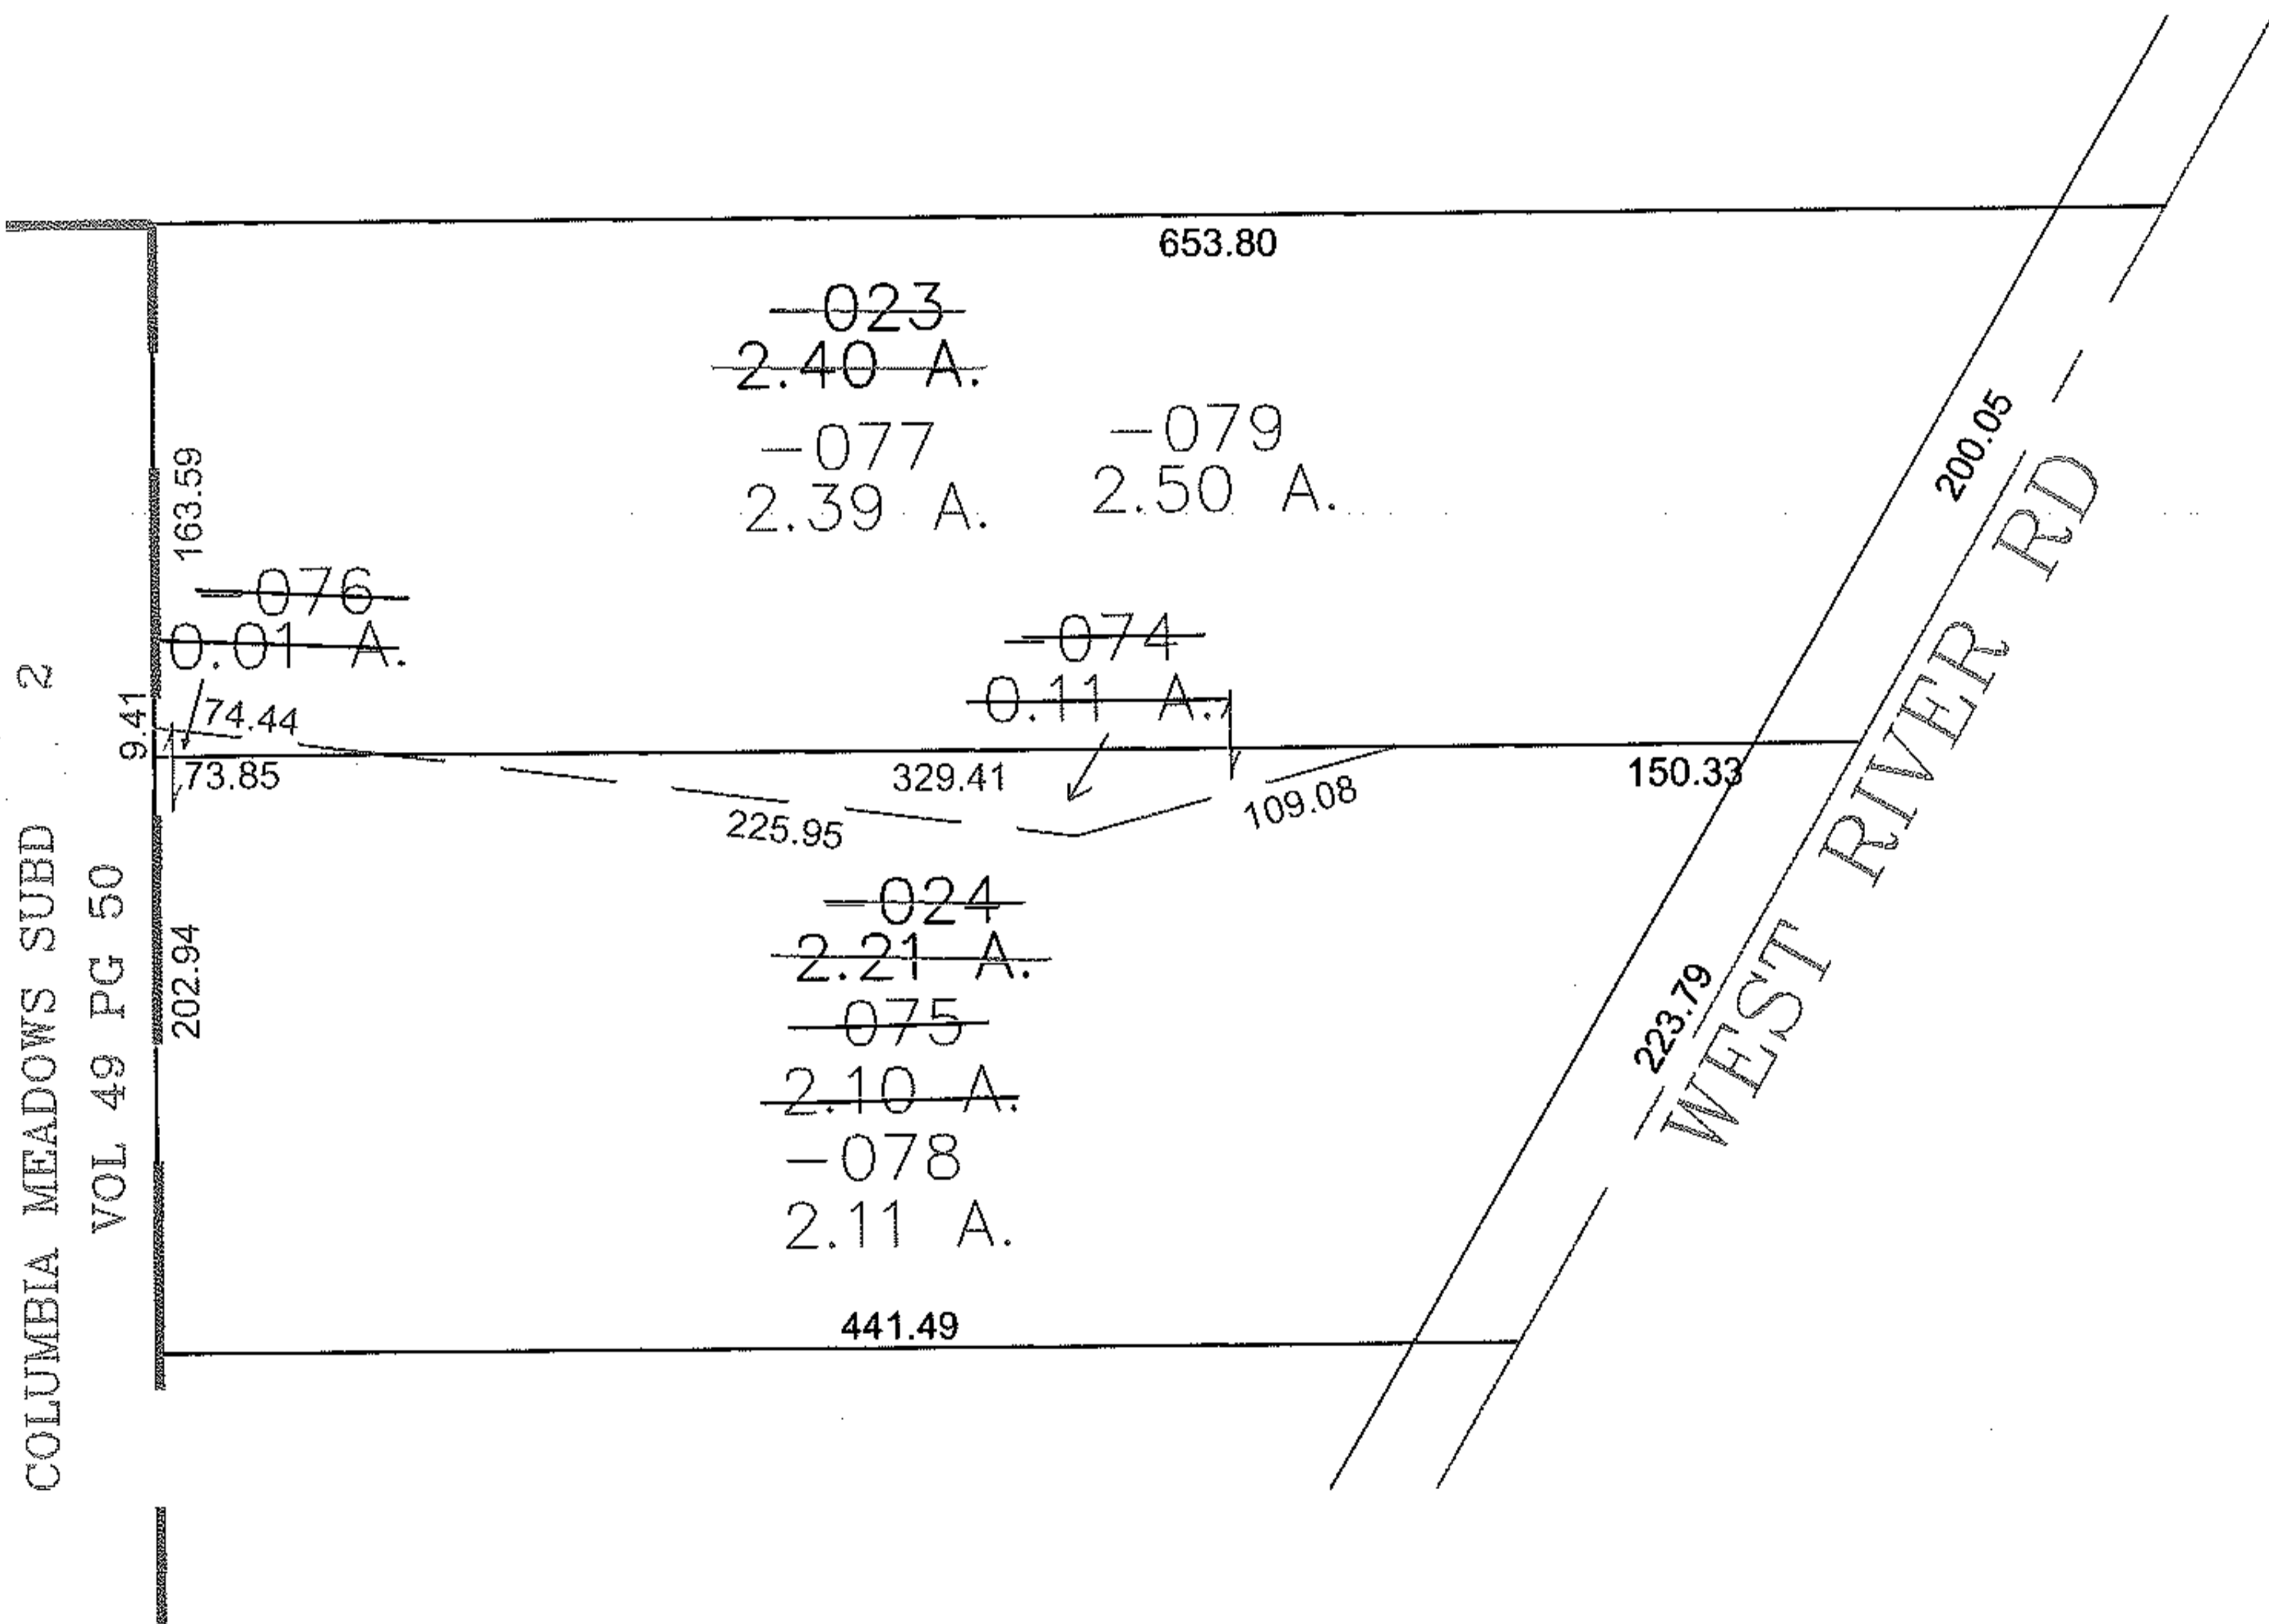


PARENT PARCEL: 12-00-043-000-024, -023

CHILD PARCEL: 12-00-043-000-074 THRU -079

STARTING POINT: NE CORNER OF BLOCK "A" IN COLUMBIA MEADOWS SUBD NO 2

12-03021

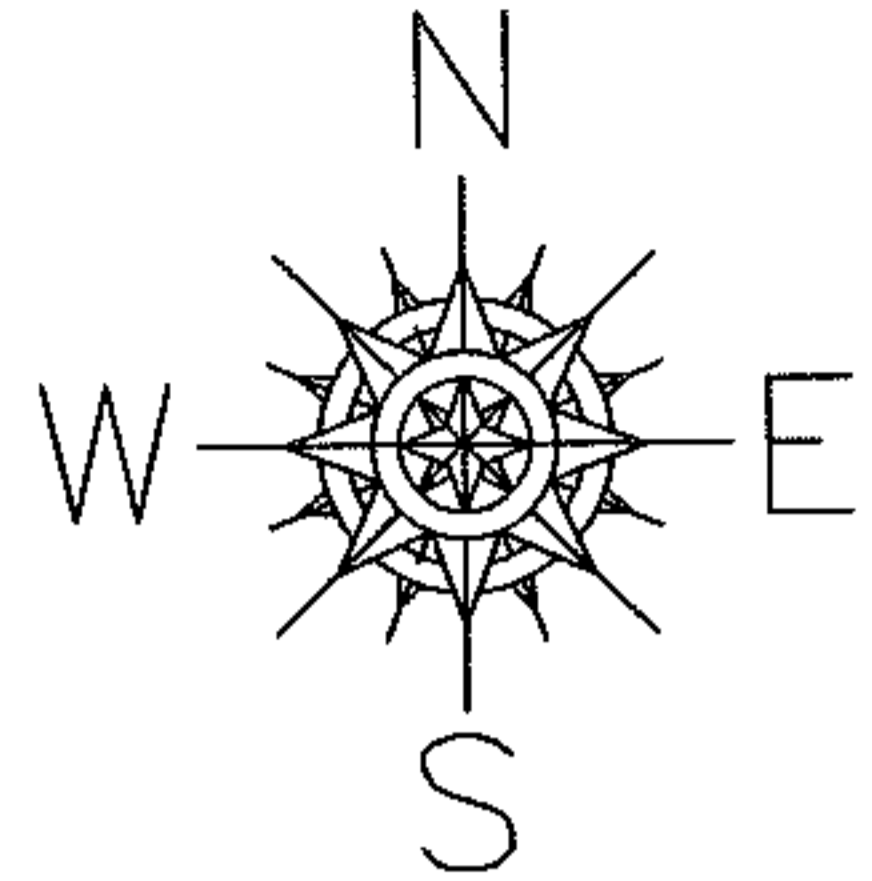

**SPLITS/DEEDS PROCESSED**

LORAIN COUNTY TAX MAP DEPARTMENT  
226 MIDDLE AVE. ELYRIA, OHIO

SURVEYED BY: RICHARD FREDRICKSON  
CLOSURE: 0.00 : 10.000  
MAP PAGE(S): 12-00-043-B  
APPROVED BY: JAH DATE: 5/1/2012  
SCALE: 1" = 100' PRIOR INSTRUMENT: OR 651/304