


PARENT PARCEL: 11-00-003-000-003

CHILD PARCEL: 11-00-003-000-044, -045

12-03022

STARTING POINT: CENTERLINE OF CAPEL RD & COWLEY RD

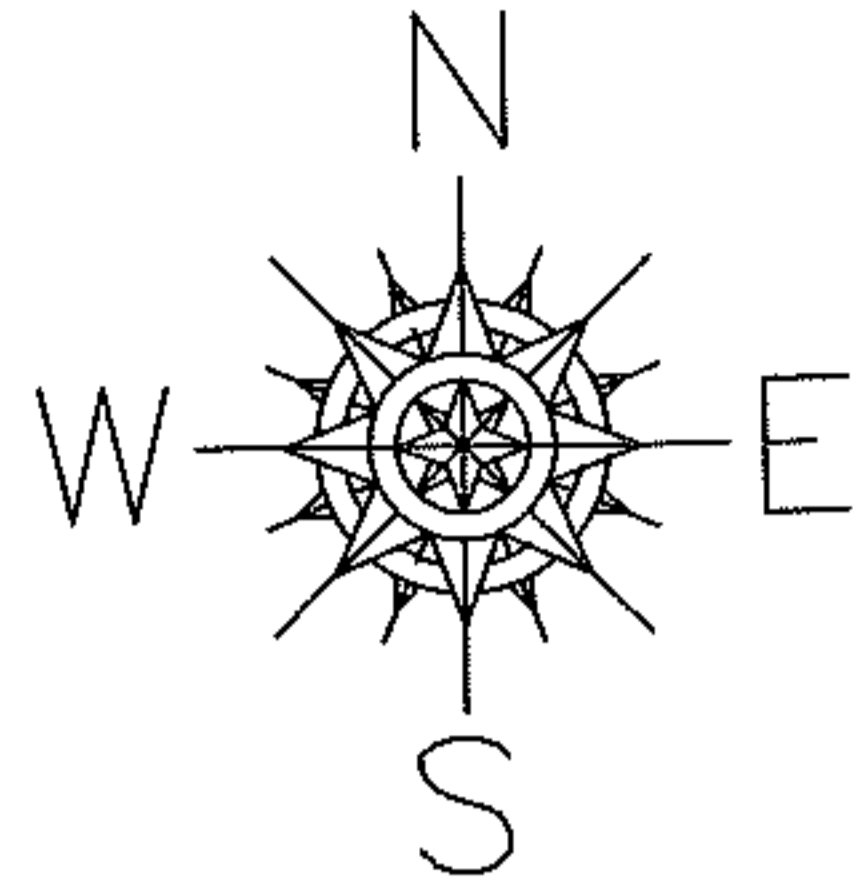

CAPEL RD

RD

1431.79

-002  
2.84 A.

250.00

~~-003~~  
~~55.16 A.~~  
~~-045~~  
53.05 A.

277.00

259.81

COWLEY

154.00

-044  
2.11 A.


220.00

530.00

250.00

O.L. 3

O.L. 2

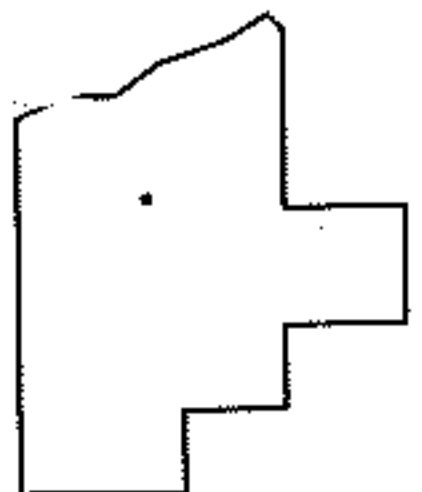

**SPLITS/DEEDS PROCESSED**

LORAIN COUNTY TAX MAP DEPARTMENT  
226 MIDDLE AVE. ELYRIA, OHIO

SURVEYED BY: RICHARD CARLSON

CLOSURE: 0.00 : 10.000

MAP PAGE(S): 11-H

APPROVED BY: JAH DATE: 5-2-2012

SCALE: 1" = 200 PRIOR INSTRUMENT: 19890068758