
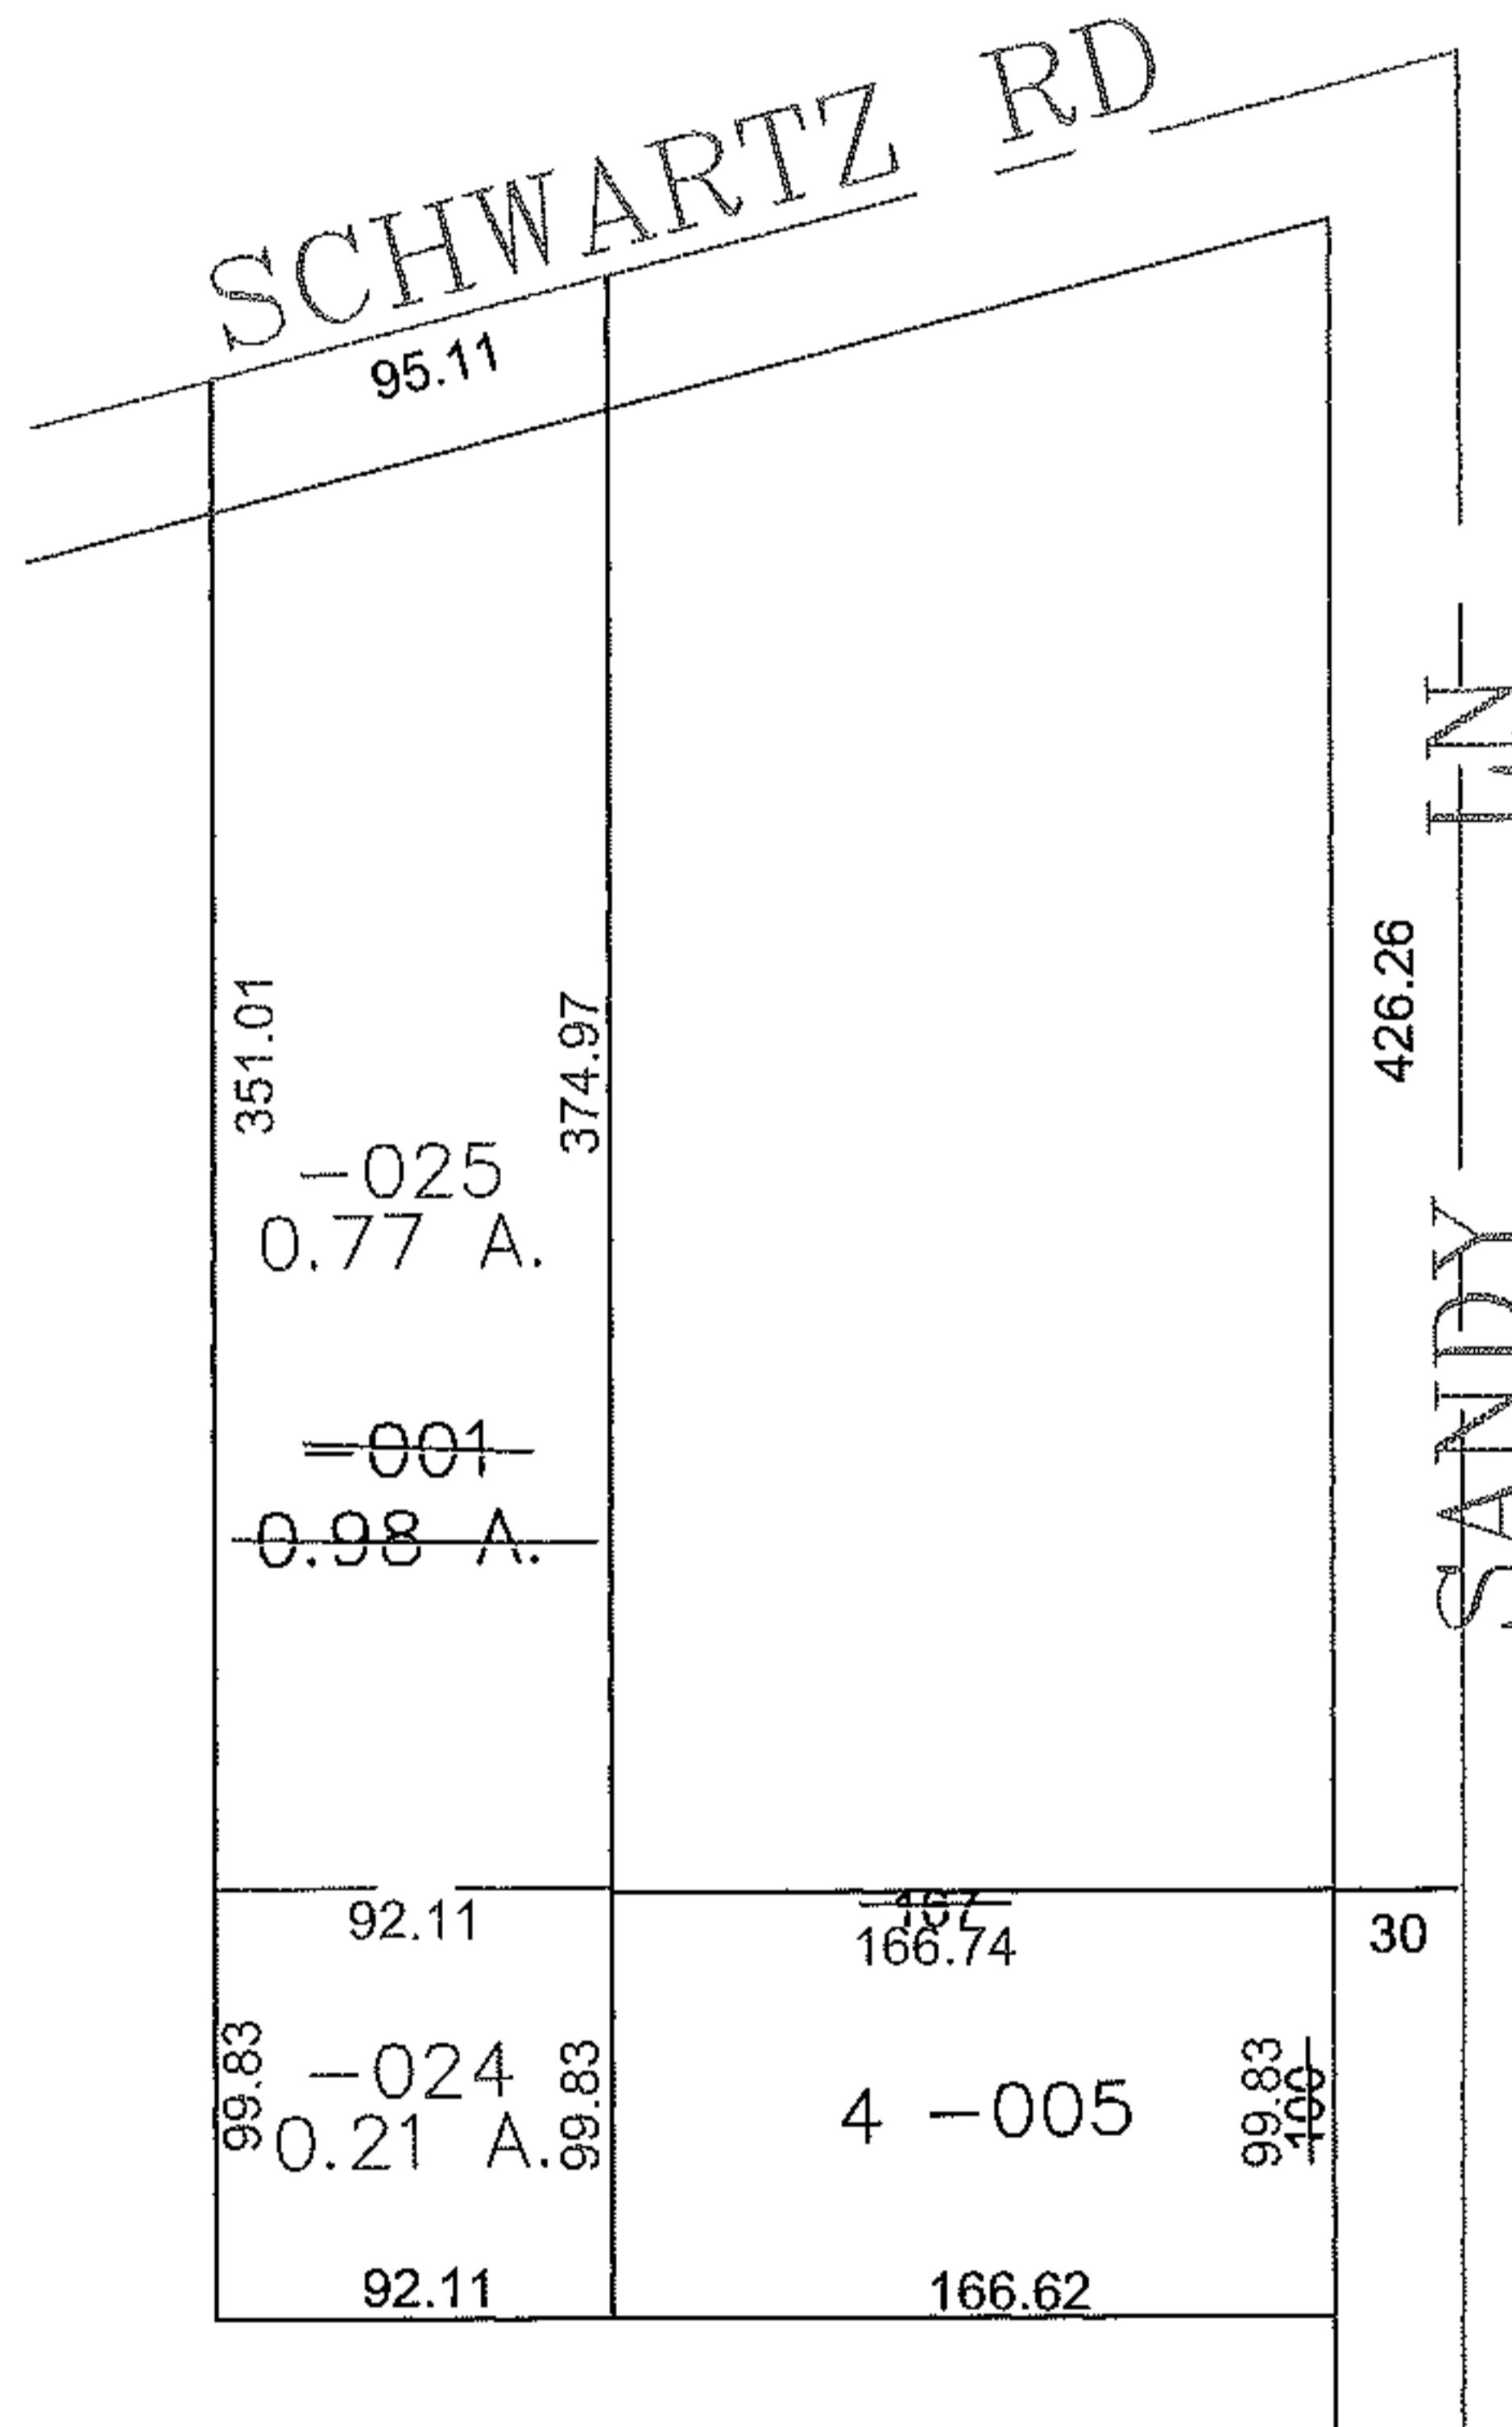


PARENT PARCEL: 04-00-023-109-001, -005

CHILD PARCEL: 04-00-023-109-024, -025

STARTING POINT: CENTERLINE OF SCHWARTZ RD & SANDY LN

12-03027

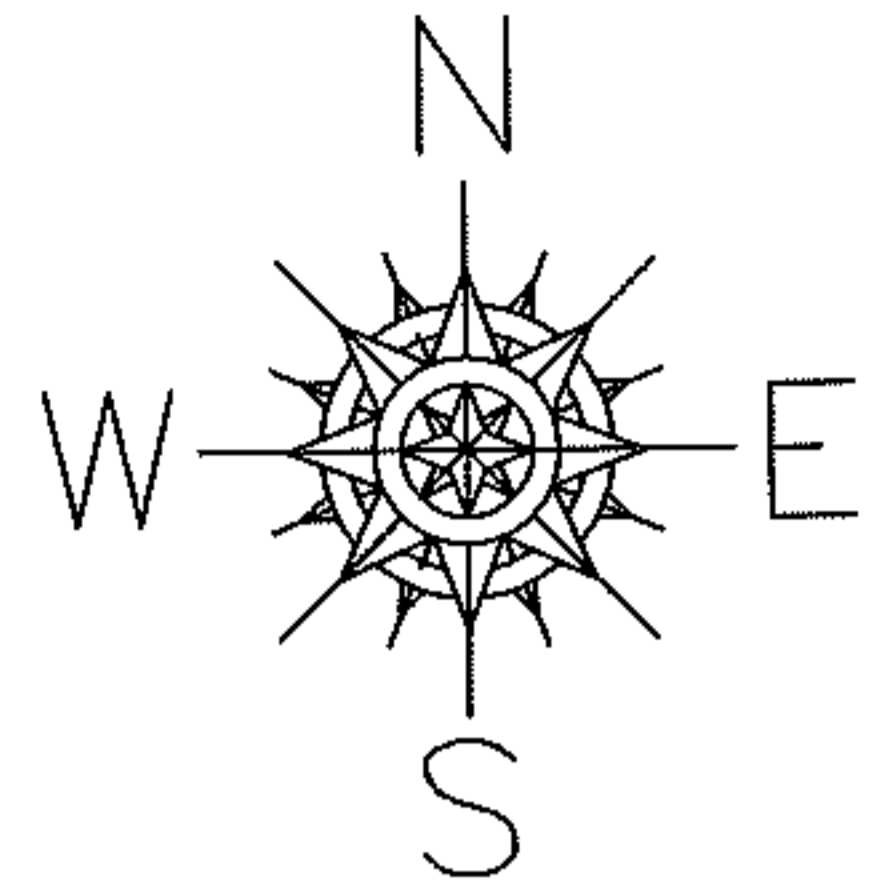

SPLITS/DEEDS PROCESSED

LORAIN COUNTY TAX MAP DEPARTMENT
226 MIDDLE AVE. ELYRIA, OHIO

SURVEYED BY: MICHAEL SPELLACY

CLOSURE: 0.00 : 10,000

MAP PAGE(S): 04-00-023-H

APPROVED BY: JAH DATE: 5-14-2012

SCALE: 1" = 100 PRIOR INSTRUMENT: DV 1400/949