


PARENT PARCEL: 07-00-039-000-071, -026, -027

CHILD PARCEL: 07-00-039-000-089

STARTING POINT: CENTERLINE OF CENTER RIDGE RD & RACE RD

12-03028

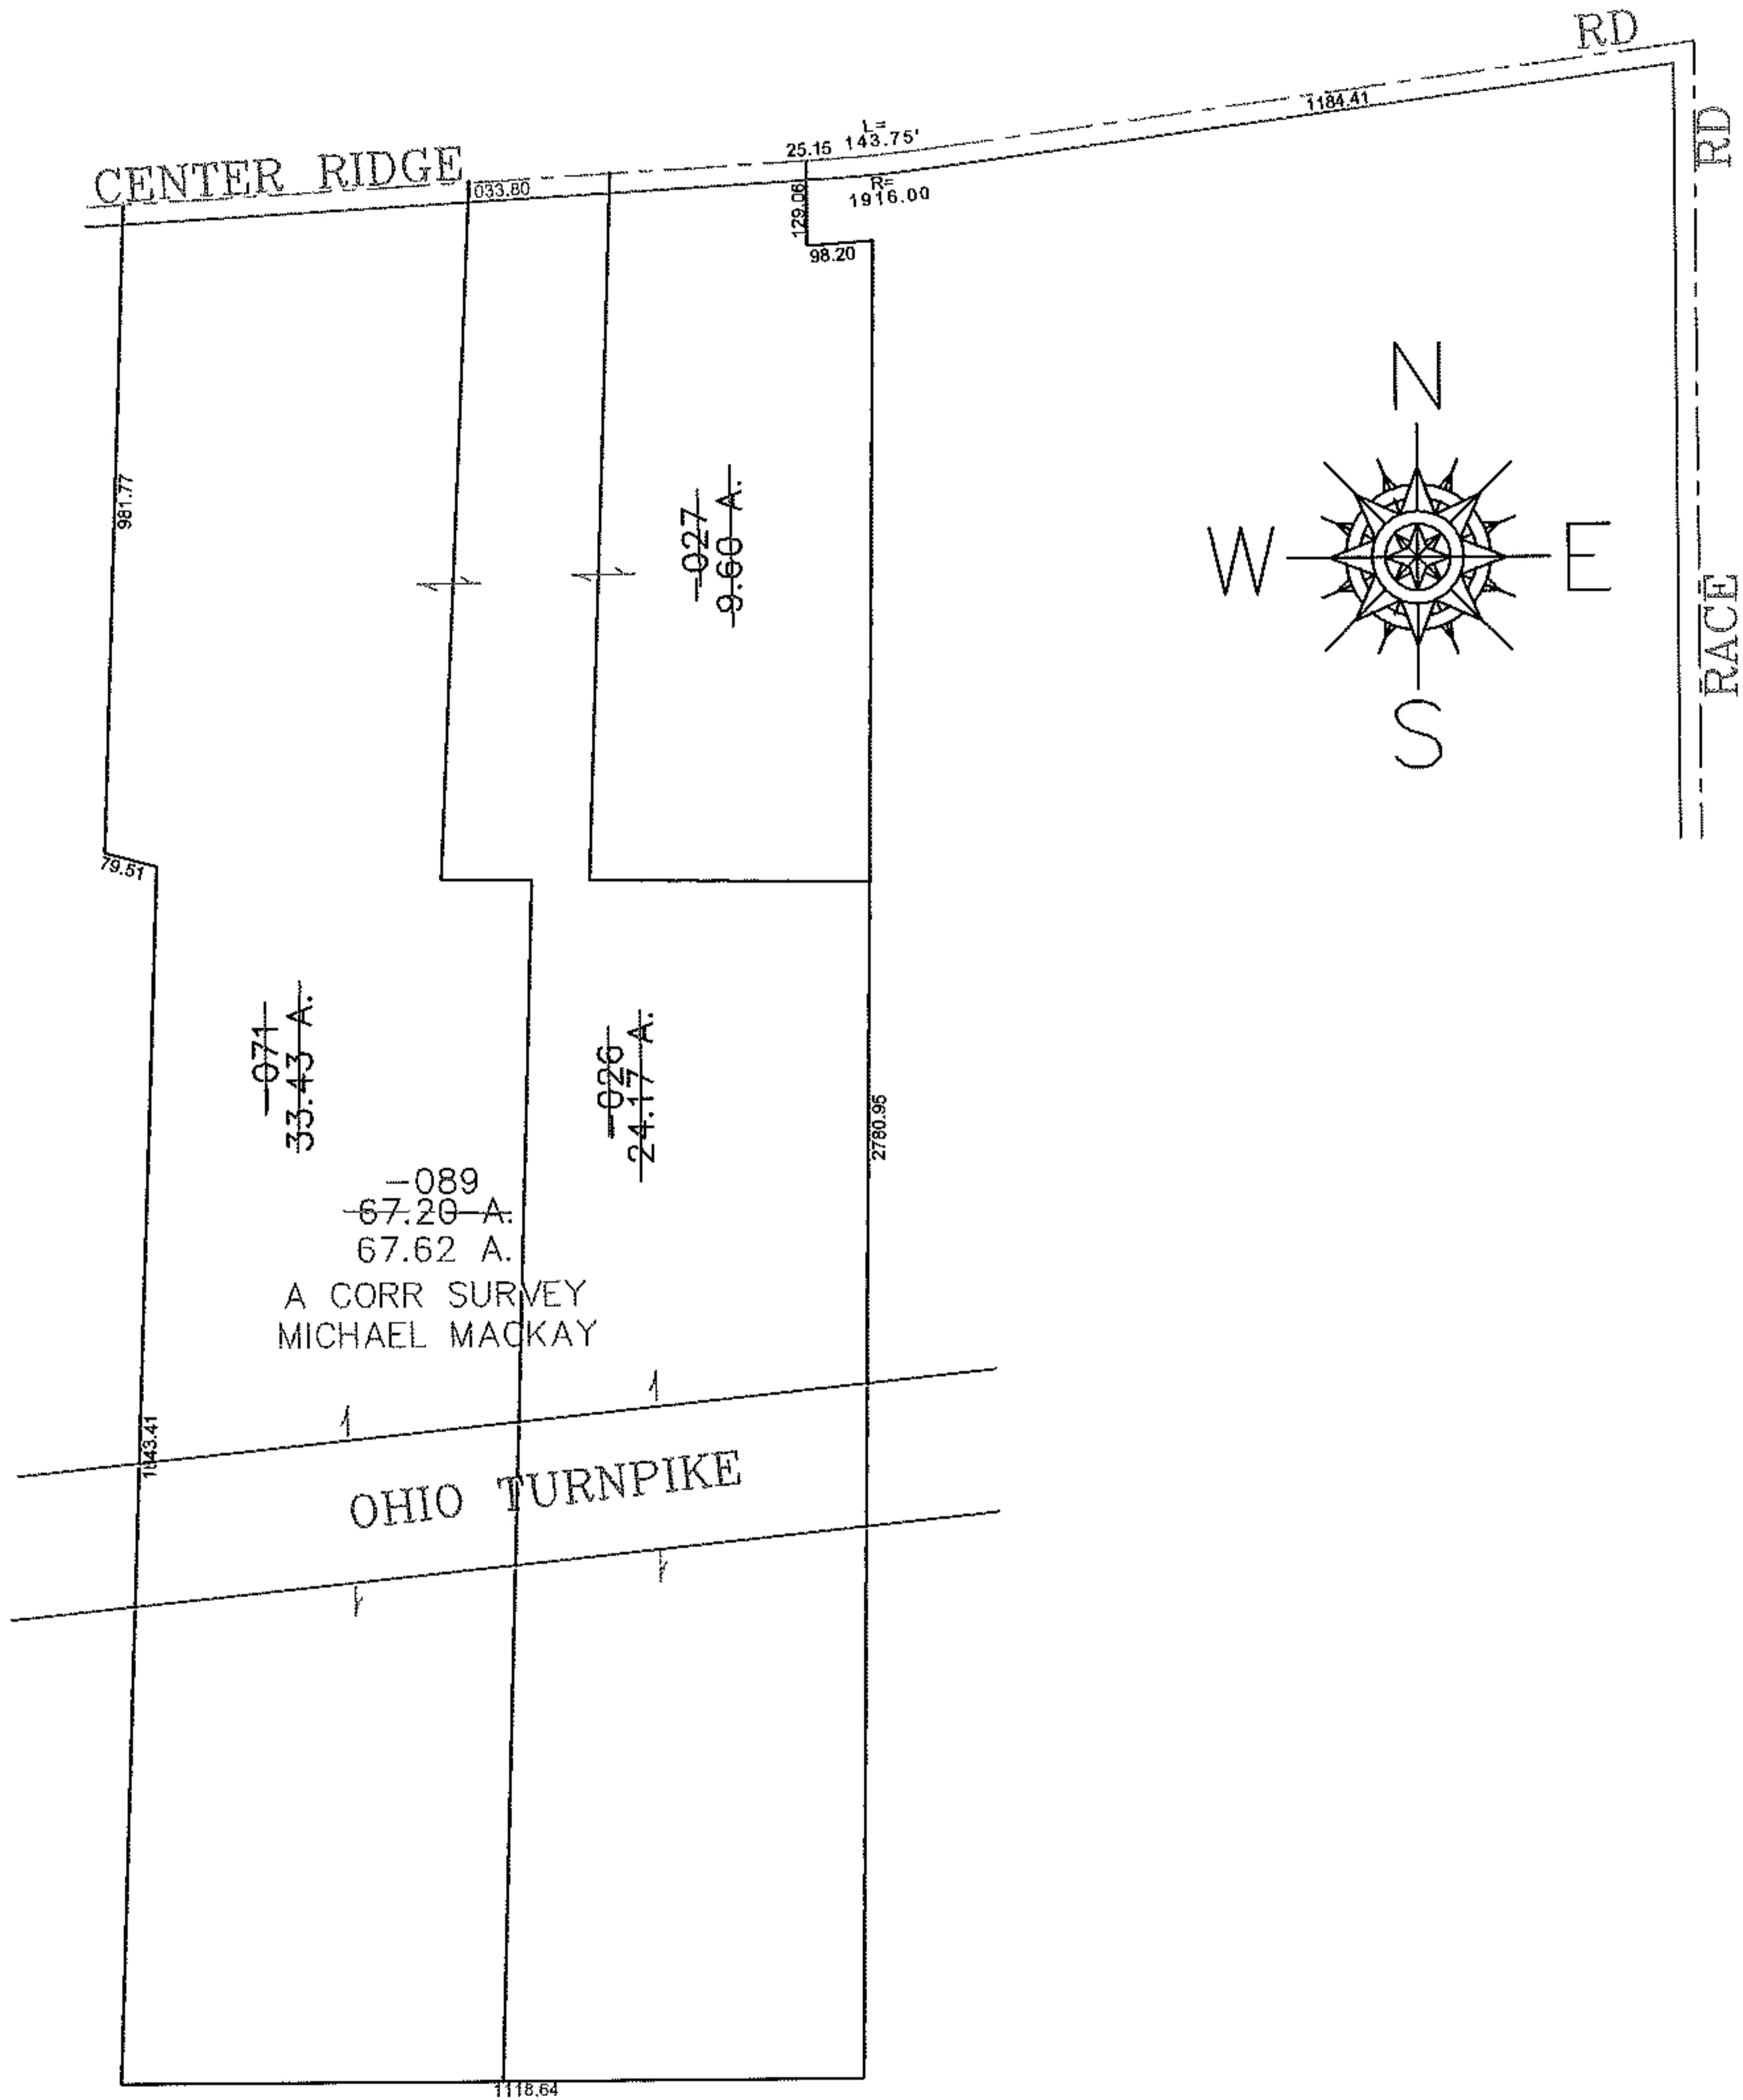

SPLITS/DEEDS PROCESSED

LORAIN COUNTY TAX MAP DEPARTMENT
226 MIDDLE AVE. ELYRIA, OHIO

SURVEYED BY: MICHAEL MACKAY

CLOSURE: 0.00 : 10.000

MAP PAGE(S): 7-E

APPROVED BY: JAH DATE: 5/18/2012

SCALE: 1" = 400' PRIOR INSTRUMENT: DV 900/325