
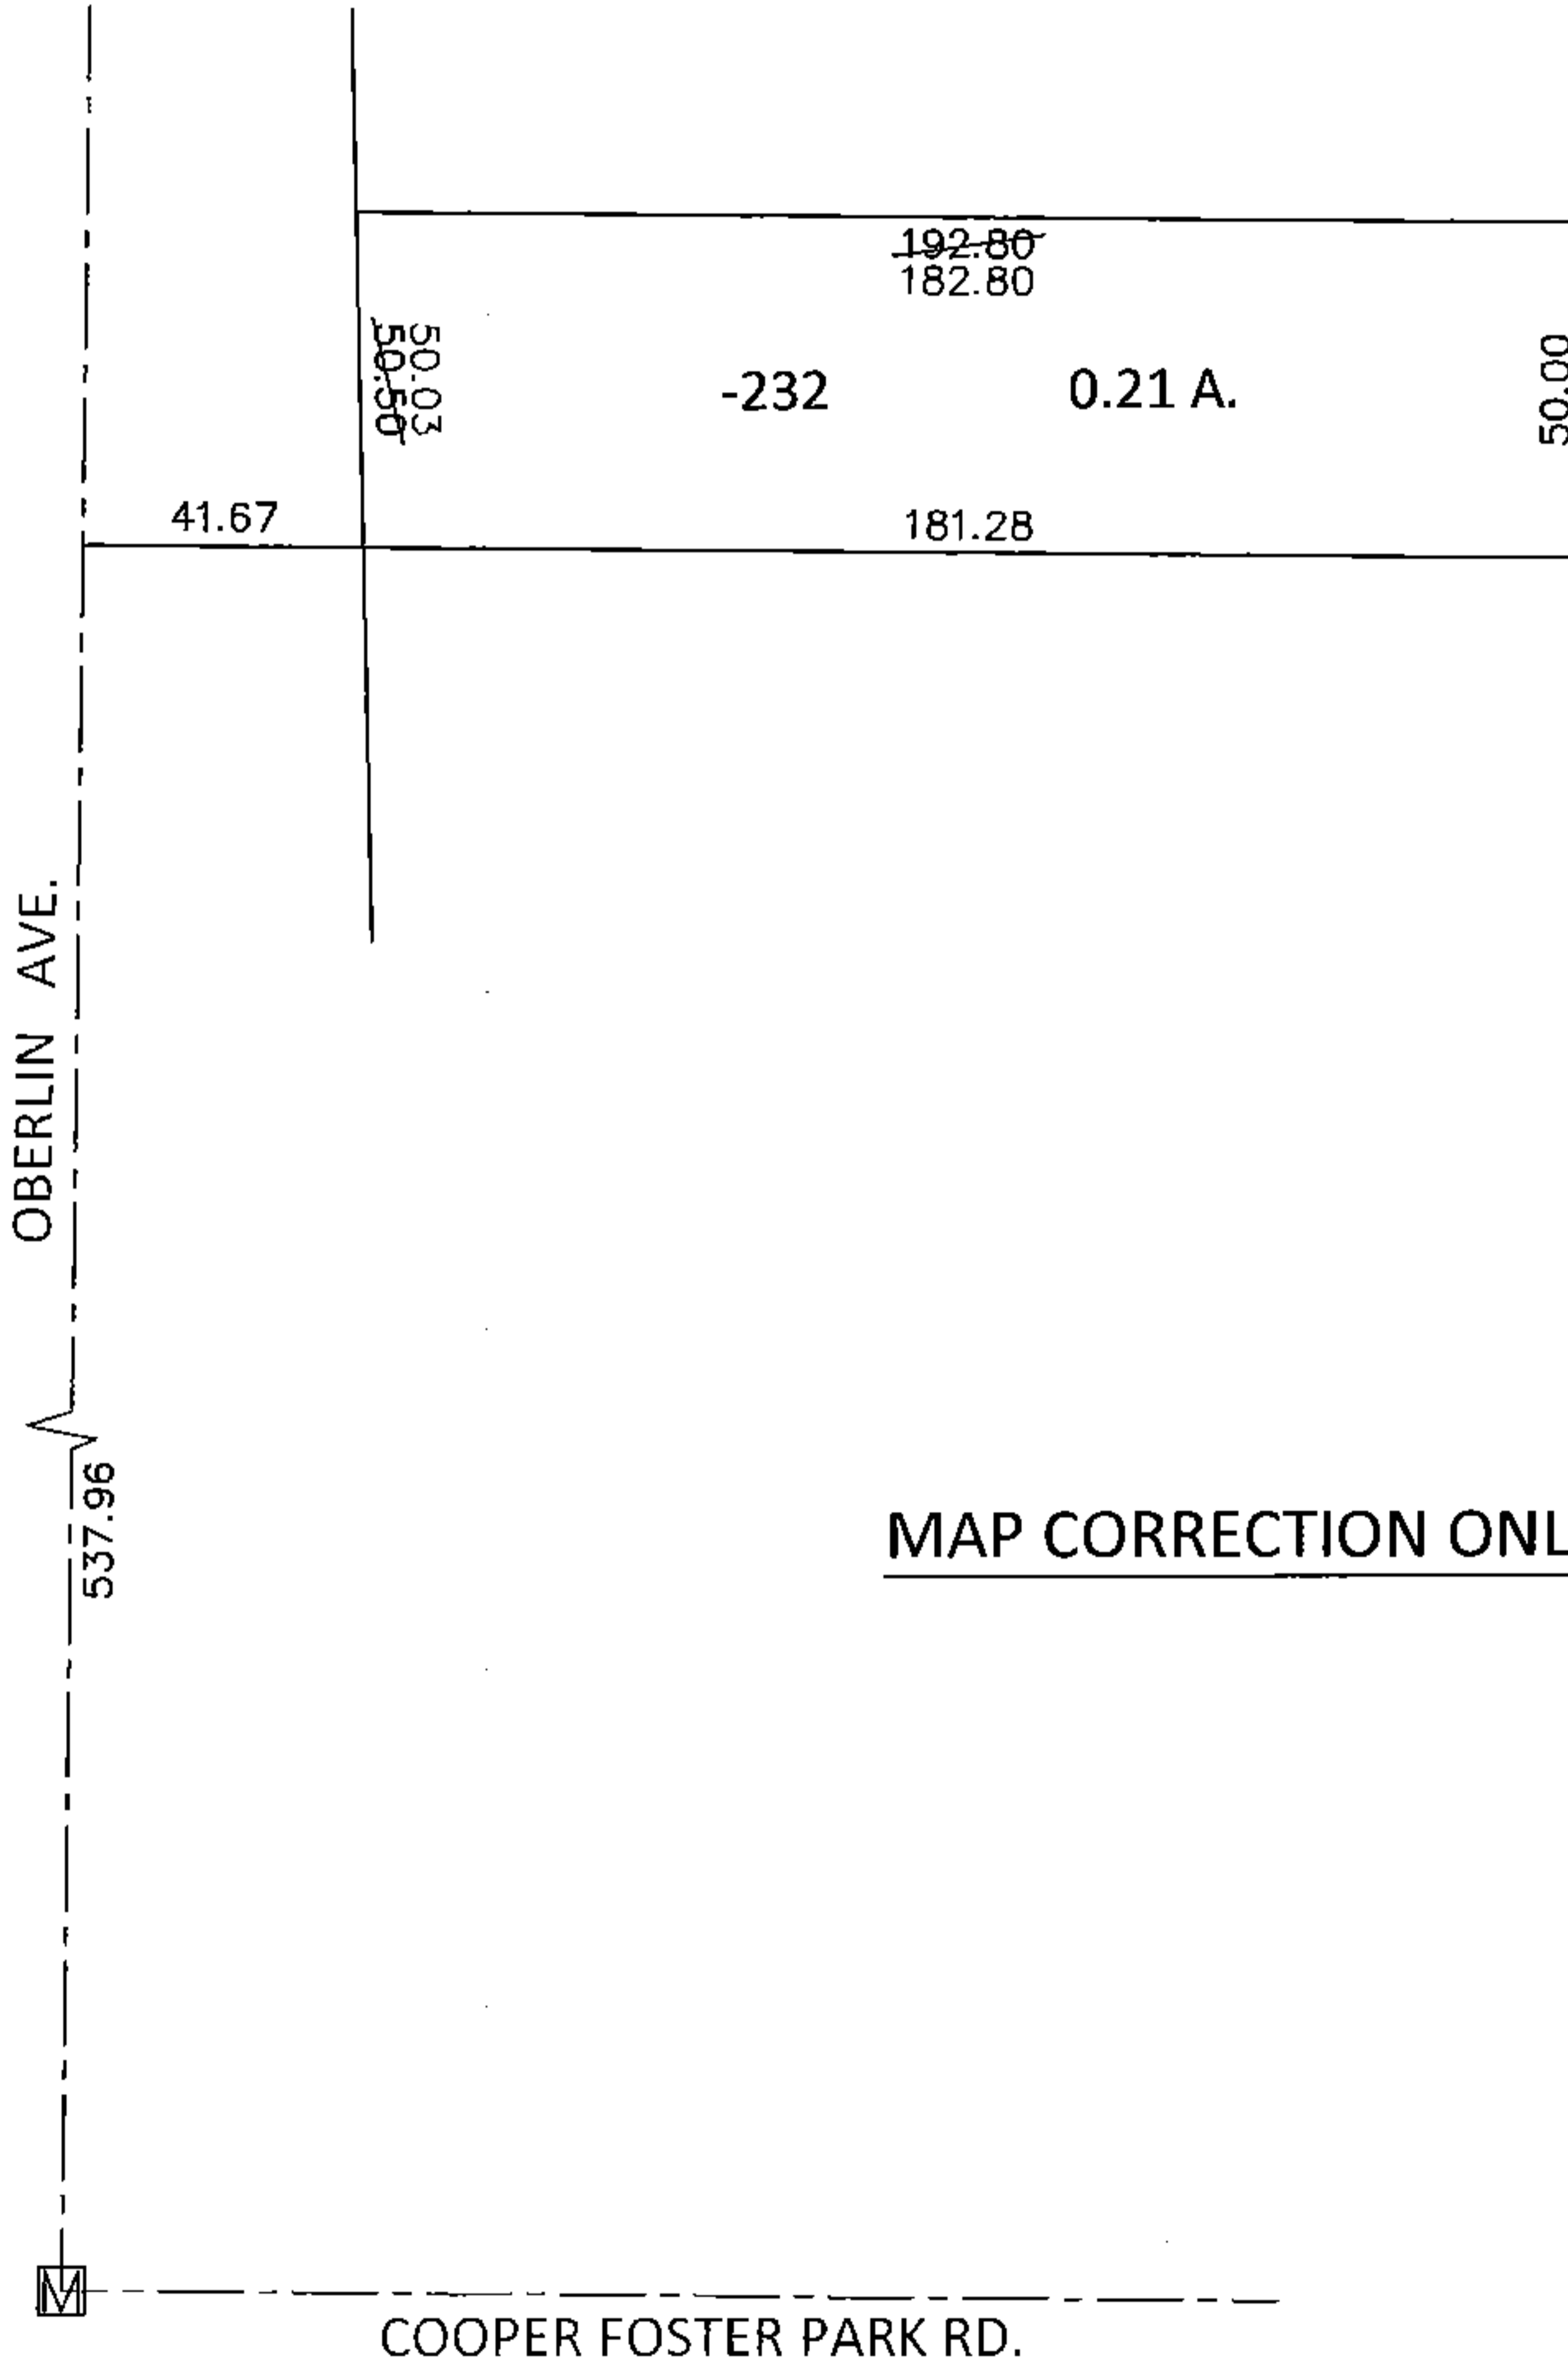


PARENT PARCEL: 02-01-008-101-232


CHILD PARCEL: _____

14-03029-D

STARTING POINT: AT A MON BOX AT THE INTERSECTION OF C/L OF COOPER FOSTER PARK RD. AND C/L OF OBERLIN AVE.

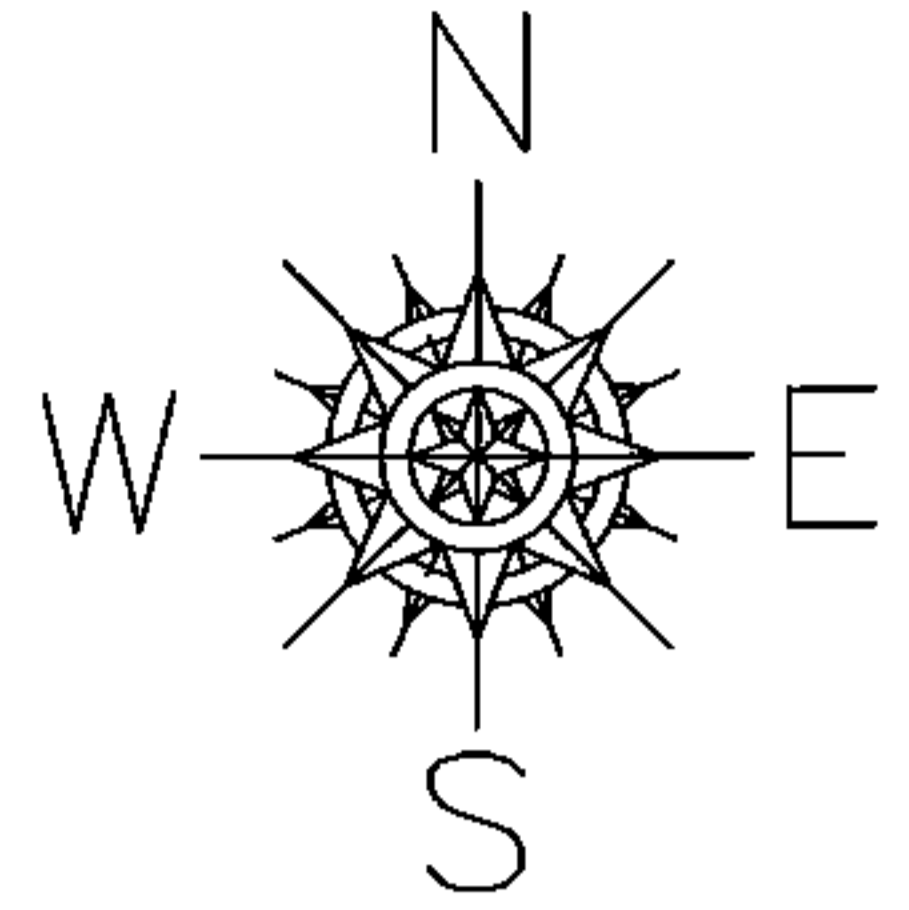

MAP CORRECTION ONLY

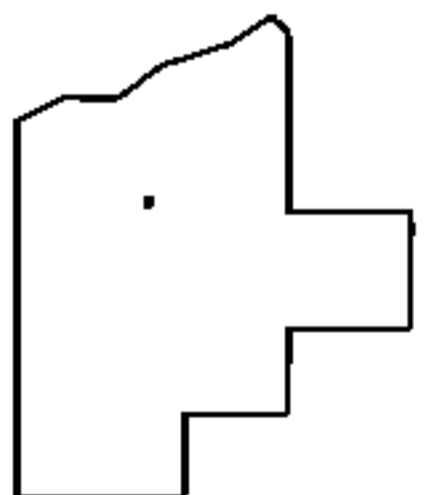

SPLITS/DEEDS PROCESSED

LORAIN COUNTY TAX MAP DEPARTMENT
226 MIDDLE AVE. ELYRIA, OHIO

SURVEYED BY: WILLIAM R. WALLACE

CLOSURE: .01:10,000

MAP PAGE(S): 2-01-008-B

APPROVED BY: RRM DATE: 10-7-14

SCALE: 1"= 50' PRIOR INST.: 20110385638