
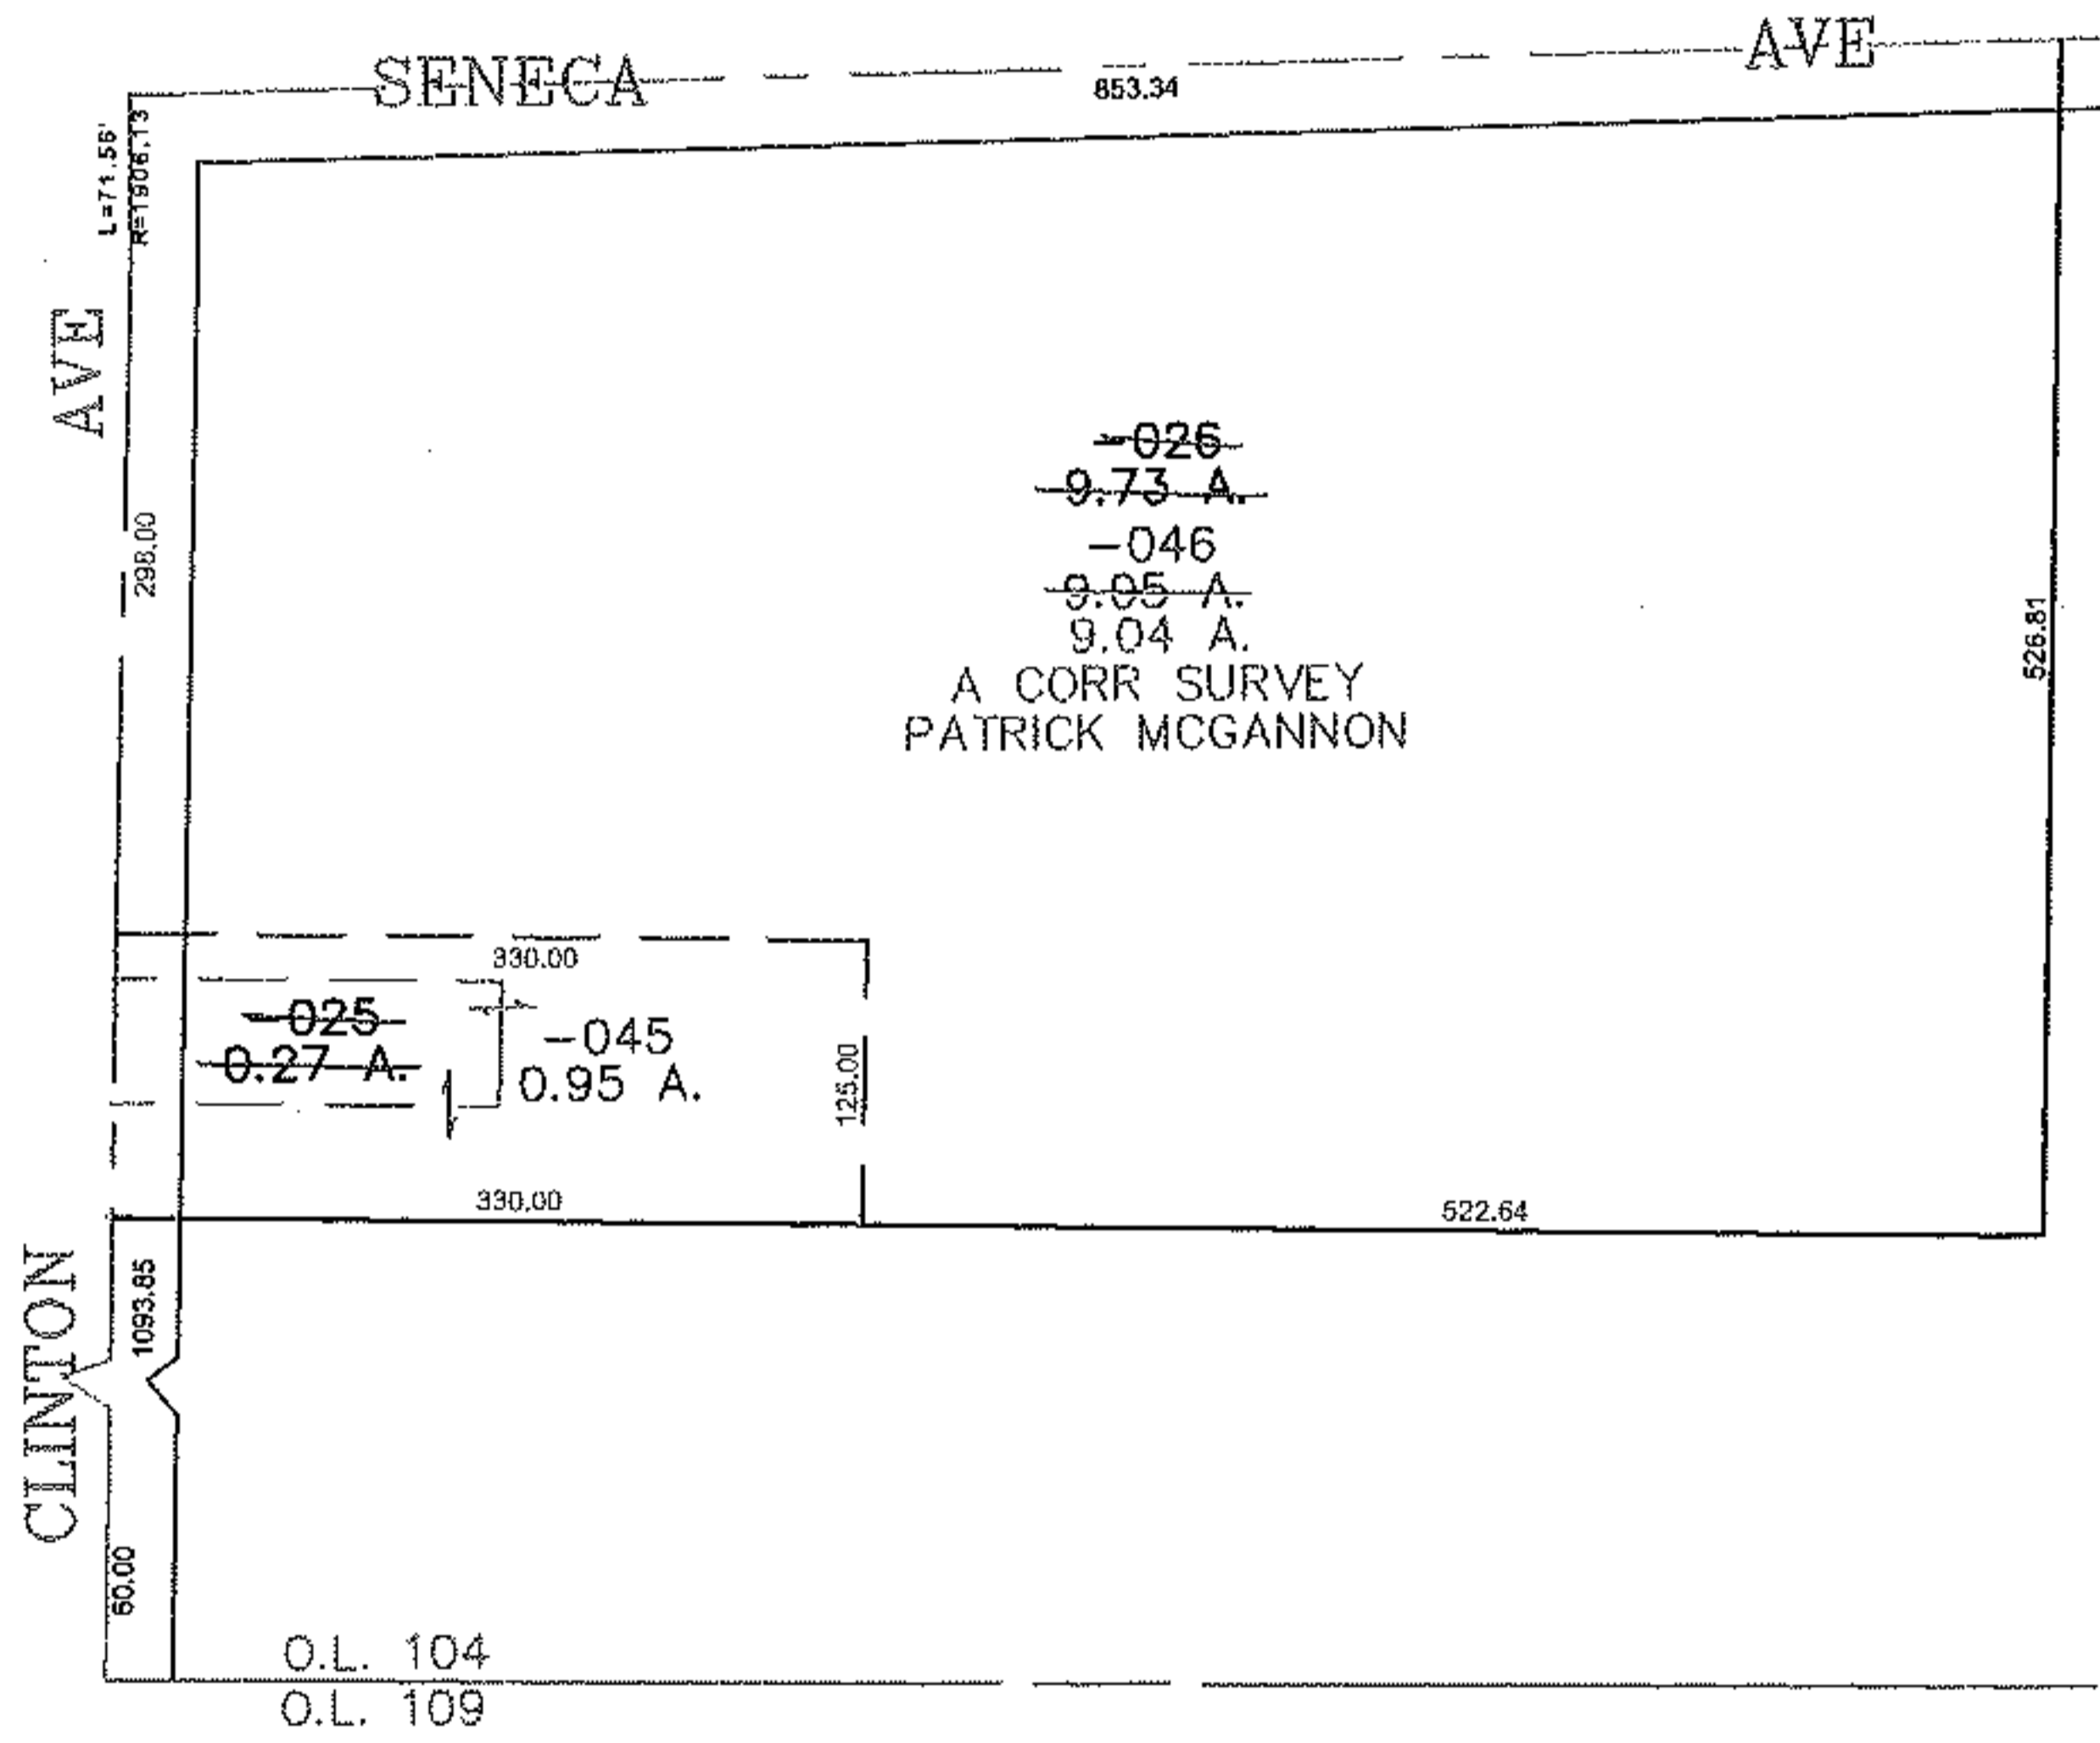


PARENT PARCEL: 03-00-104-101-026, -025
 CHILD PARCEL: 03-00-104-101-045, -046
 STARTING POINT: CENTERLINE OF CLINTON AVE & O.L. 104

12-03032

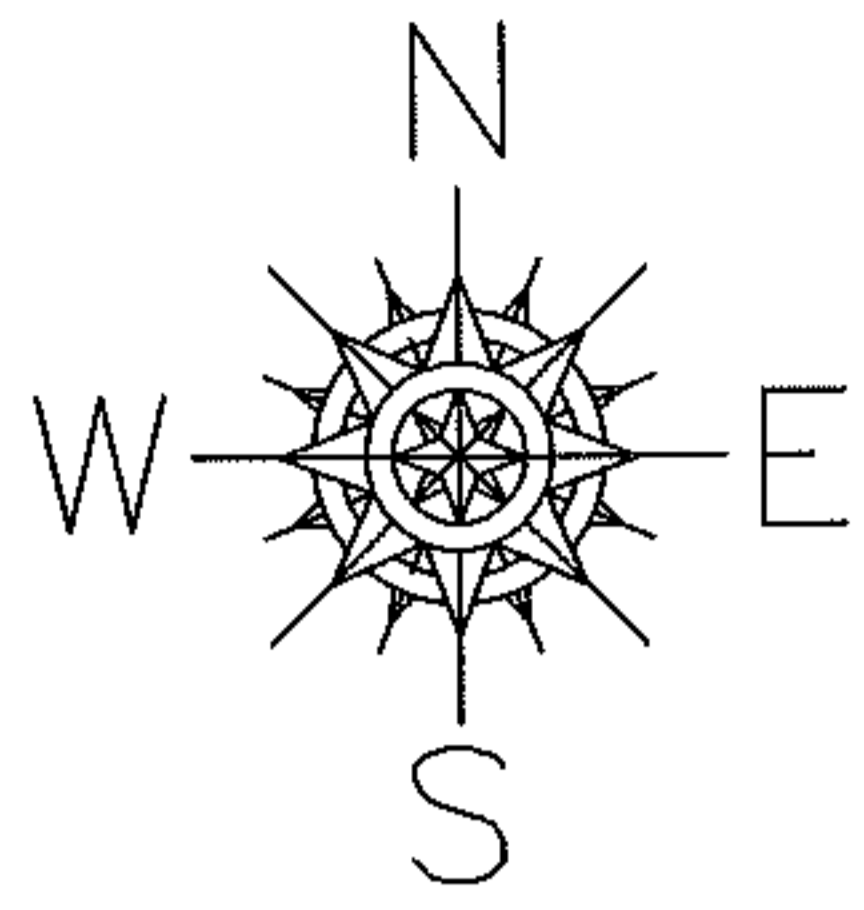

SPLITS/DEEDS PROCESSED
 LORAIN COUNTY TAX MAP DEPARTMENT
 226 MIDDLE AVE. ELYRIA, OHIO

SURVEYED BY: PATRICK MCGANNON
 CLOSURE: 0.00 : 10.000
 MAP PAGE(S): 03-00-104-A
 APPROVED BY: JAH DATE: 6-4-2012
 SCALE: 1" = 200 PRIOR INSTRUMENT: 2011091040