
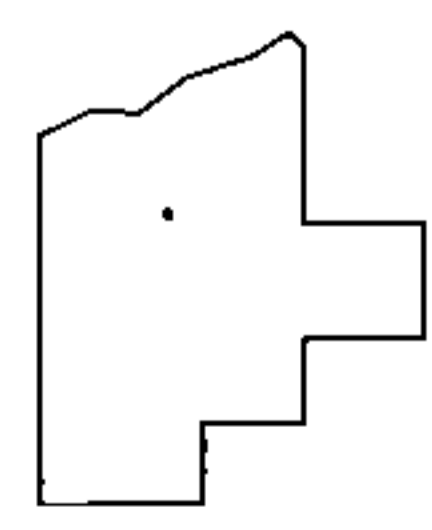
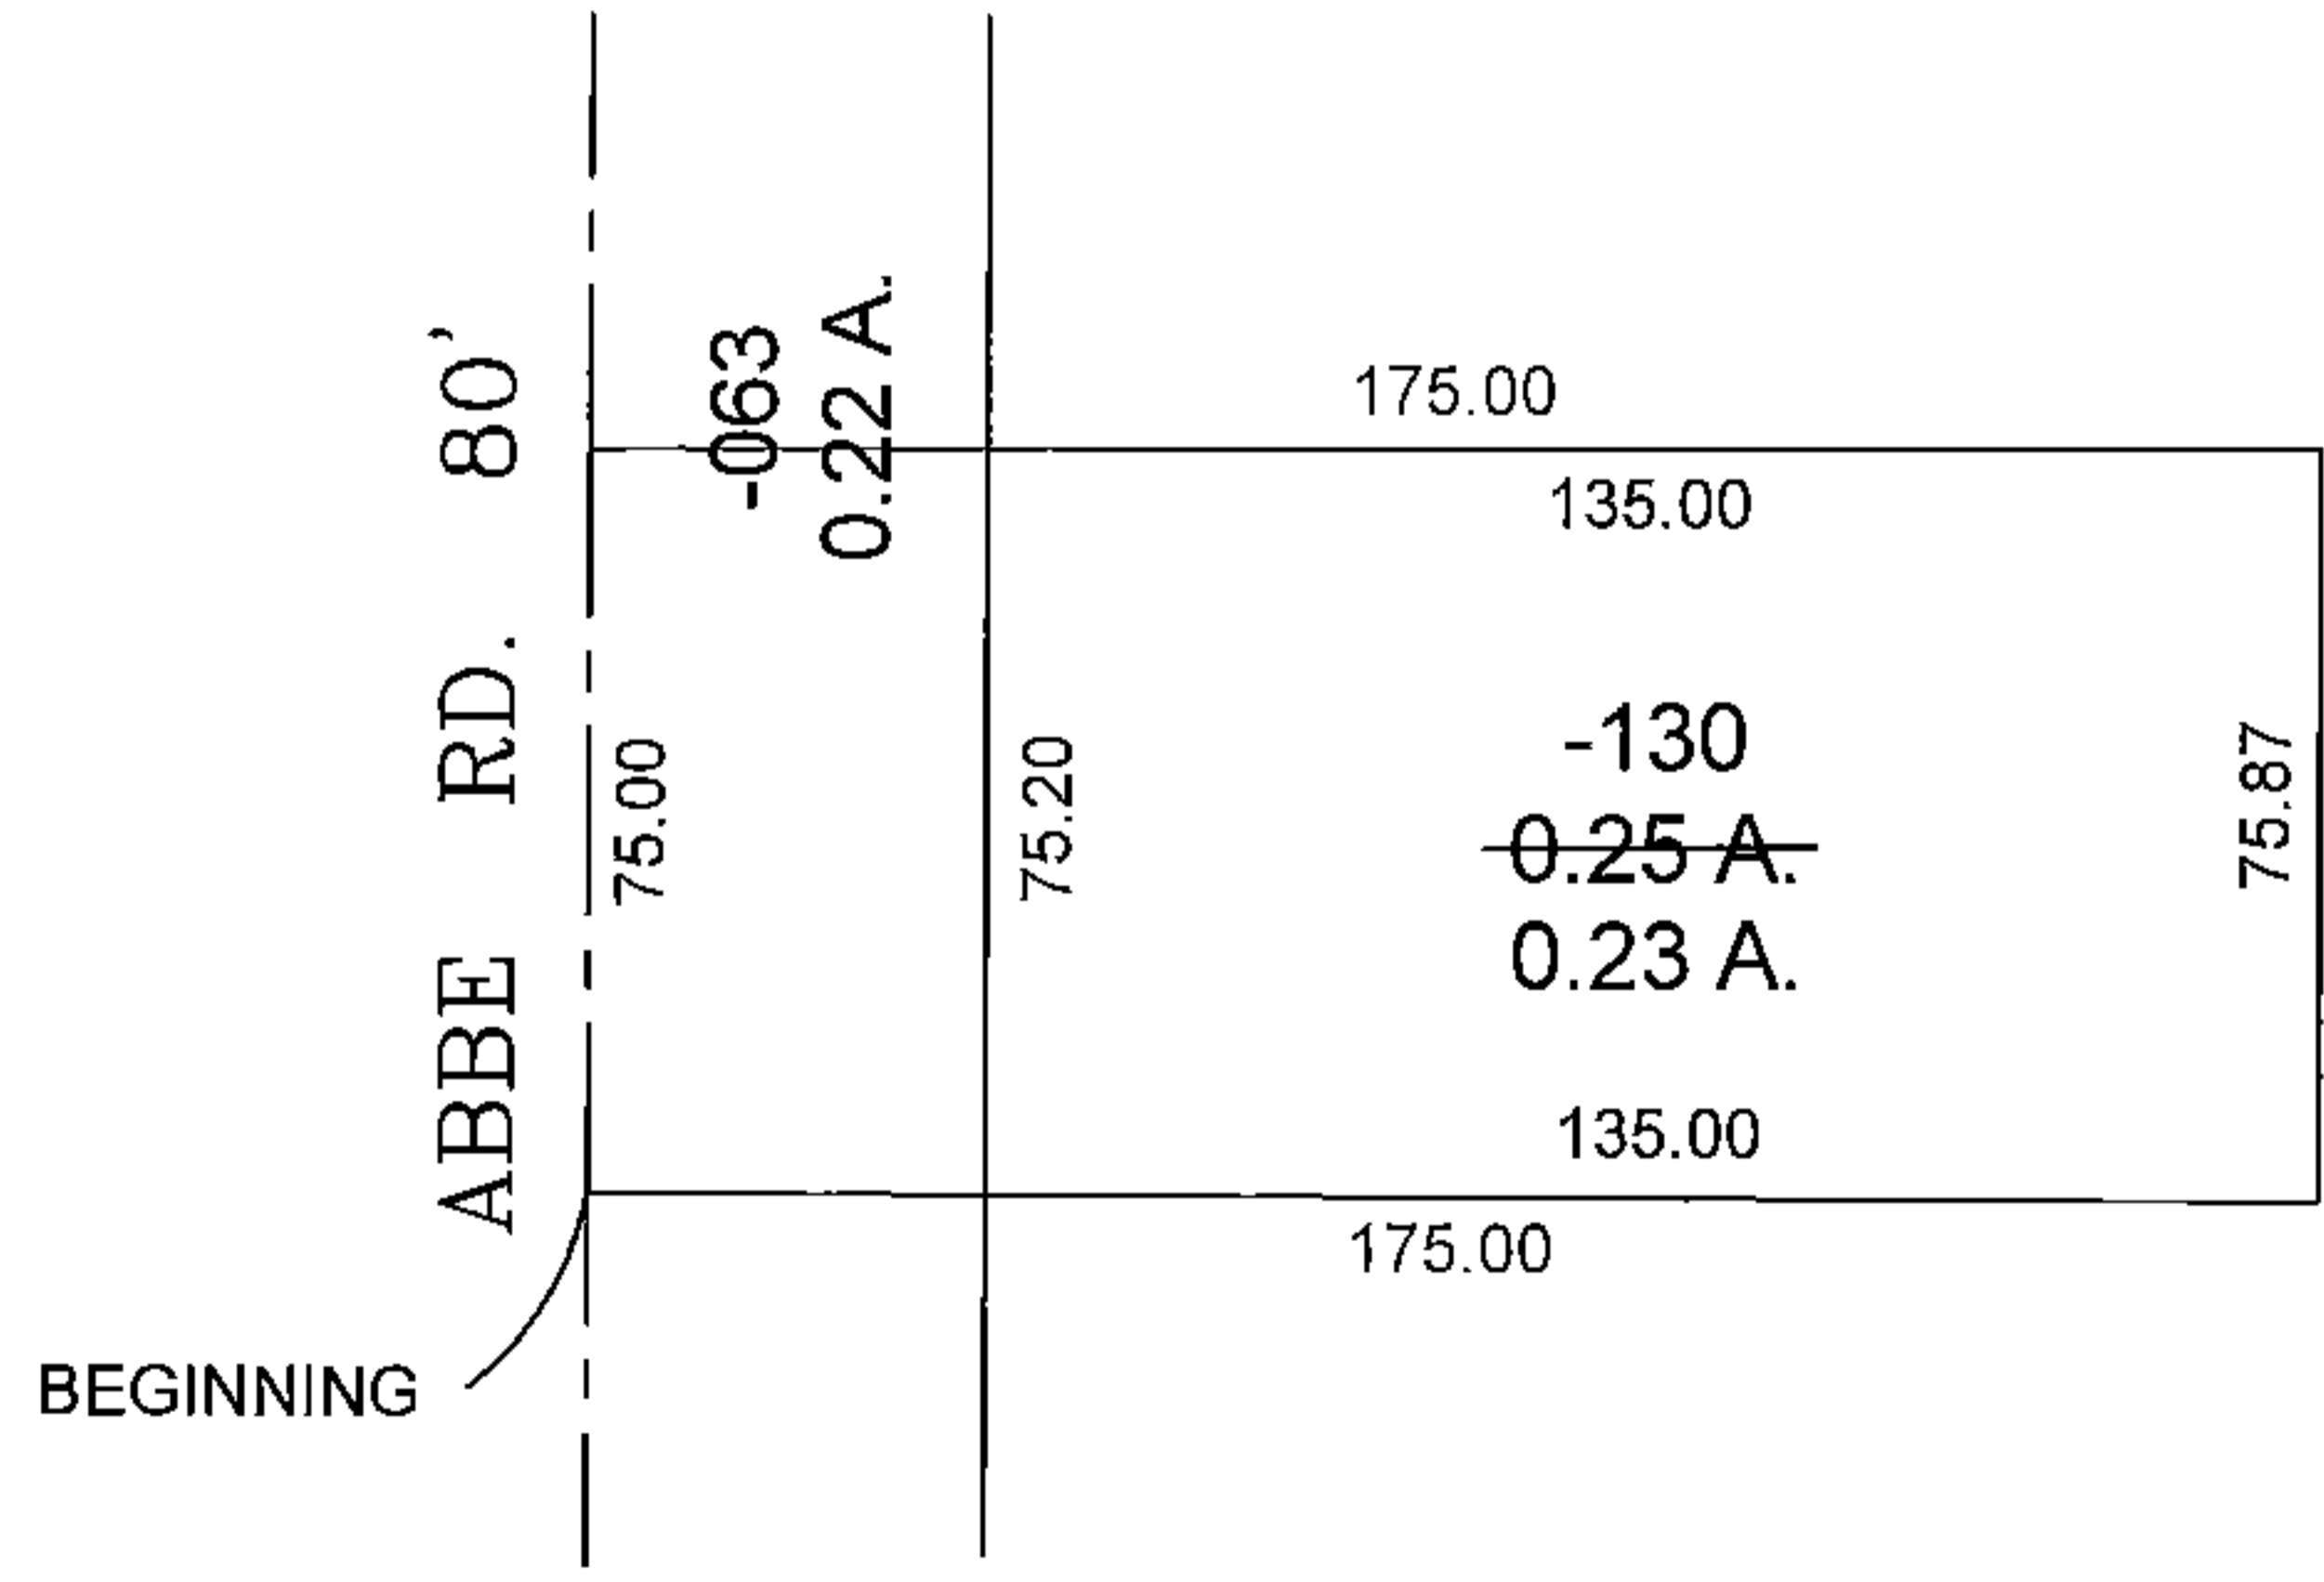


PARENT PARCEL: 06-25-026-101-130
 CHILD PARCEL: XX-XX-XXX-XXX-XXX
 STARTING POINT: N. W. CORNER OF SLUSSER, TED W. & PAULA D. DV 1216/504

14-03034-A

ACREAGE CORRECTION

06-25-026-101-130
~~0.25 A.~~
 0.23 A.
 CORR. PER DEED
 & EXCEPTION
 INST. # 20140521196

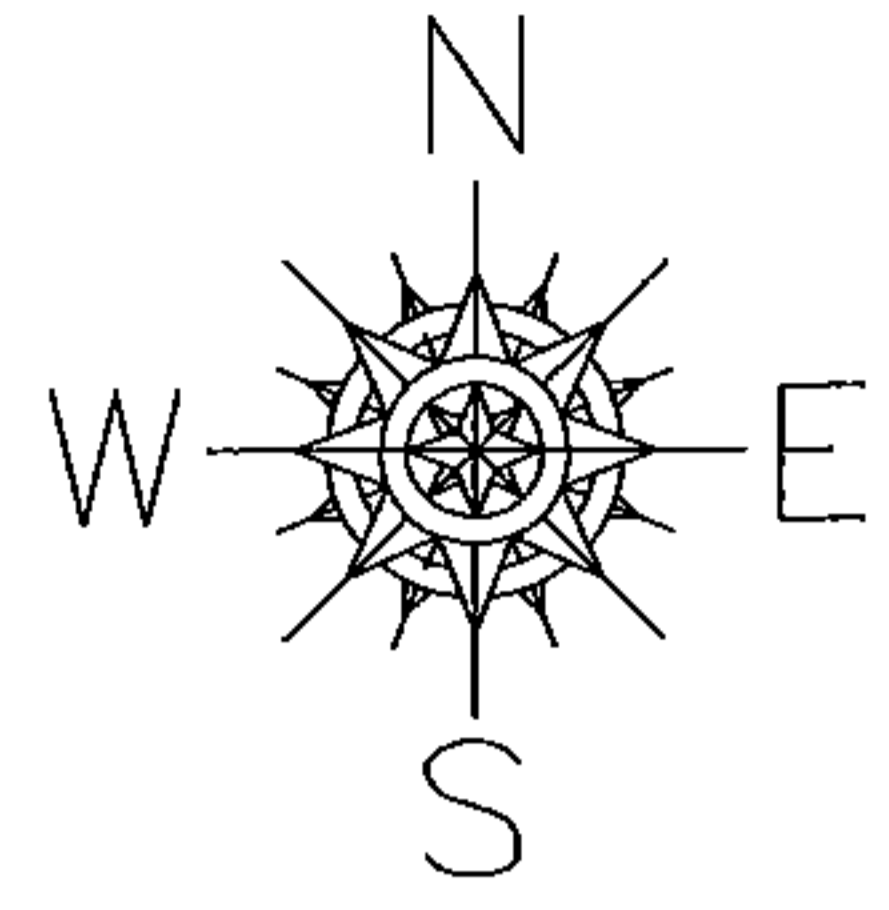

SPLITS/DEEDS PROCESSED
 LORAIN COUNTY TAX MAP DEPARTMENT
 226 MIDDLE AVE. ELYRIA, OHIO

SURVEYED BY: NA
 CLOSURE: 0.01 : 10,000
 MAP PAGE(S): 6-25-026
 APPROVED BY: TJS DATE: 10/6/14
 SCALE: 1"= 50' PRIOR INST.: OR 229/243