
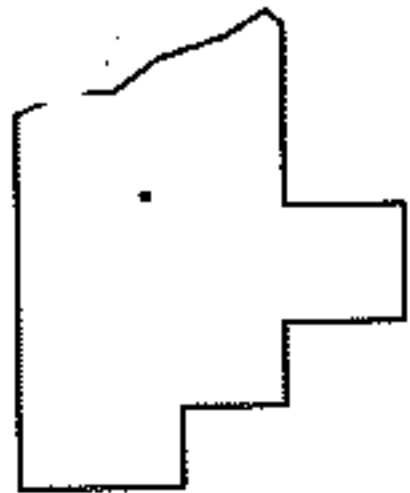
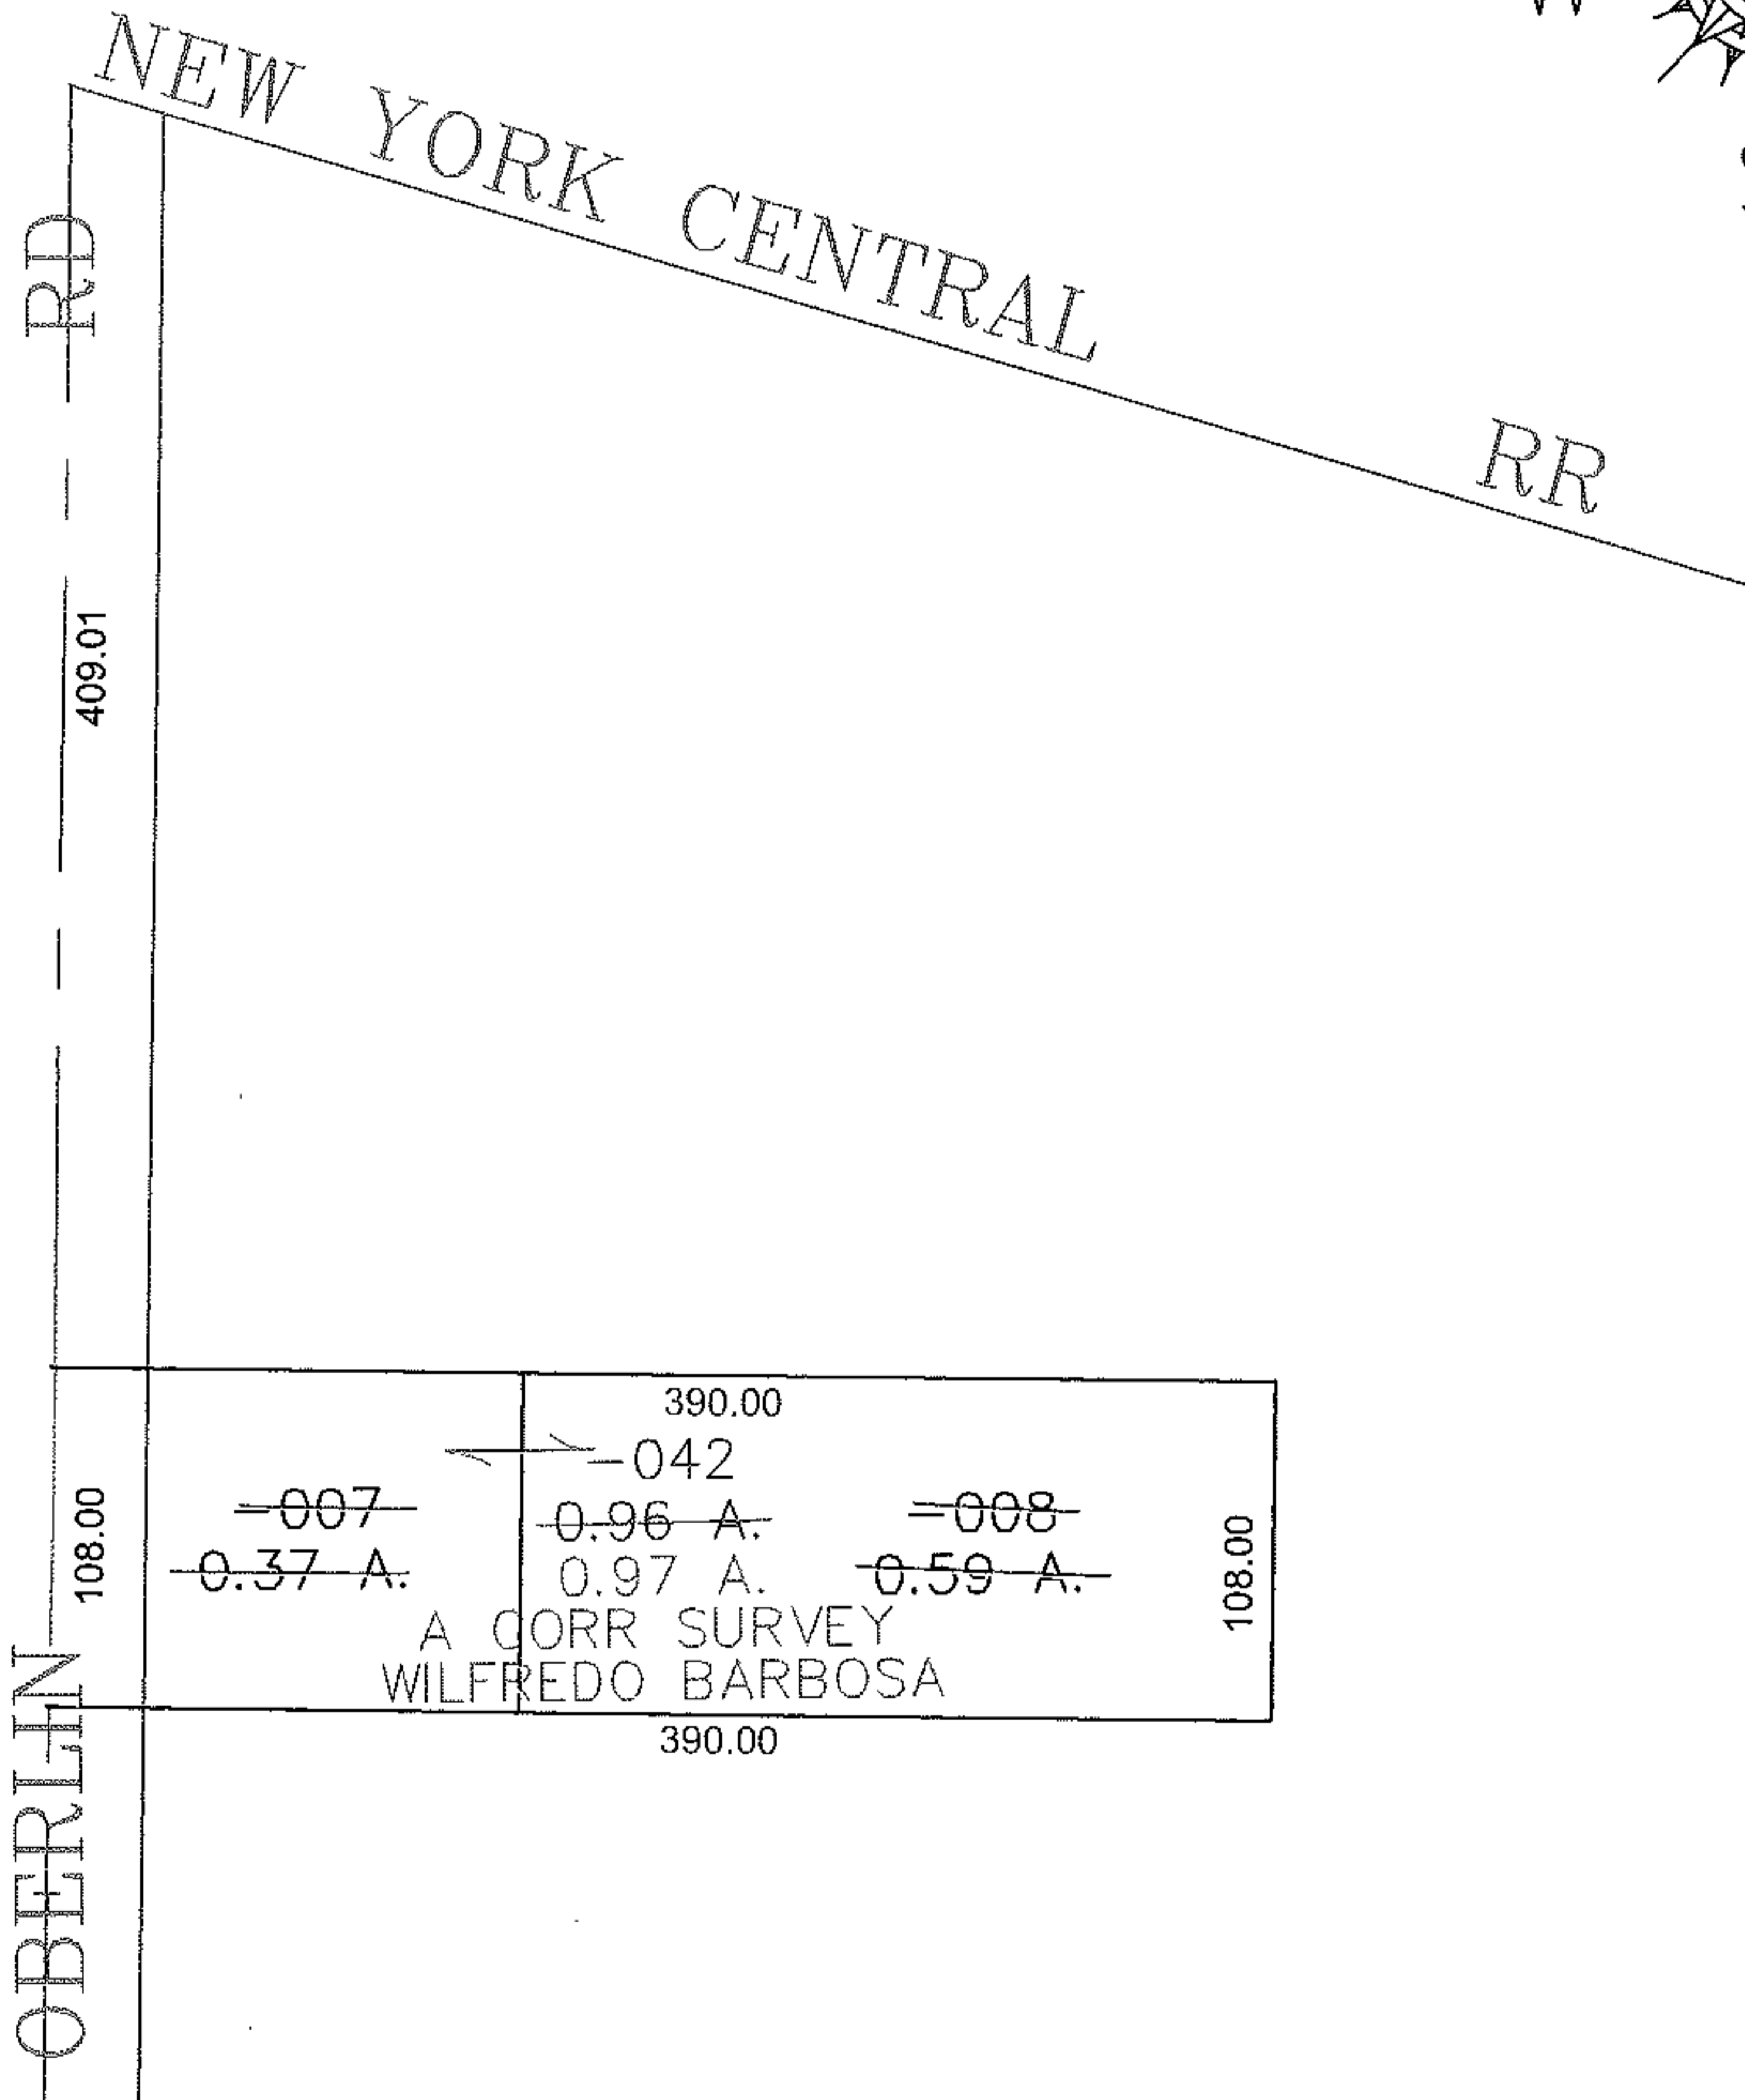


PARENT PARCEL: 05-00-065-000-007, -008

CHILD PARCEL: 05-00-065-000-042

STARTING POINT: CENTERLINE OF OBERLIN RD & NEW YORK CENTRAL RR

12-03034

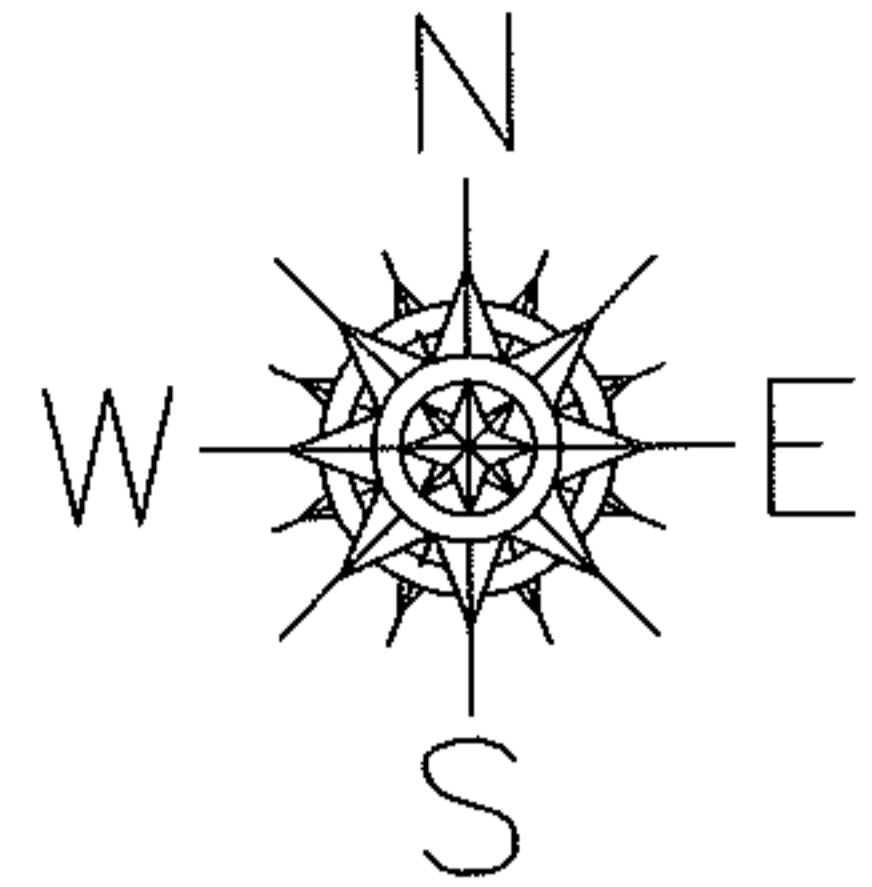

SPLITS/DEEDS PROCESSED

LORAIN COUNTY TAX MAP DEPARTMENT
226 MIDDLE AVE. ELYRIA, OHIO

SURVEYED BY: WILDREDO BARBOSA
 CLOSURE: 0.00 : 10.000
 MAP PAGE(S): 5-D
 APPROVED BY: JAH DATE: 6-7-2012
 SCALE: 1" = 100 PRIOR INSTRUMENT: 20090282437