




*Paster*

PARENT PARCEL: 07-00-041-000-071

CHILD PARCEL: 07-00-041-000-072, -073

STARTING POINT: CENTERLINE OF BARRES RD & OTTEN RD

12-03035

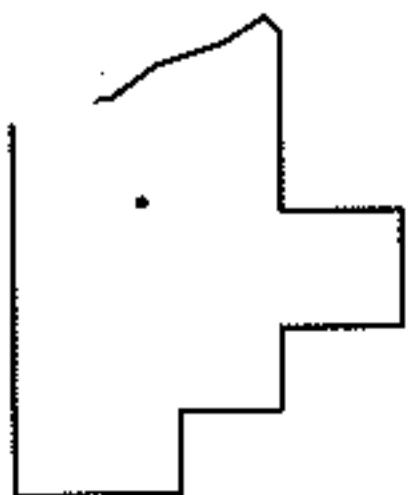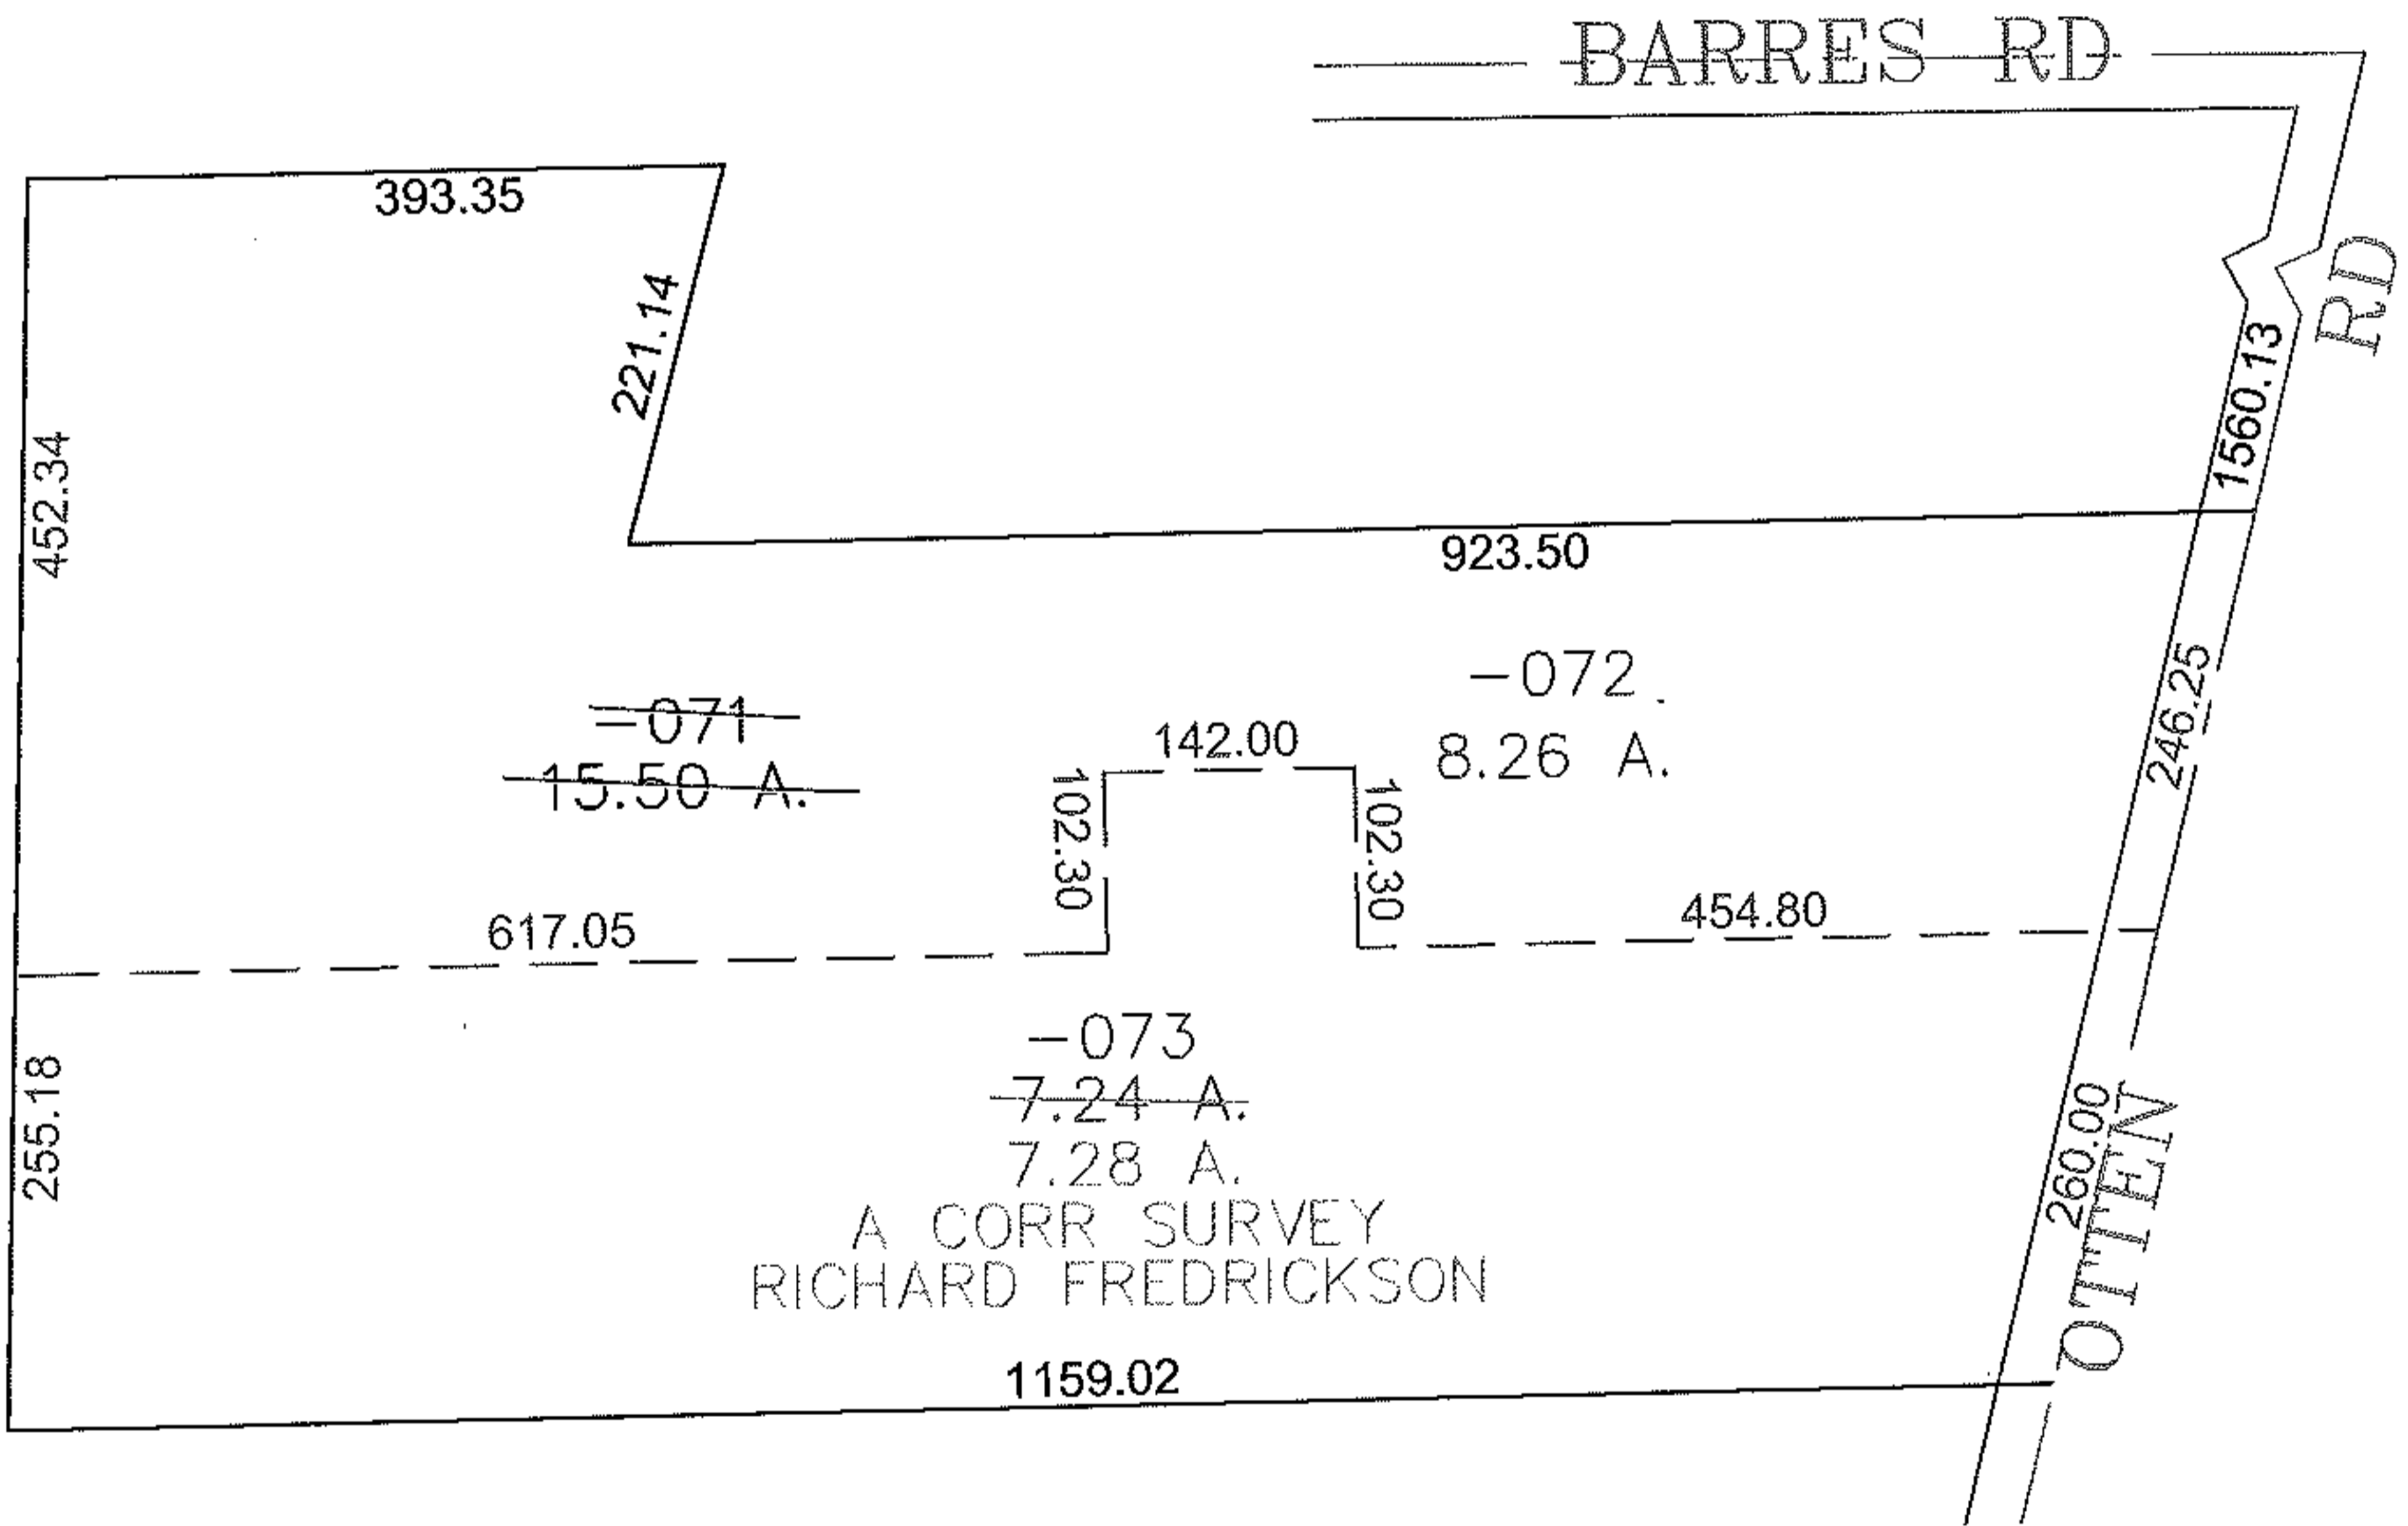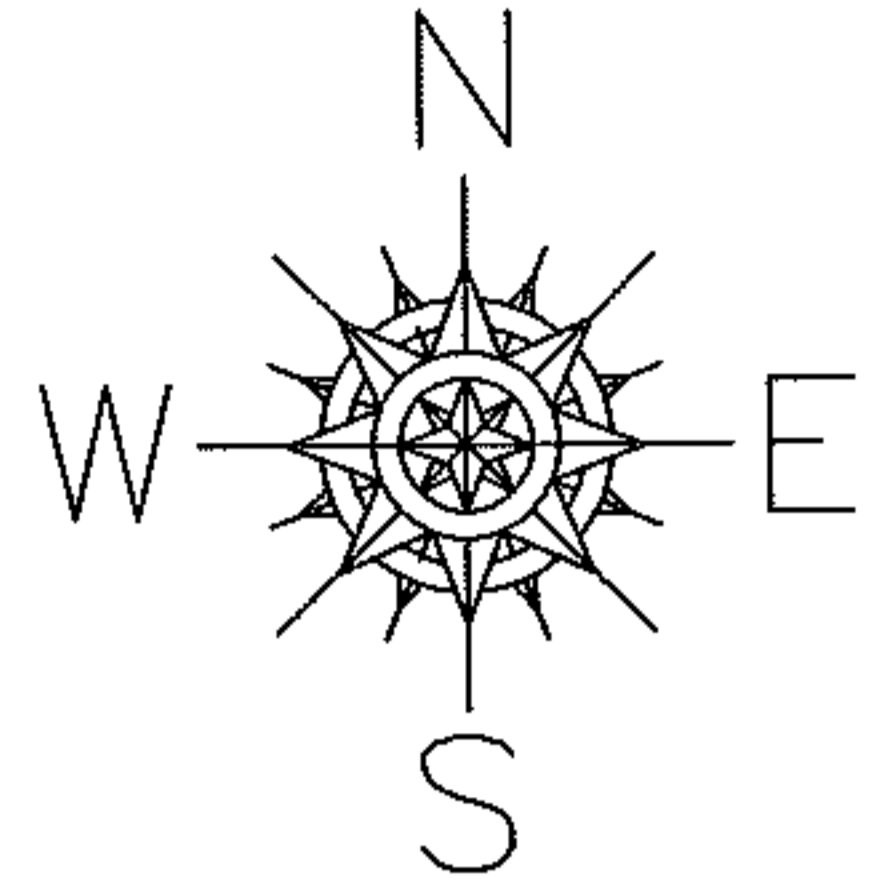

**SPLITS/DEEDS PROCESSED**  
 LORAIN COUNTY TAX MAP DEPARTMENT  
 226 MIDDLE AVE. ELYRIA, OHIO

SURVEYED BY: RICHARD FREDRICKSON  
 CLOSURE: 0.00 : 10.000  
 MAP PAGE(S): 7-A  
 APPROVED BY: JAH DATE: 6-7-2012  
 SCALE: 1" = 200' PRIOR INSTRUMENT: 20110371732