

PARENT PARCEL: 05-00-024-118-016  
 CHILD PARCEL: 05-00-024-118-026, -027, & -028  
 STARTING POINT: PARCEL 1) EASTERLY 140' OF THE NORTHERLY 50' OF S/L 181  
IN JOSIAH HARRIS HEIRS ADD.  
PARCEL 2) N.E. CORNER OF S/L 112 IN JOSIAH HARRIS ADDITION

14-03040-U




UNCOMBINATION

~~05-00-024-118-016~~  
~~50 X 240~~

05-00-024-118-026  
 50 X 140

05-00-024-118-027  
 50 X 30

05-00-024-118-028  
 50 X 70

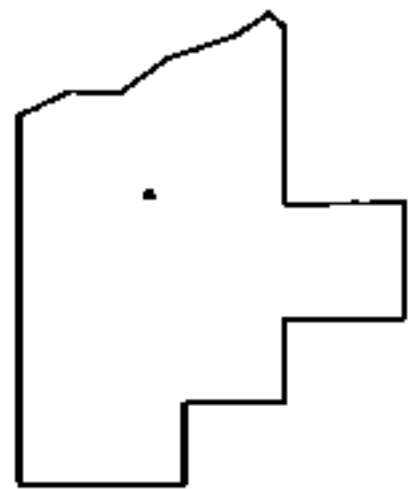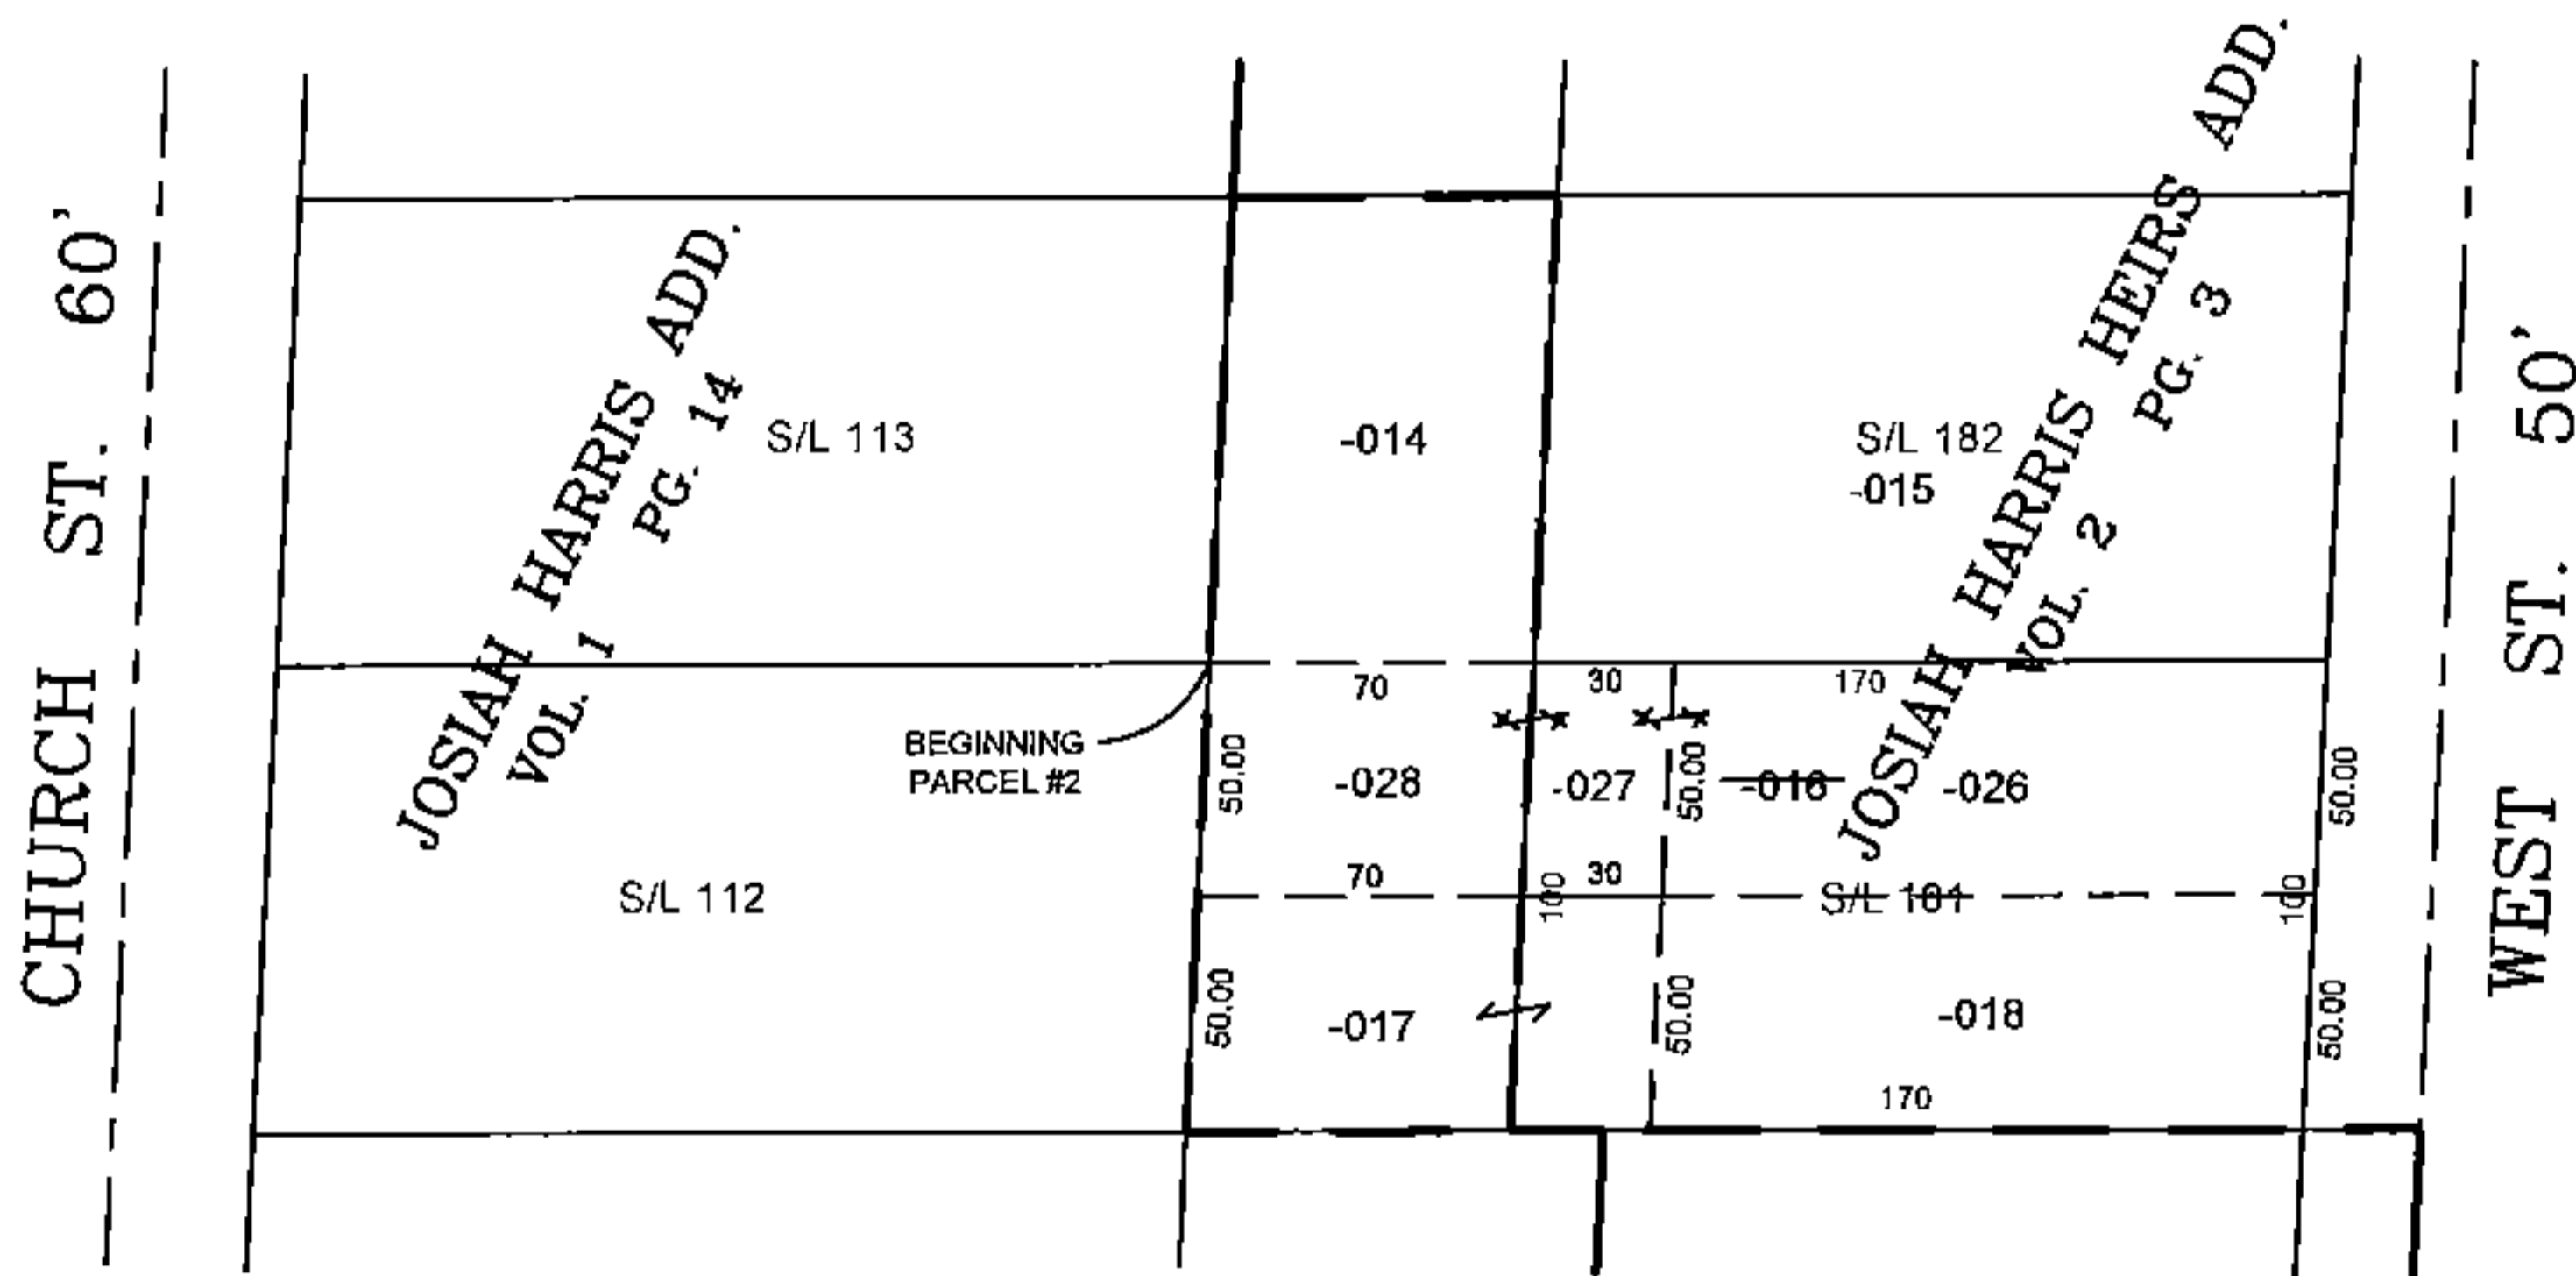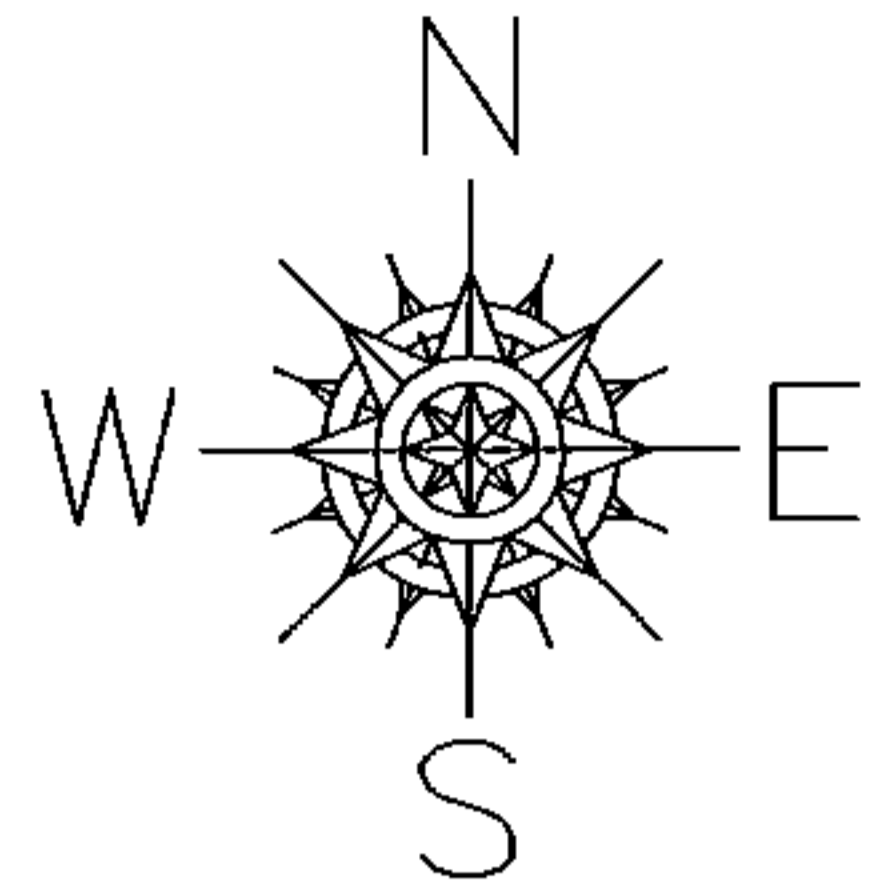

SPLITS/DEEDS PROCESSED

LORAIN COUNTY TAX MAP DEPARTMENT  
 226 MIDDLE AVE. ELYRIA, OHIO

SURVEYED BY: NA  
 CLOSURE: NA  
 MAP PAGE(S): 05-00-024  
 APPROVED BY: TJS DATE: 10/20/14  
 SCALE: 1" = 100 PRIOR INSTRUMENT: 20100353874