


PARENT PARCEL: 01-00-007-103-007, 01-00-008-000-014 01-00-010-000-027

CHILD PARCEL: 01-00-007-103-008, -009

STARTING POINT: CENTERLINE OF BAUMHART RD & WEST ERIE AVE

12-03040

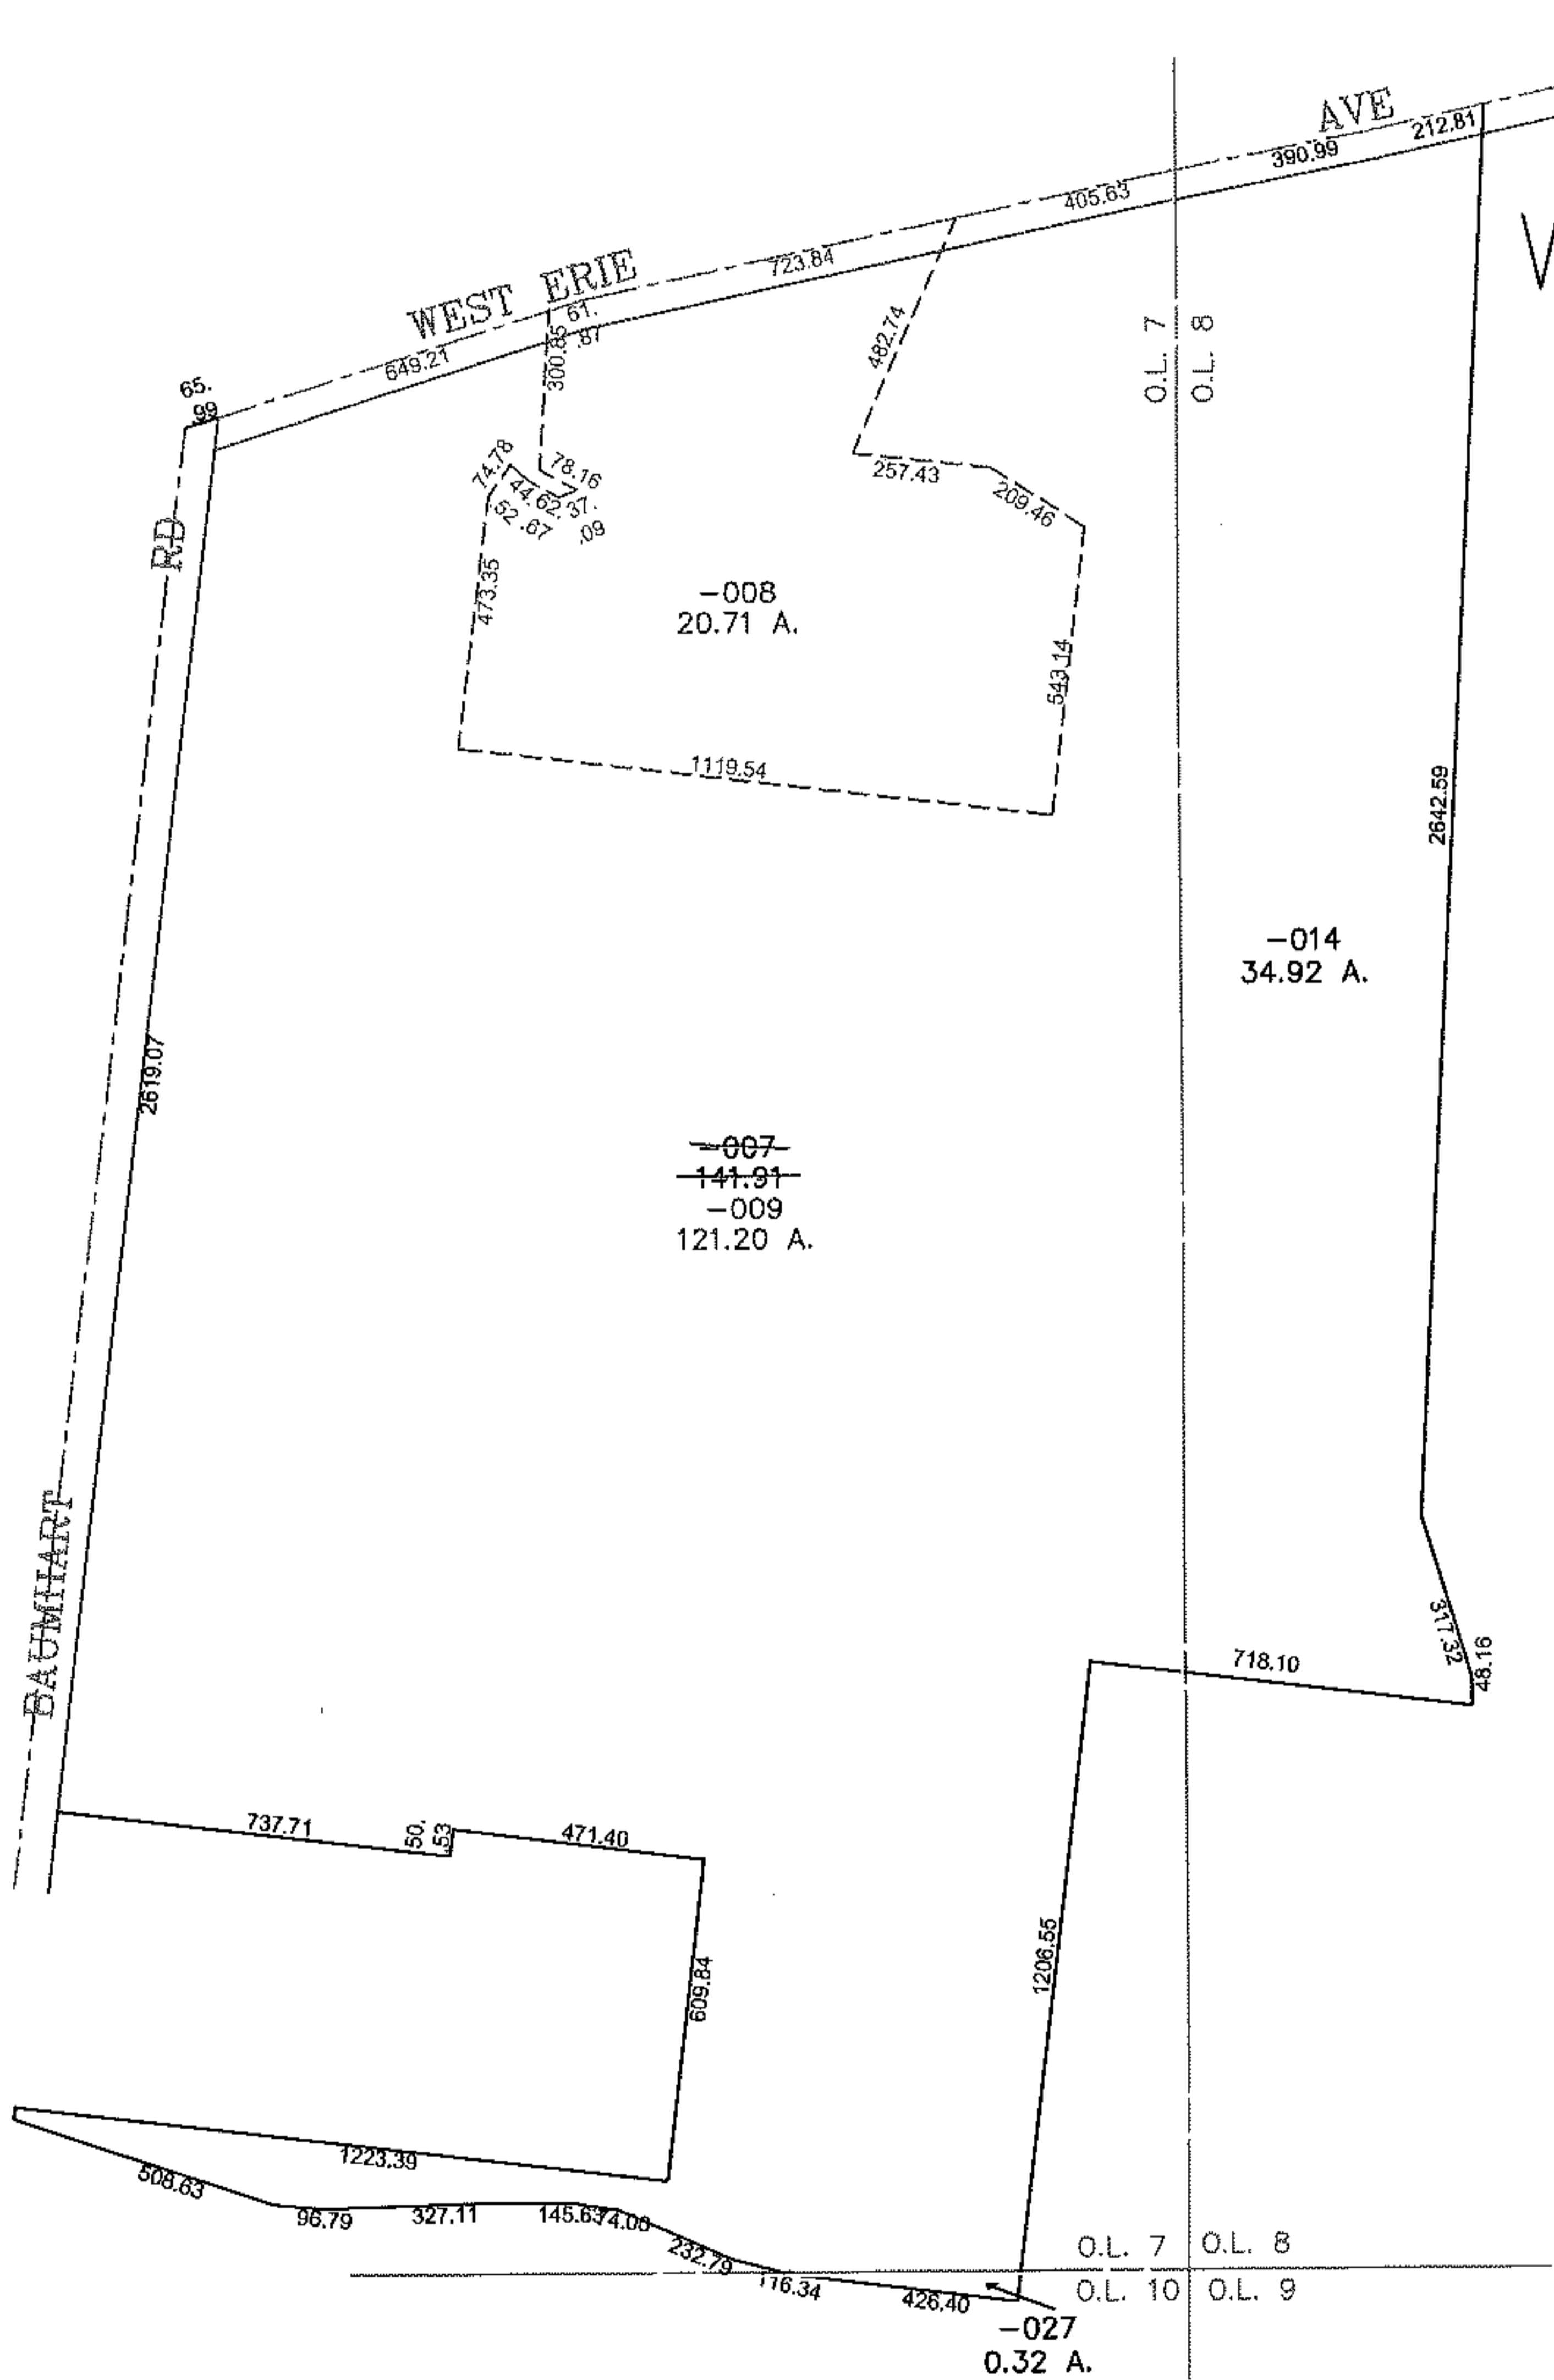

*NEED TO  
FIND WHOLE  
PAGE  
OR  
CALL  
BOB  
ENGINEERS  
FOR BACKUP*

**SPLITS/DEEDS PROCESSED**

LORAIN COUNTY TAX MAP DEPARTMENT  
226 MIDDLE AVE. ELYRIA, OHIO

SURVEYED BY: JOHN R ALBAN  
 CLOSURE: 0.00 : 10.000  
 MAP PAGE(S): 1-D  
 APPROVED BY: JAH DATE: 6-18-2012  
 SCALE: 1" = 550 PRIOR INSTRUMENT: 20090300043