
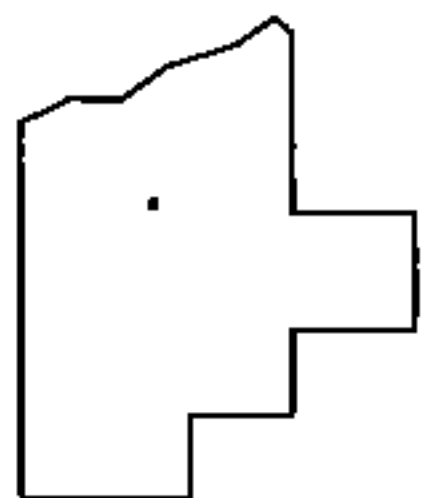
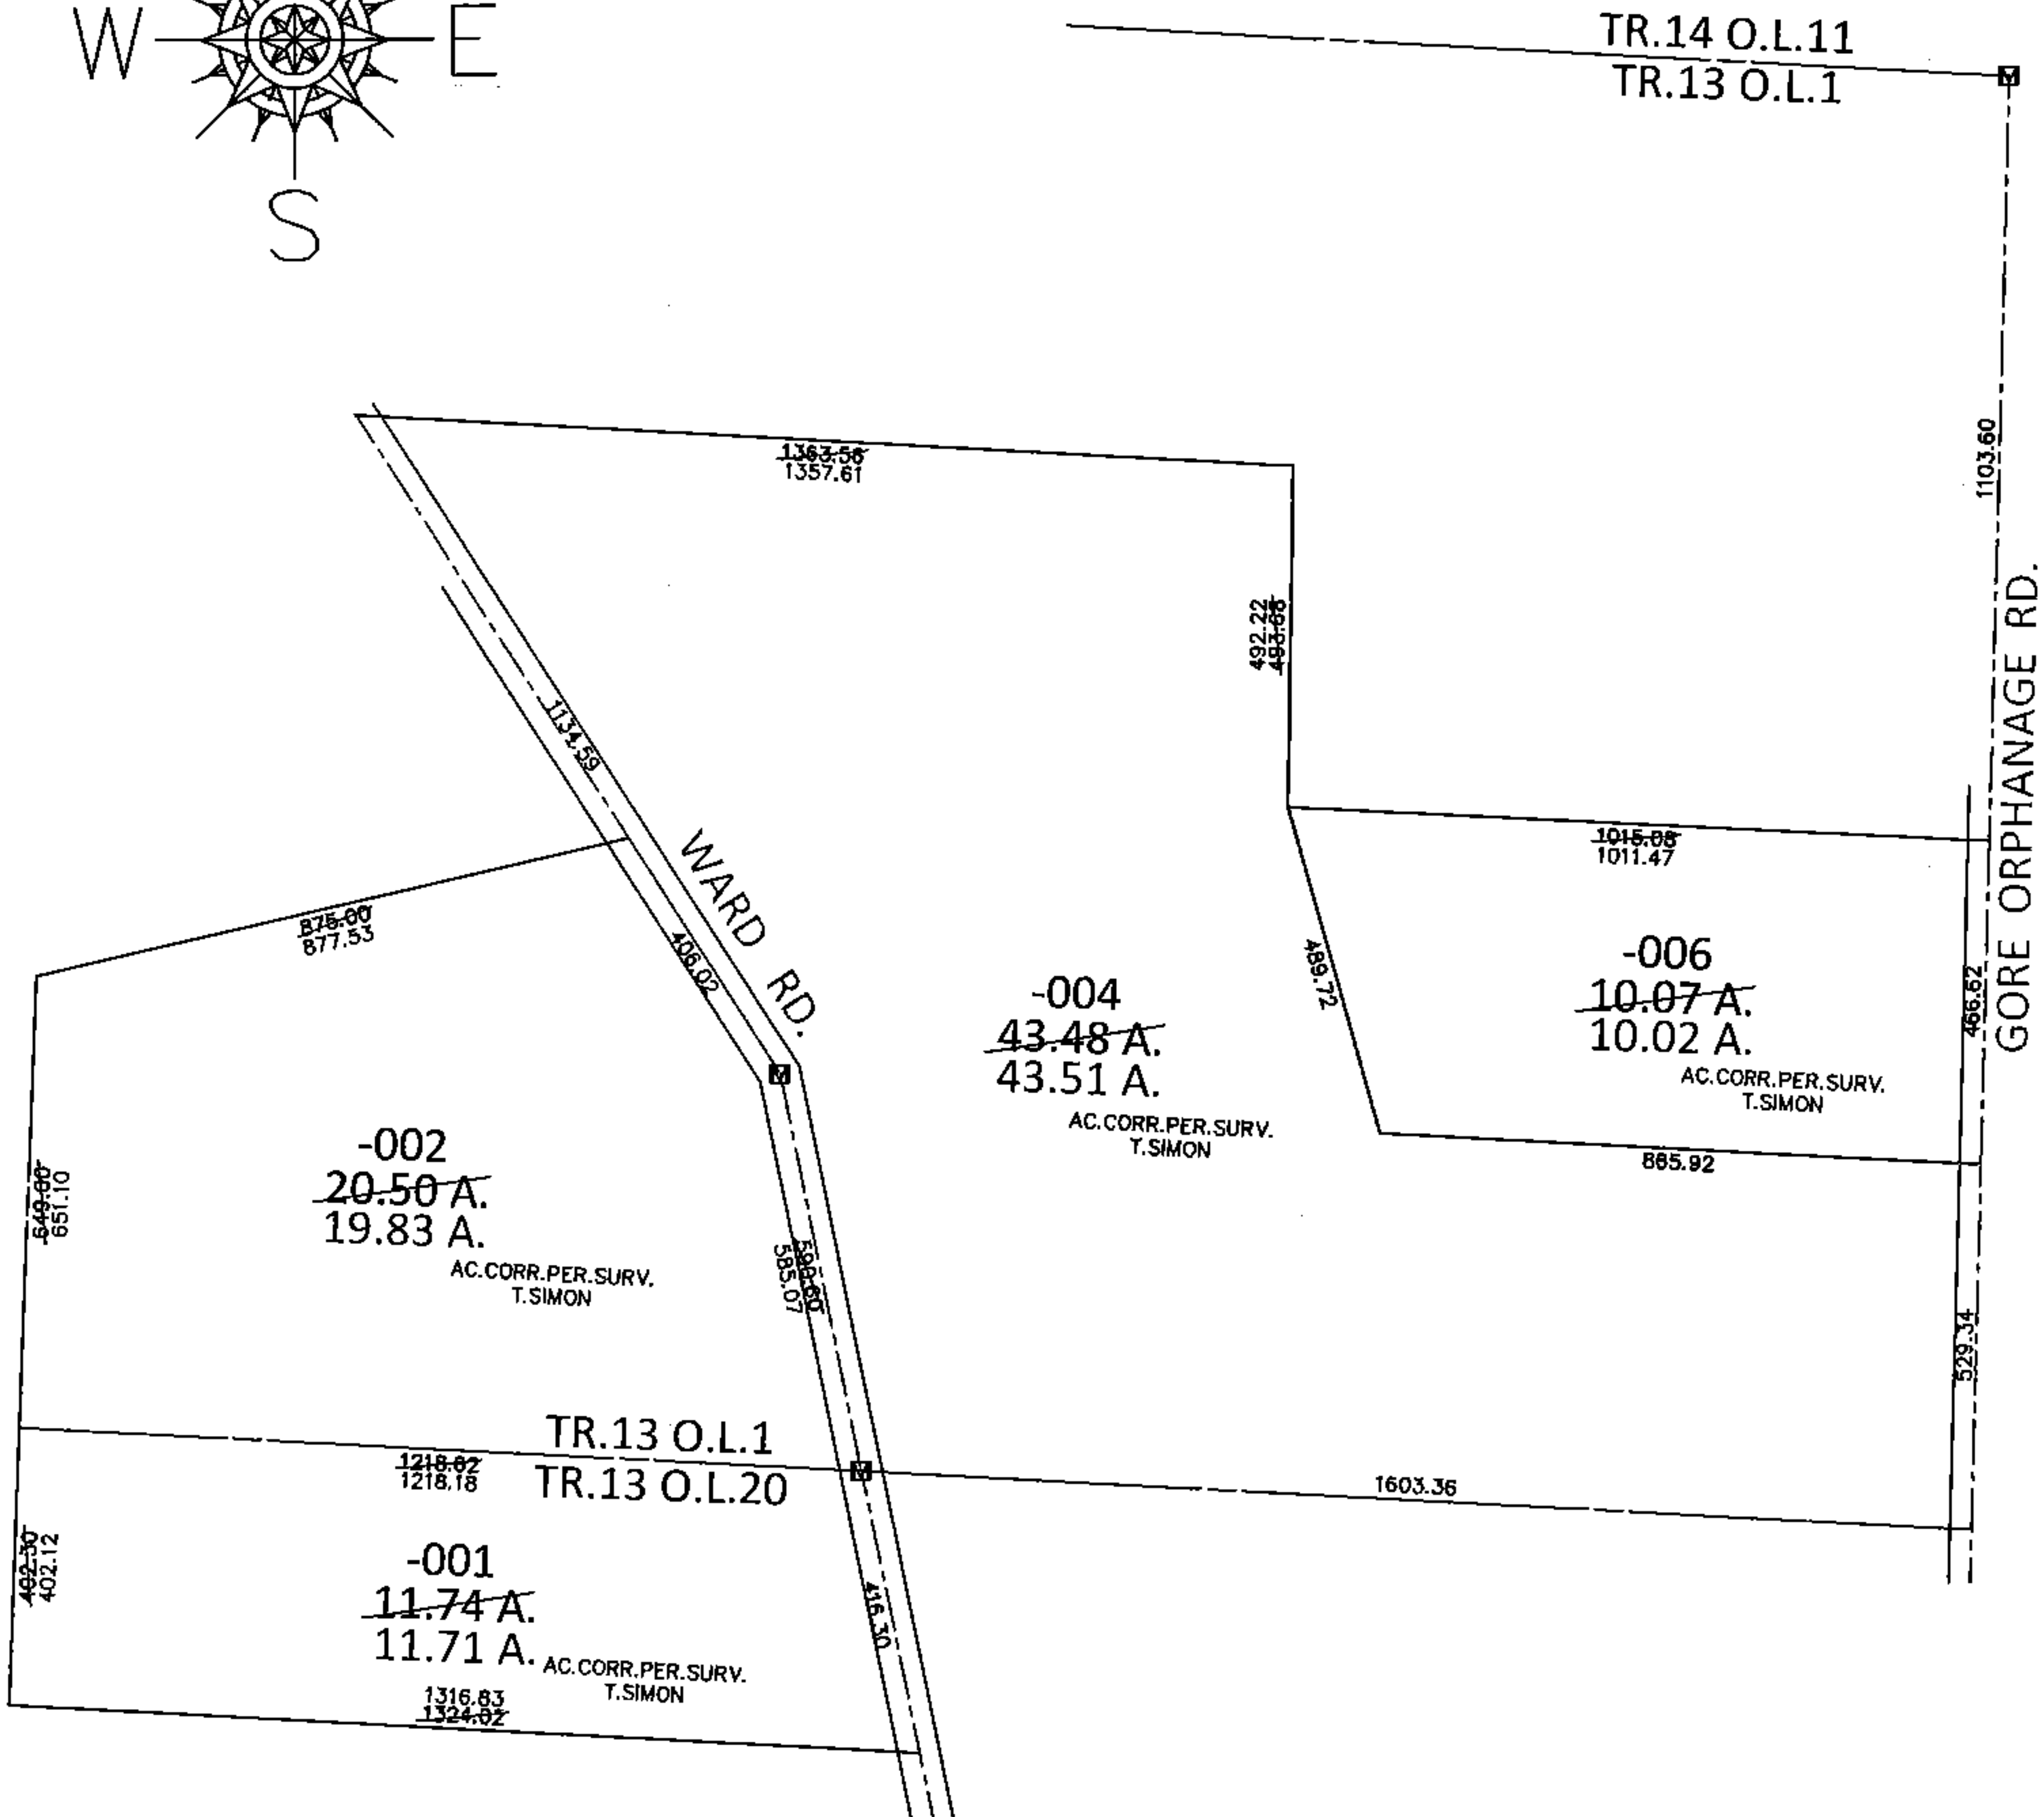


PARENT PARCEL: 08-13-001-000-002, -004, -006, 08-13-020-000-001

CHILD PARCEL:

STARTING POINT: AT A MON BOX AT THE INTERSECTION OF C/L OF WARD RD. AND SOUTH LINE OF O.L.1

14-03041-A

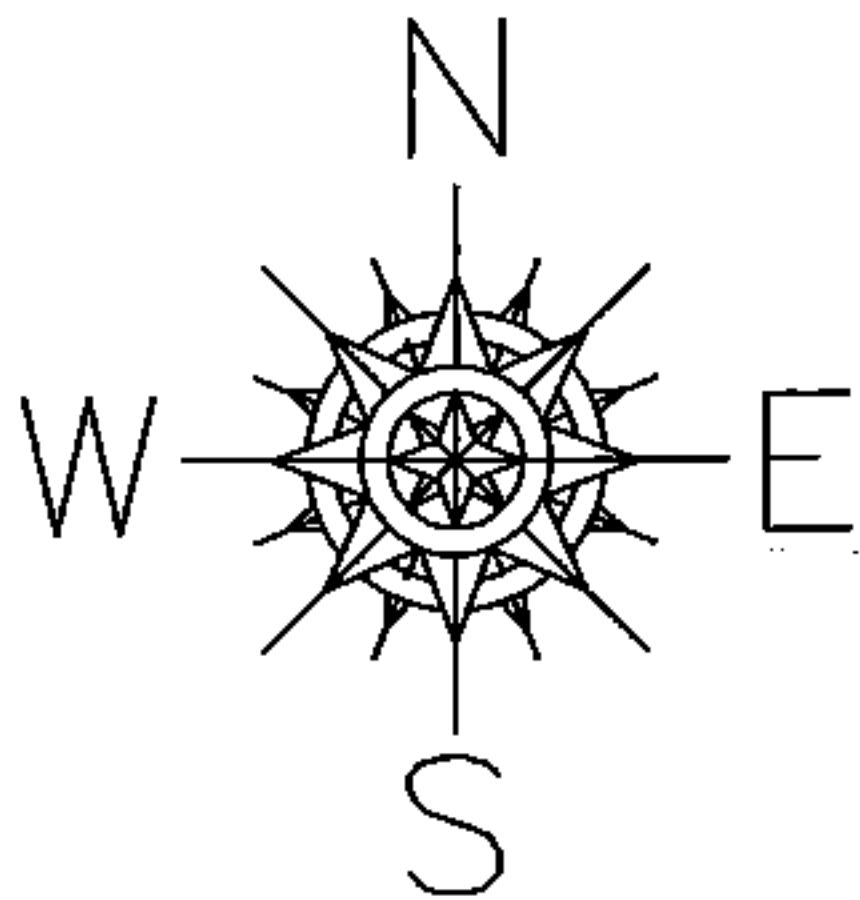

SPLITS/DEEDS PROCESSED

LORAIN COUNTY TAX MAP DEPARTMENT
226 MIDDLE AVE. ELYRIA, OHIO

SURVEYED BY: THOMAS A. SIMON

CLOSURE: .01:10,000

MAP PAGE(S): 8-E

APPROVED BY: RRM DATE: 10-14-14

SCALE: 1"= 400 PRIOR INST.: 20030891722