
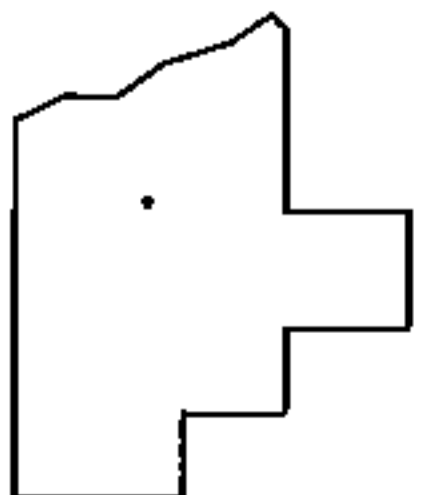
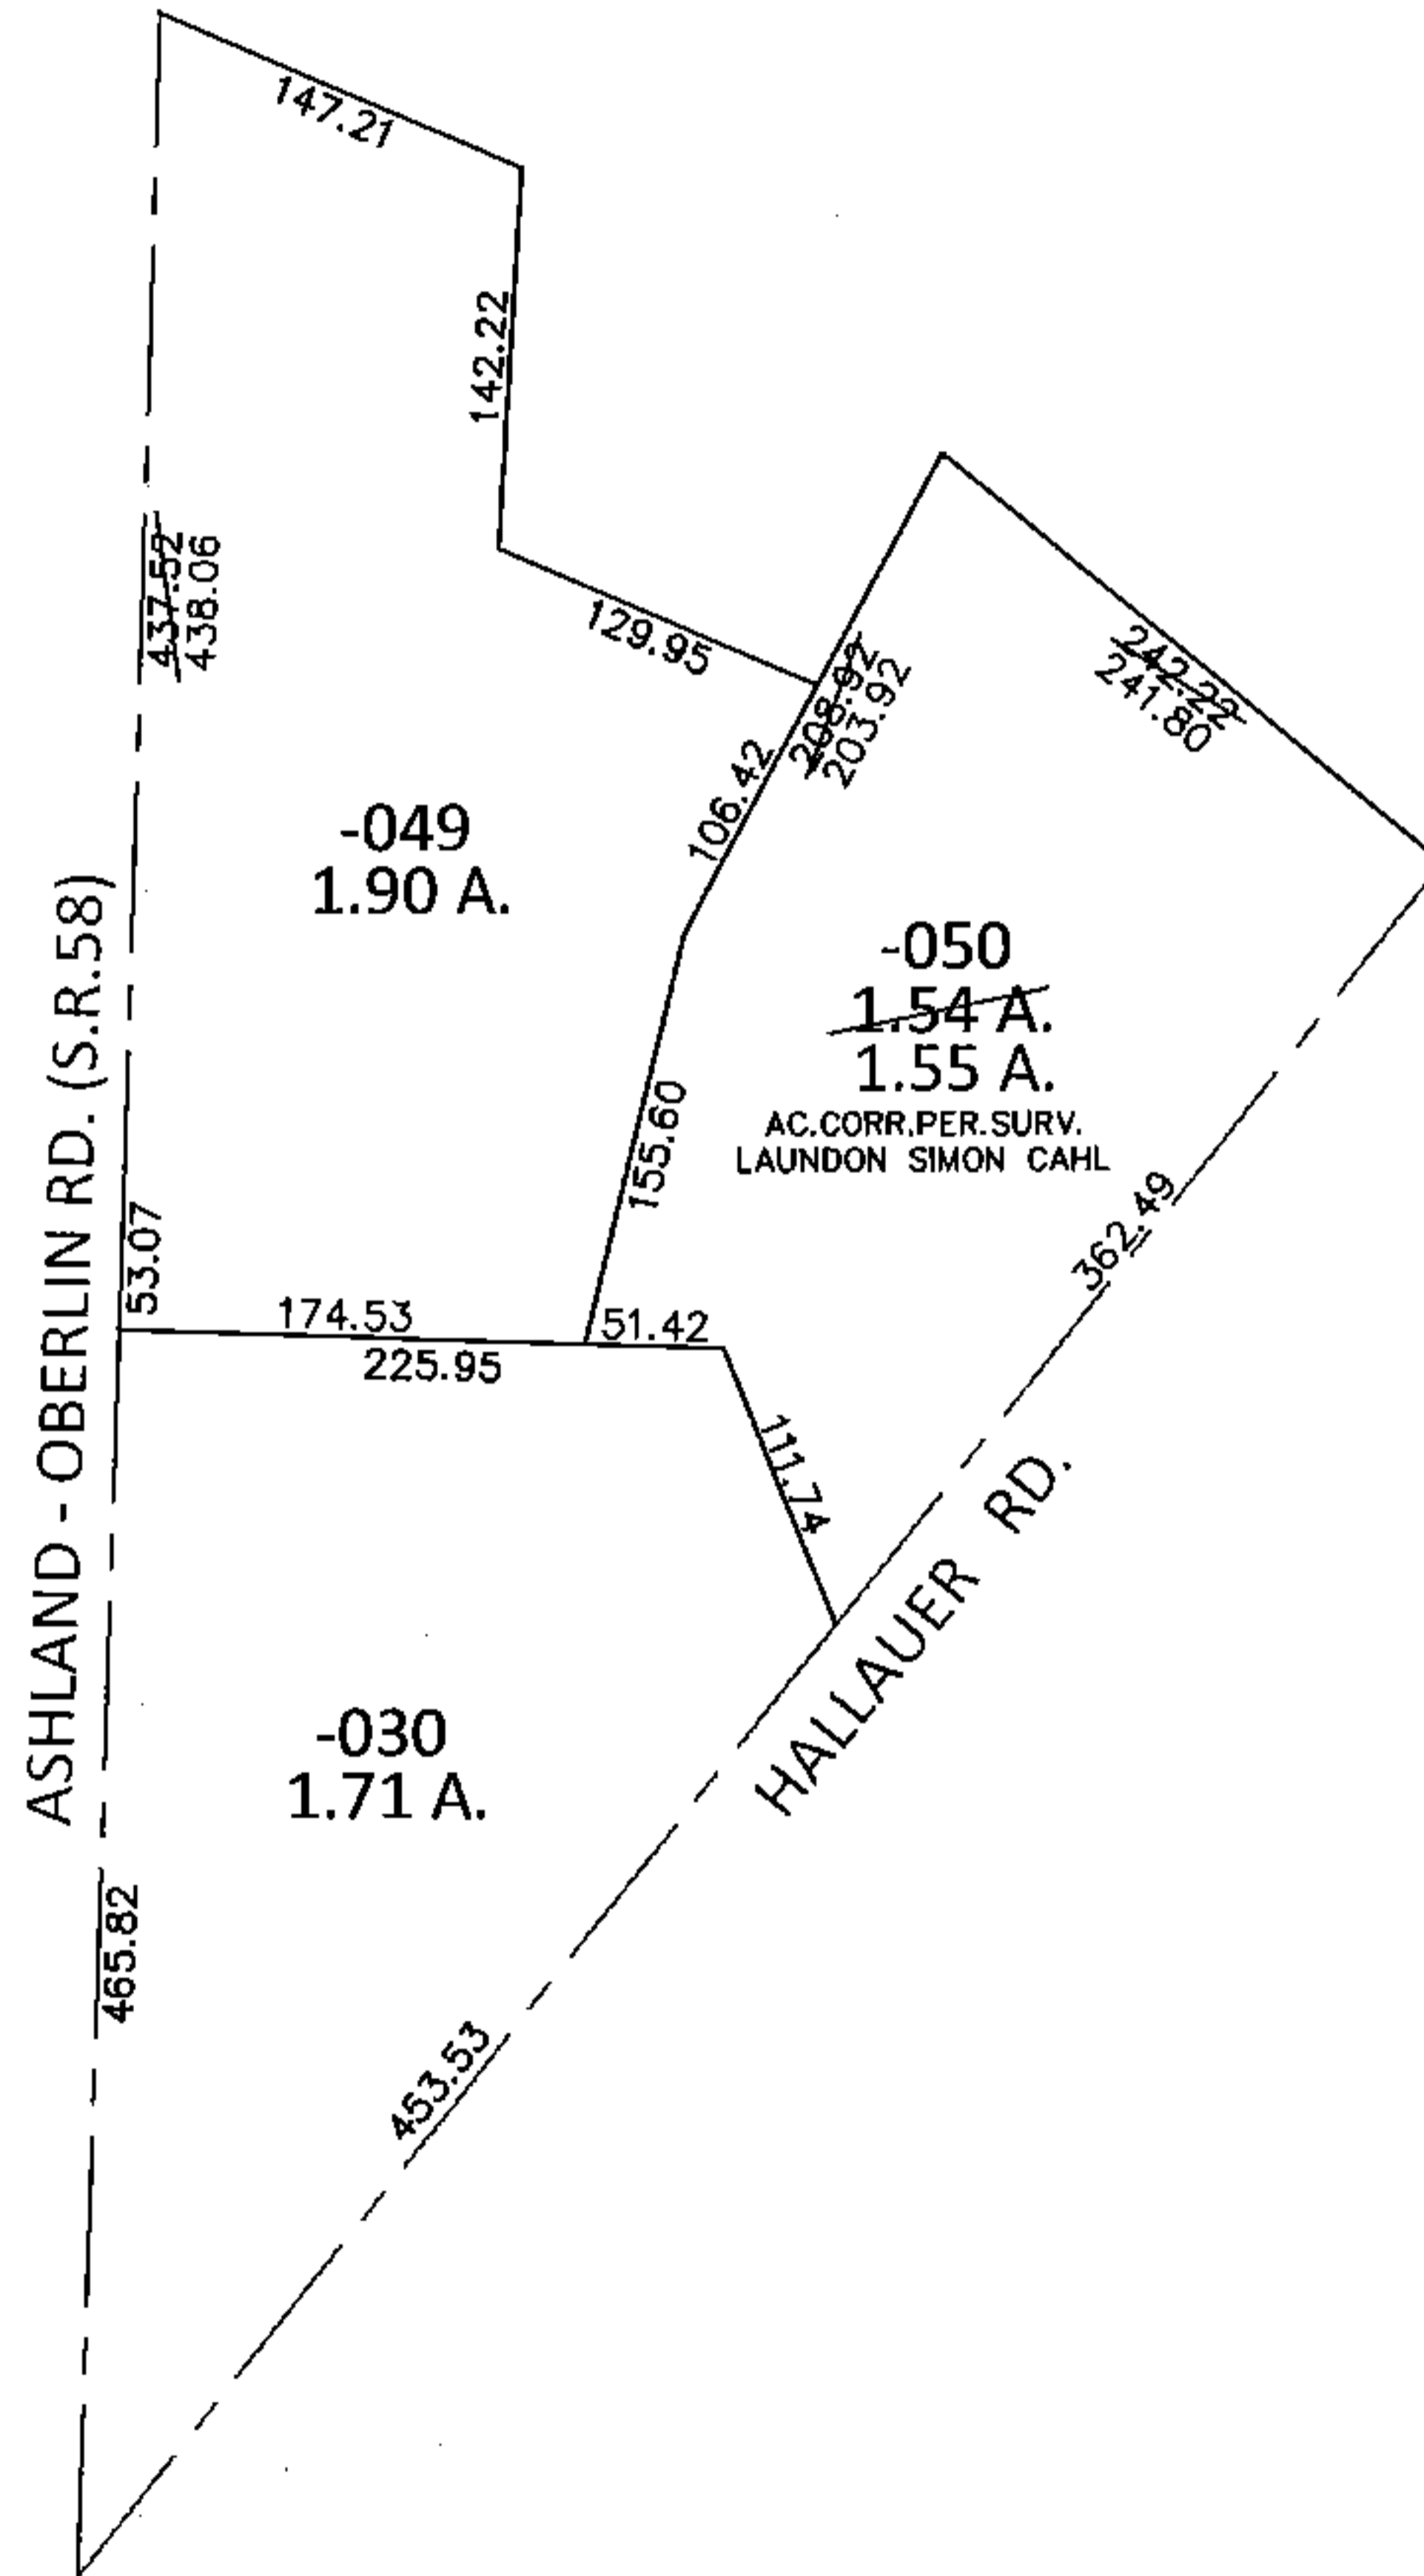


PARENT PARCEL: 14-00-096-000-050

CHILD PARCEL: _____

STARTING POINT: INTERSECTION OF C/L OF S.R.58 AND C/L OF HALLAUER RD.

14-03042-A

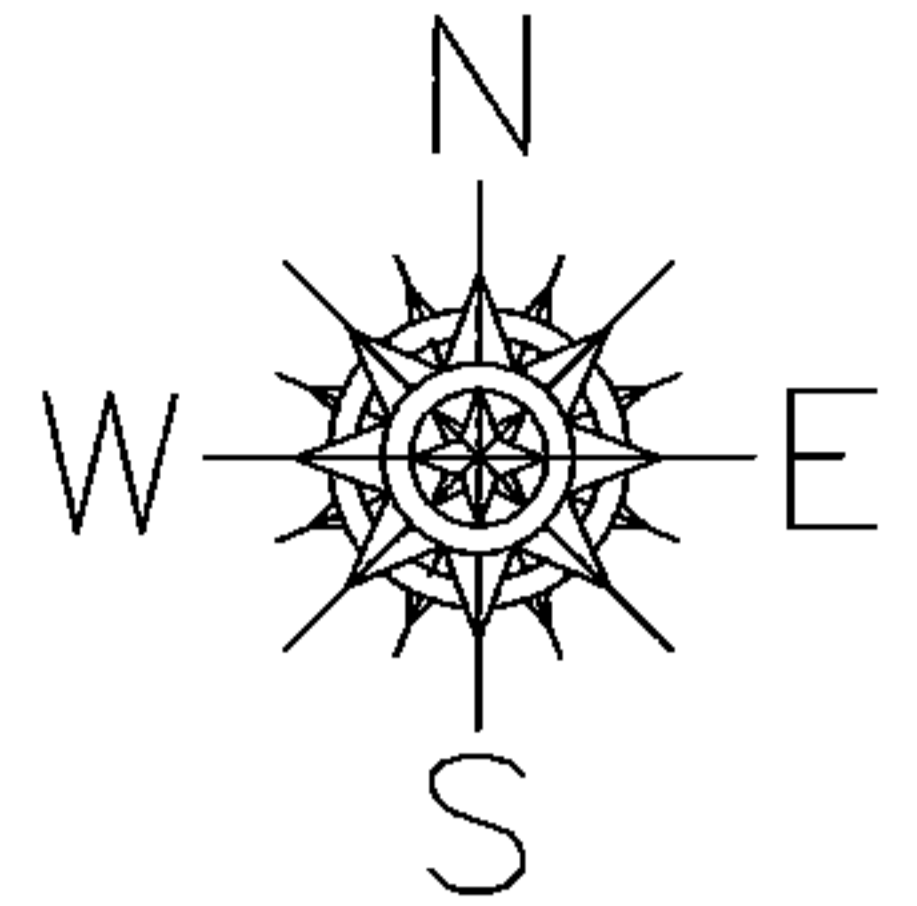

SPLITS/DEEDS PROCESSED

LORAIN COUNTY TAX MAP DEPARTMENT
226 MIDDLE AVE. ELYRIA, OHIO

SURVEYED BY: LAUNDON SIMON CAHL

CLOSURE: .01:10,000

MAP PAGE(S): 14-G

APPROVED BY: RRM DATE: 10-14-14

SCALE: 1"=150' PRIOR INST.: 20140507514