
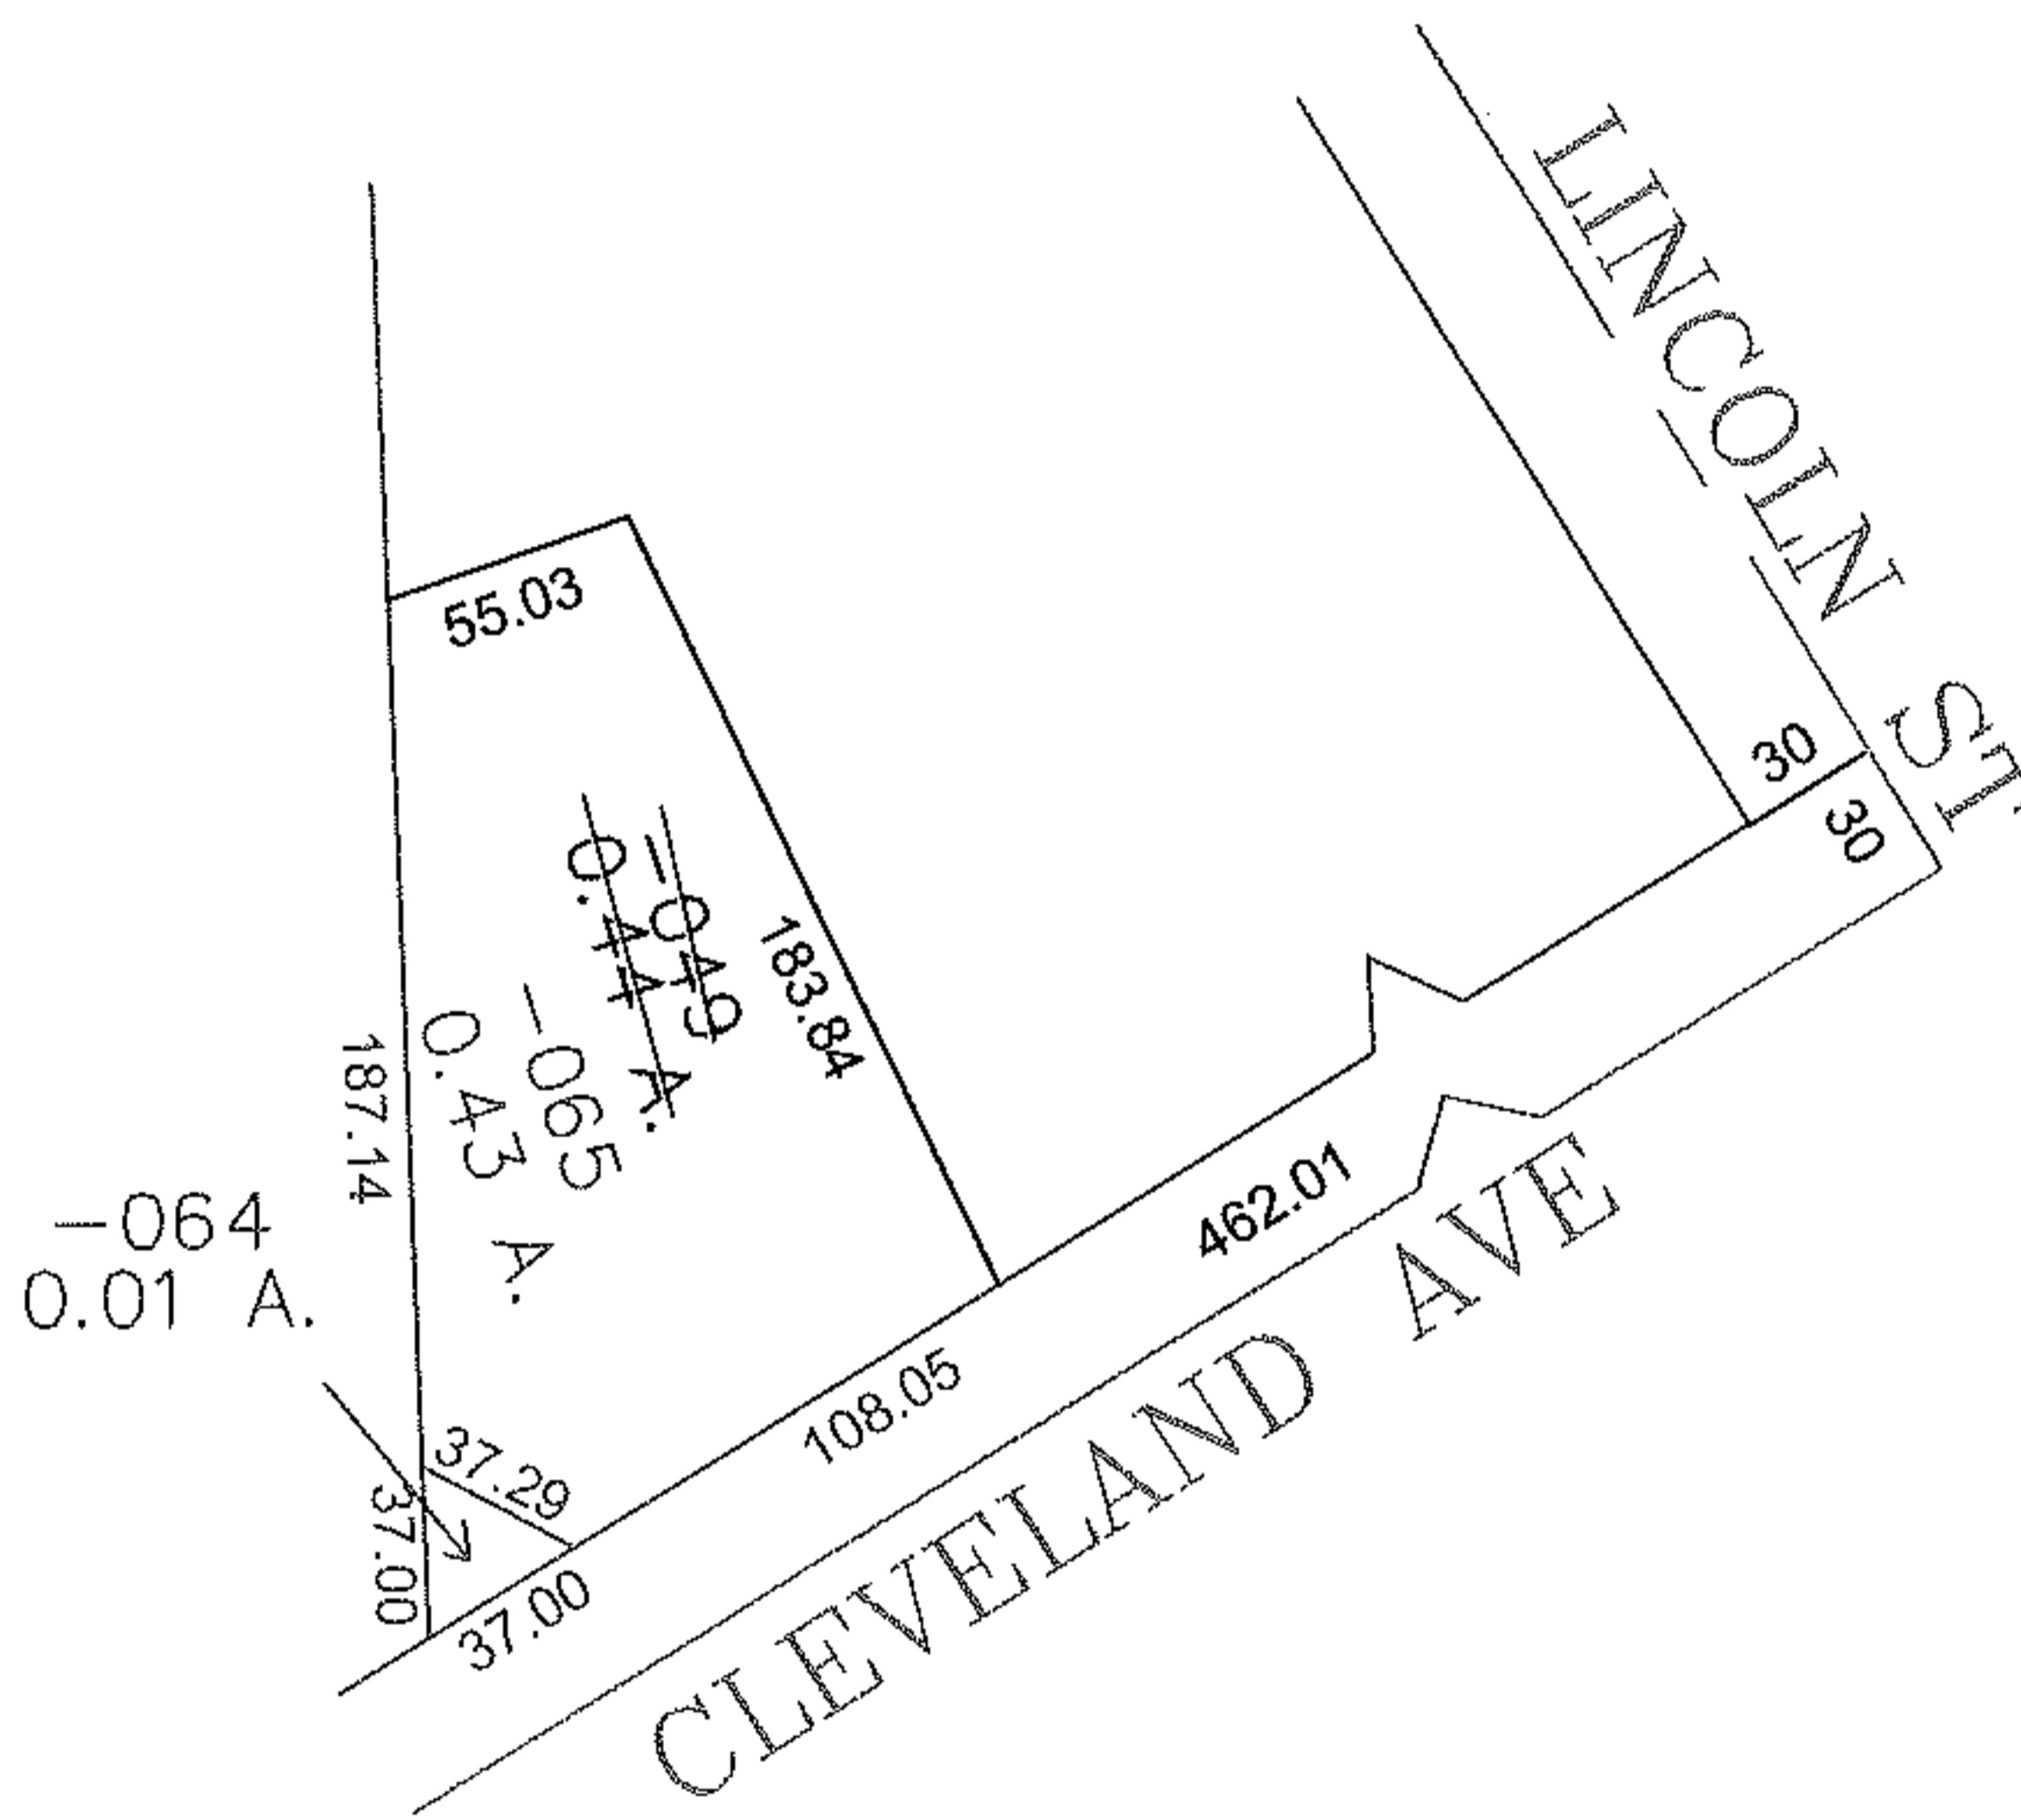


PARENT PARCEL: 05-00-023-110-049

CHILD PARCEL: 05-00-023-110-064, -065

STARTING POINT: CENTERLINE OF CLEVELAND AVE & LINCOLN ST

12-03045

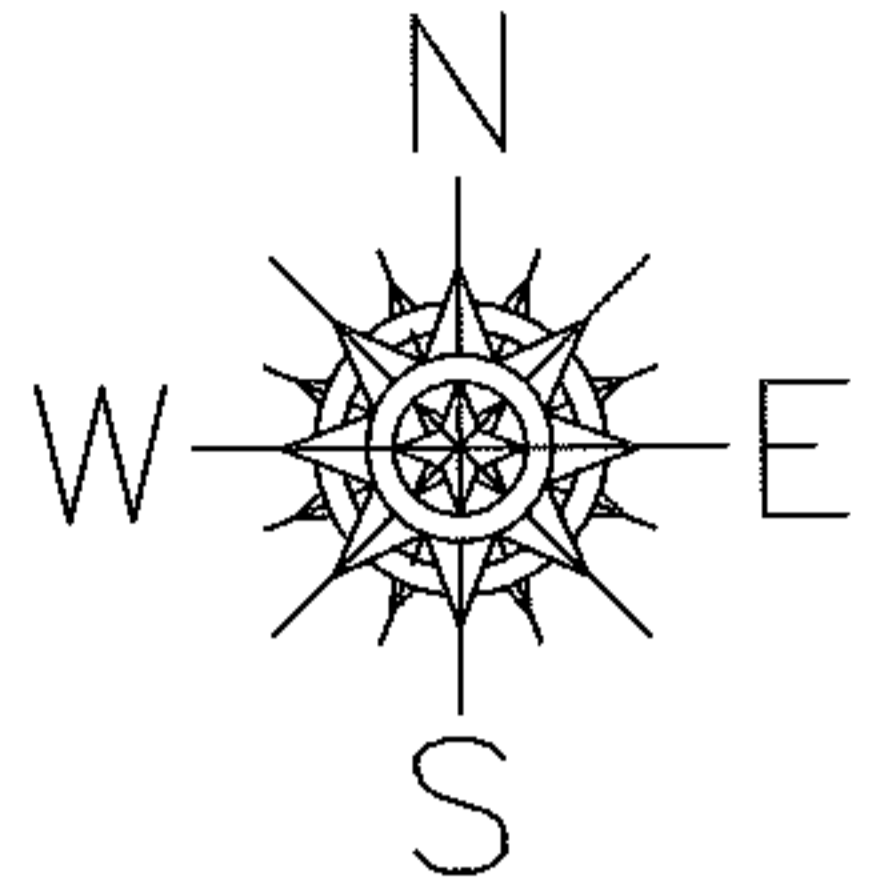

SPLITS/DEEDS PROCESSED

LORAIN COUNTY TAX MAP DEPARTMENT
226 MIDDLE AVE. ELYRIA, OHIO

SURVEYED BY: AMY M KELLY

CLOSURE: 0.00 : 10.000

MAP PAGE(S): 05-00-023-A

APPROVED BY: JAH DATE: 7-16-2012

SCALE: 1" = 100 PRIOR INSTRUMENT: 20110382579