

PARENT PARCEL: 04-00-030-103-020 & -021

CHILD PARCEL: XX-XX-XXX-XXX-XXX

STARTING POINT: INT. OF CL OF LAKE RD. & WEST LINE OF SECTION 30

14-03046-D

ACREAGE CORRECTION

04-00-030-103-020

~~100 X 261.50~~

100.00 X 380.00

CORR. PER DEED

OR 1090/450

&




04-00-030-103-021

~~109.56 X 326.87~~

100.00 X 380.00

CORR. PER DEED

OR 389/539

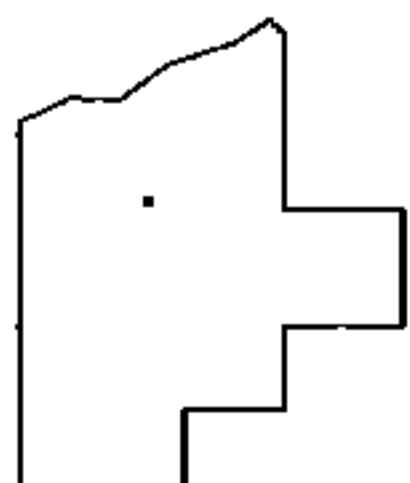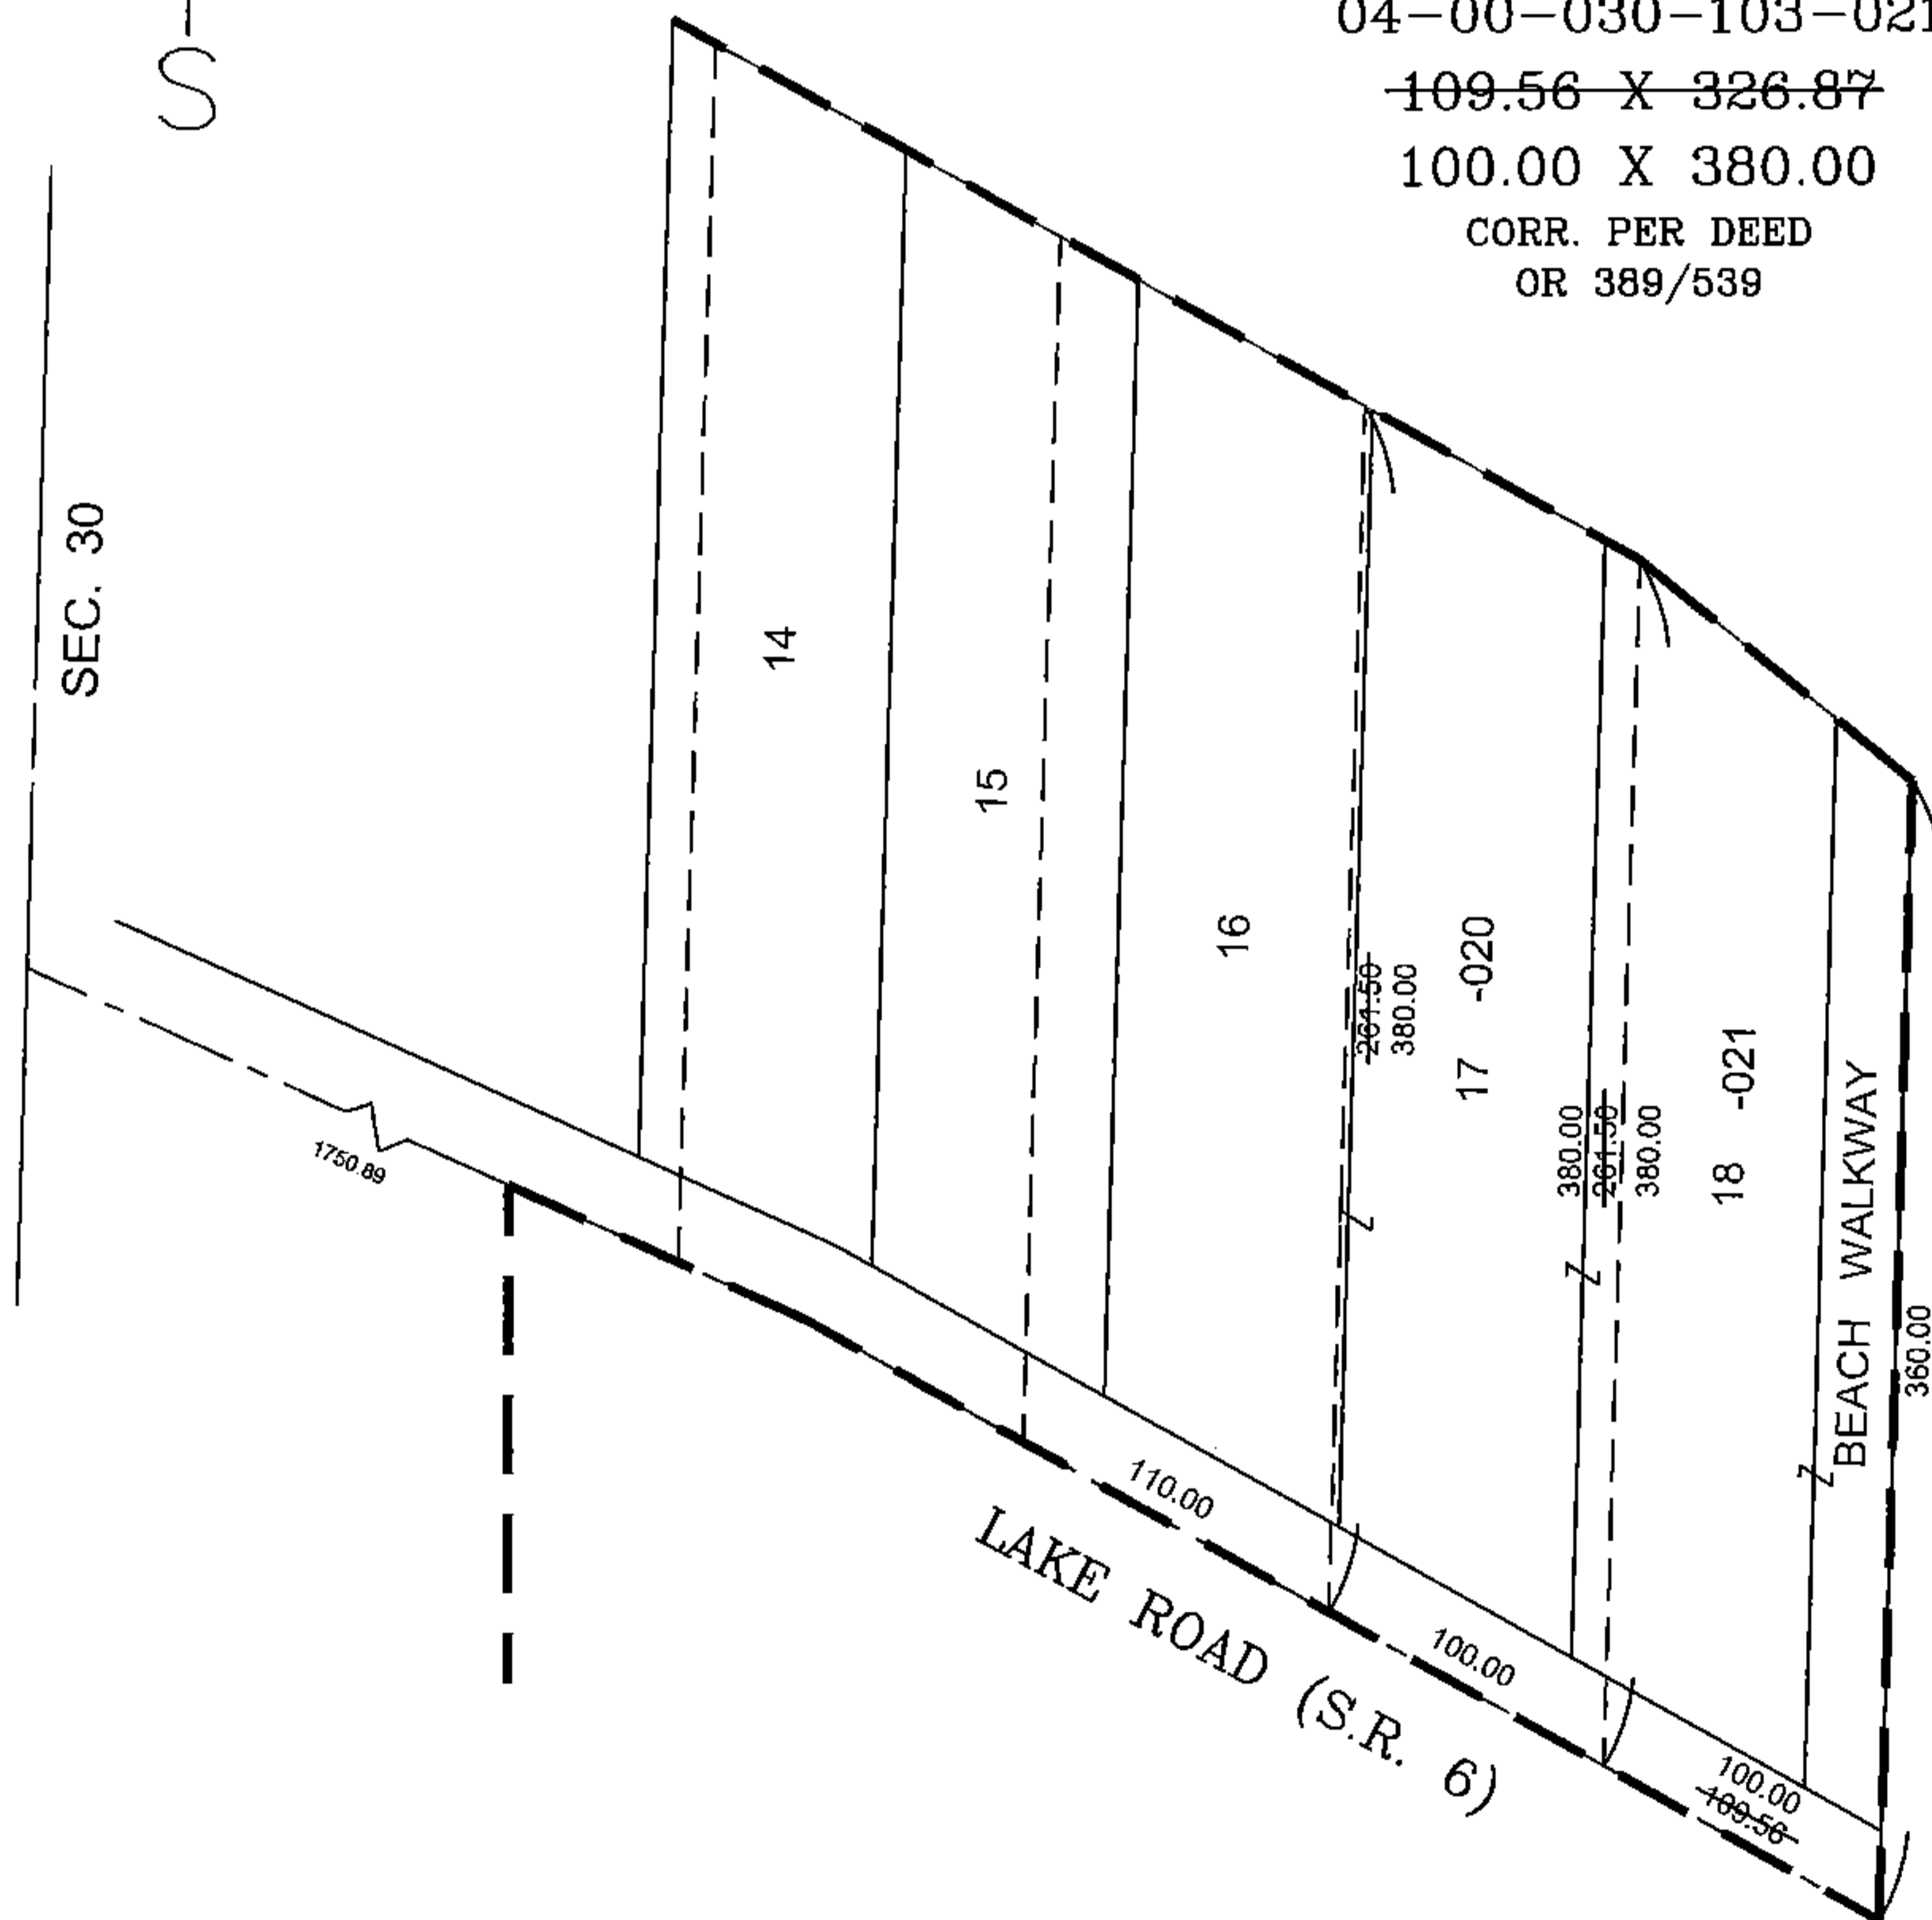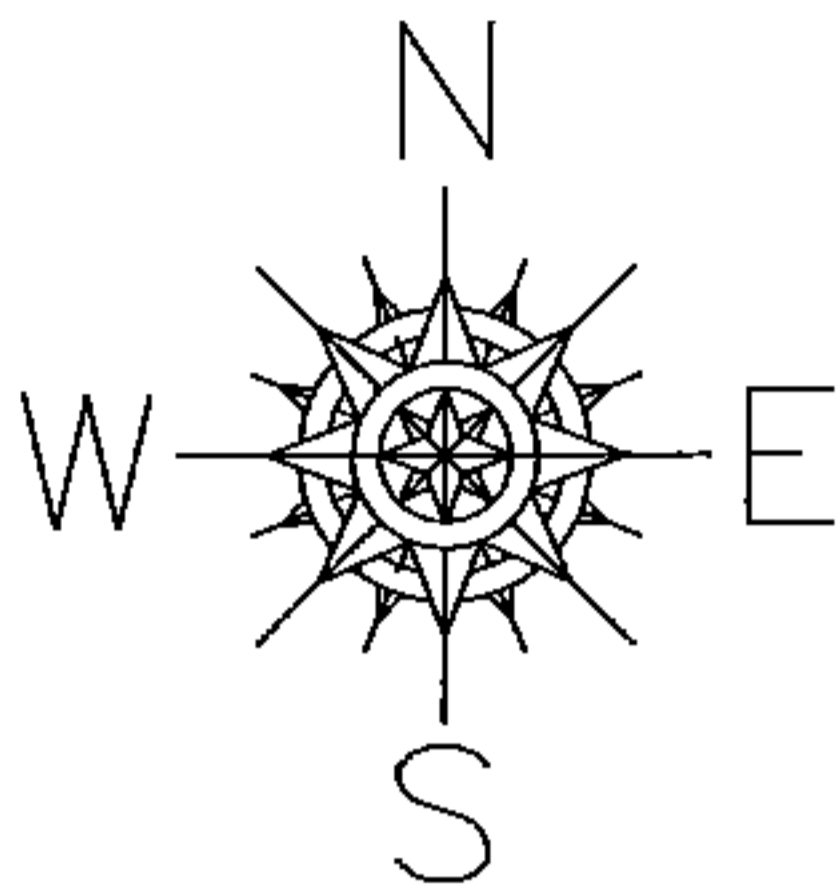

SPLITS/DEEDS PROCESSED

LORAIN COUNTY TAX MAP DEPARTMENT
226 MIDDLE AVE. ELYRIA, OHIO

SURVEYED BY: NA

CLOSURE: 0.01 : 10,000

MAP PAGE(S): 04-00-030

APPROVED BY: TJS DATE: 10/28/14

SCALE: 1" = 100 PRIOR INSTRUMENT: