

PARENT PARCEL: 12-00-040-102-009 & -010

CHILD PARCEL: 12-00-040-102-016 & -017

STARTING POINT: CL OF COLUMBIA WEST RIVER RD. & SOUTH LINE OF O.L. 40

12-03046

SPLIT

~~12-00-040-102-009~~

~~9.30 A.~~

~~12-00-040-102-010~~

~~0.73 A.~~

12-00-040-102-016

1.26 A.

12-00-040-102-017

~~6.77 A.~~

4.32 A.



CORR. PER SURV.
SUSAN L. EICHHORN

SURVEY BEFORE NEXT TRANSFER

12-00-042-000-060

7.97 A.

SHOULD HAVE BEEN SURVEYED
WITH THIS SPLIT

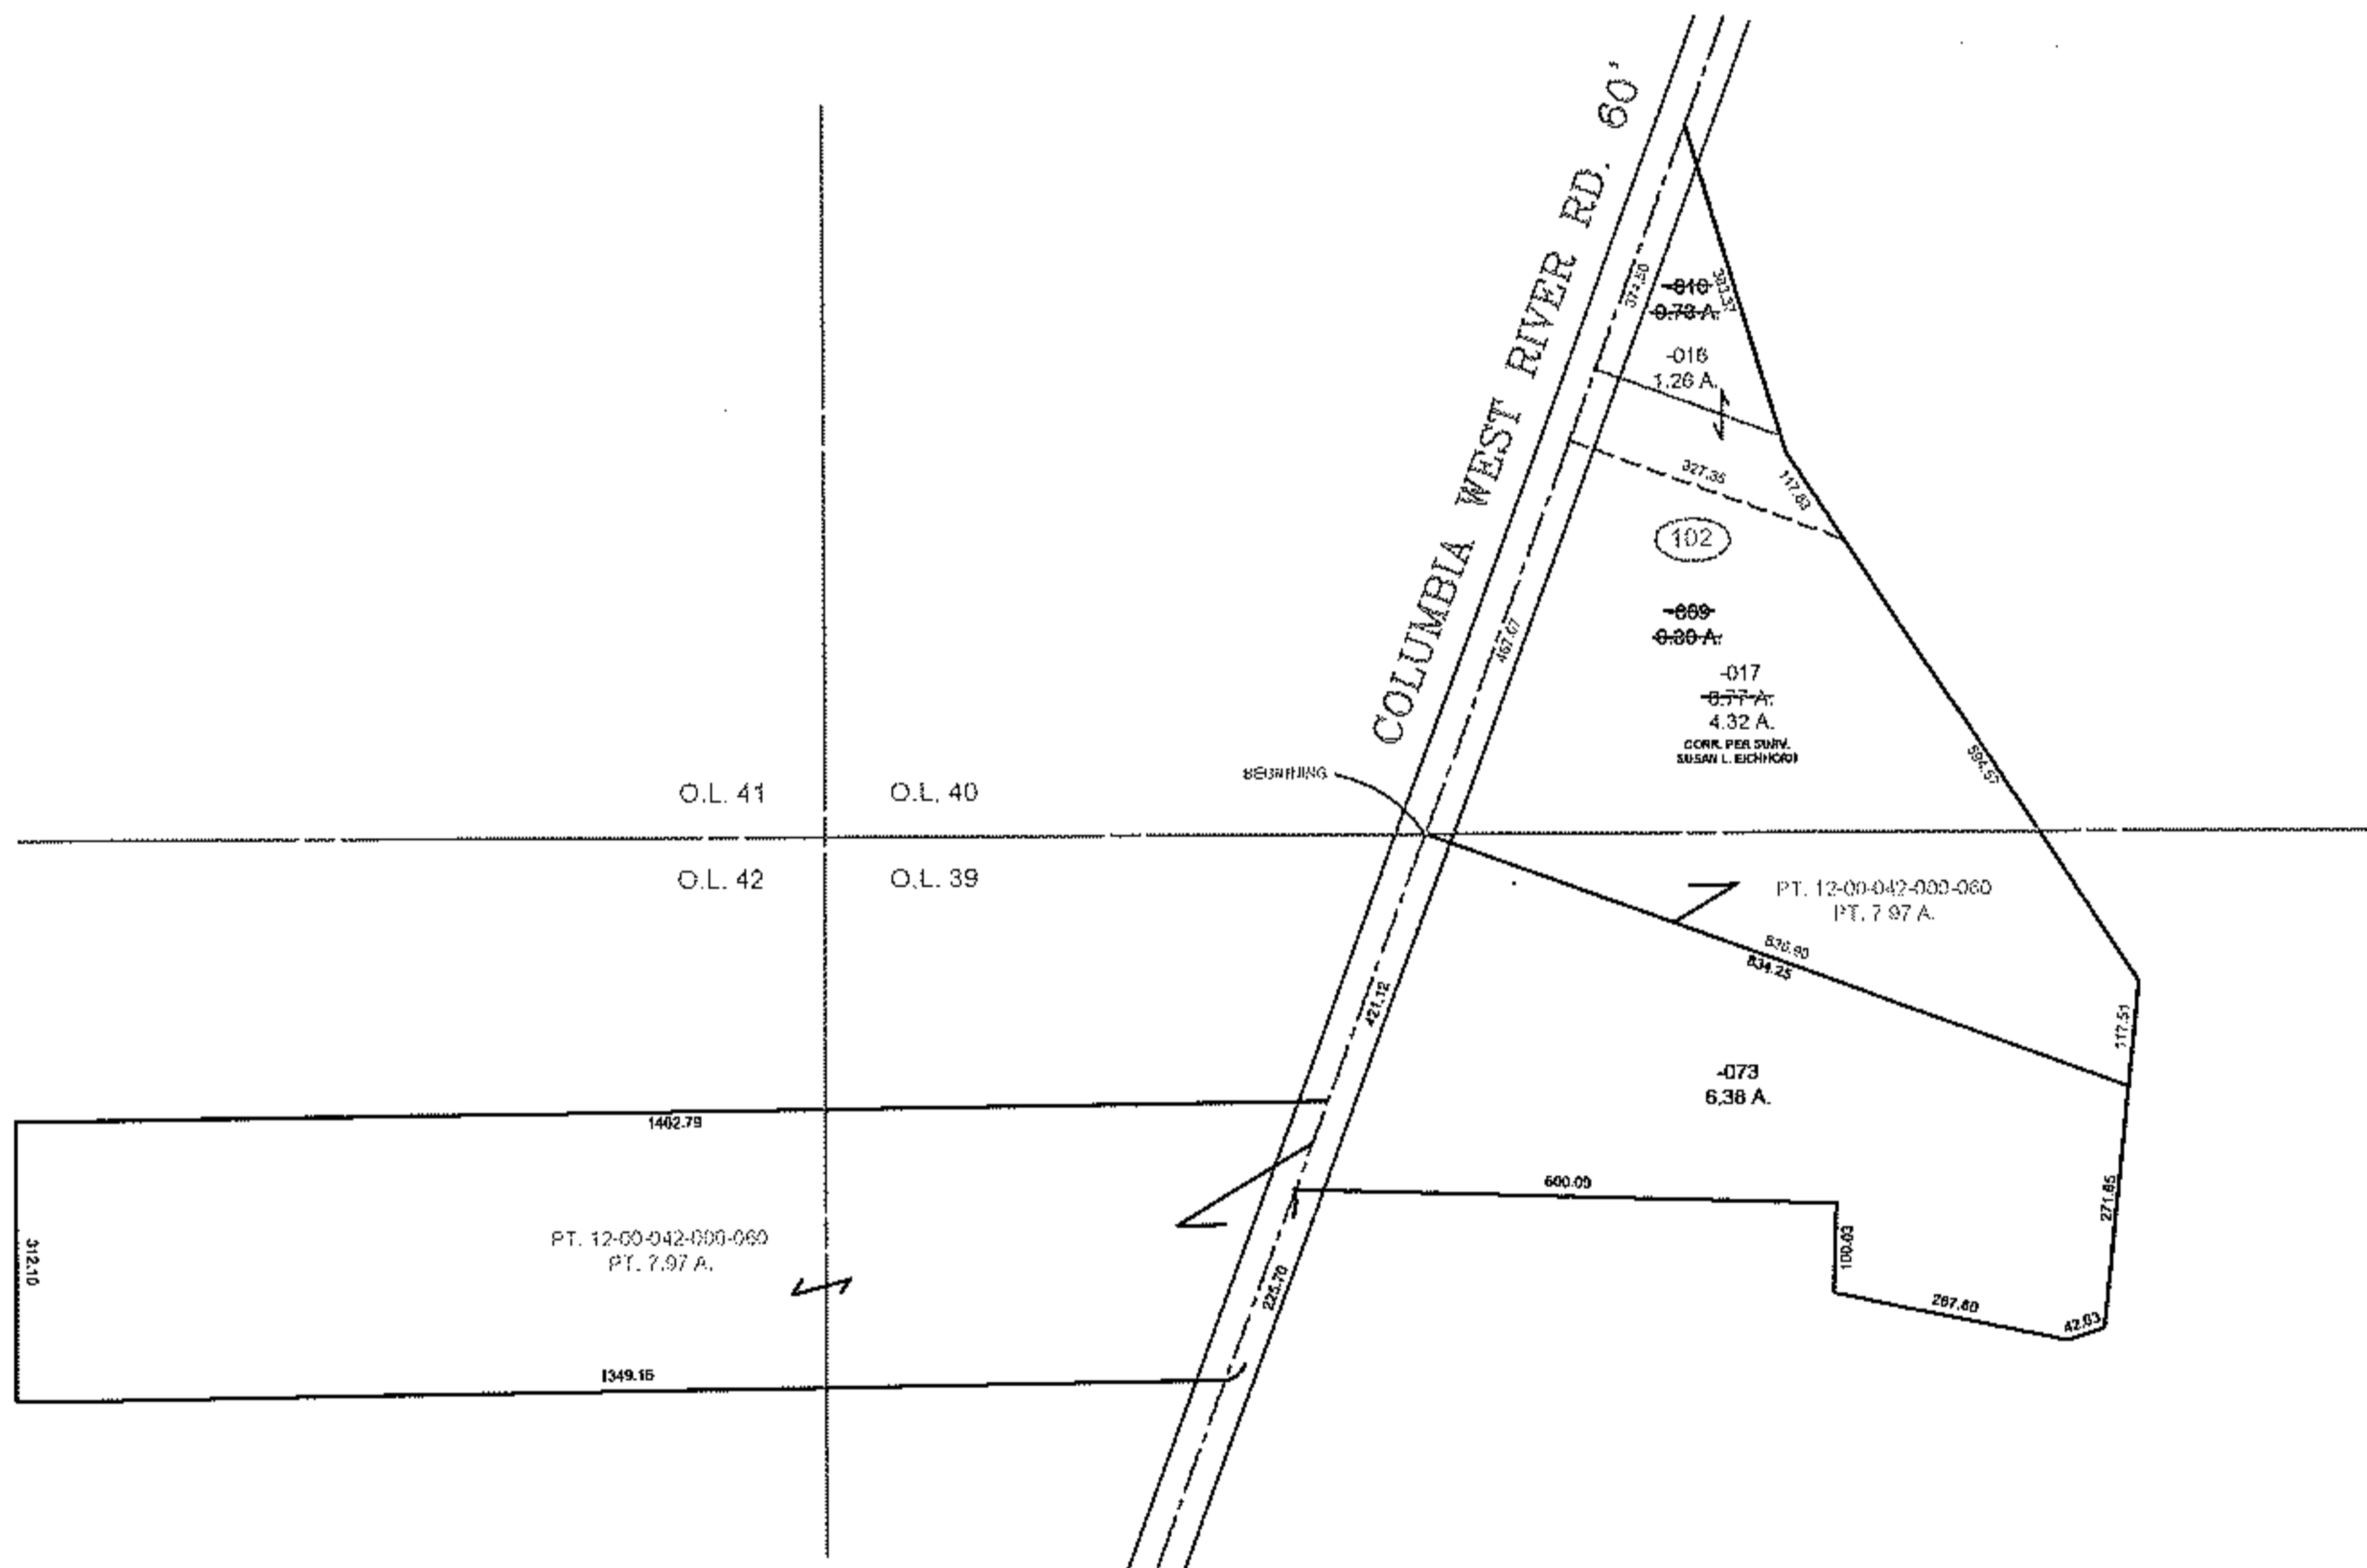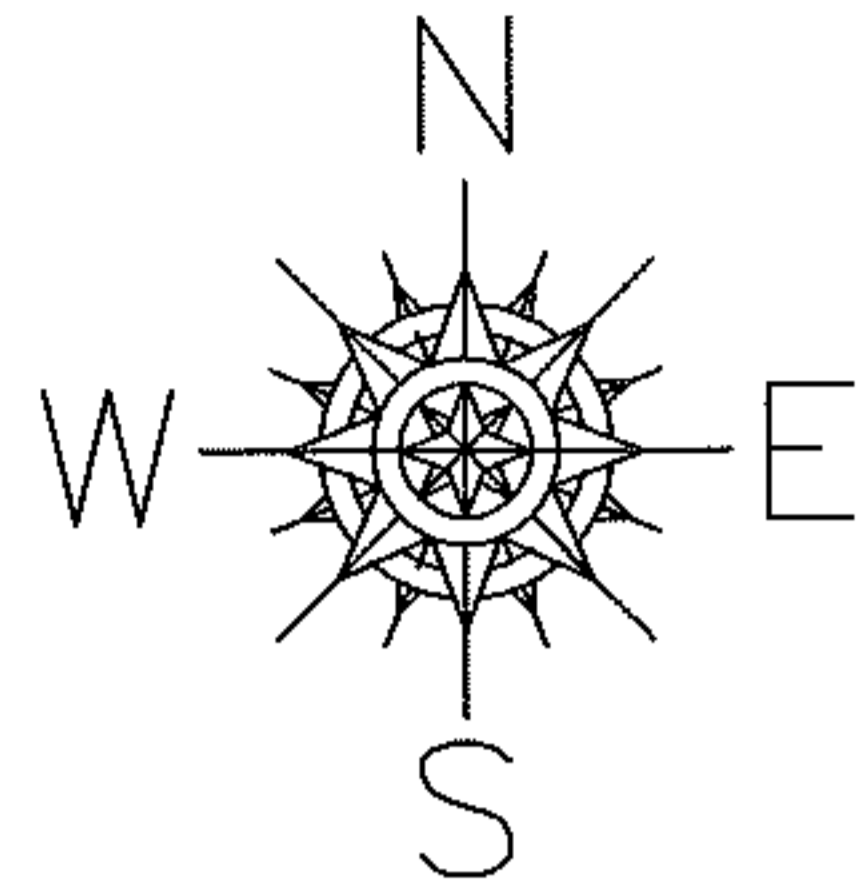

SPLITS/DEEDS PROCESSED

LORAIN COUNTY TAX MAP DEPARTMENT
226 MIDDLE AVE. ELYRIA, OHIO

SURVEYED BY: SUSAN L. EICHHORN

CLOSURE: 0.01 : 10.000

MAP PAGE(S): 12-00-040-A

APPROVED BY: TJS DATE: 7/25/12

SCALE: 1" = 400 PRIOR INSTRUMENT: 20070207889