


PARENT PARCEL: 09-00-001-102-059 & -061

CHILD PARCEL: XX-XX-XXX-XXX-XXX

STARTING POINT: XXXXXX

14-03047-C

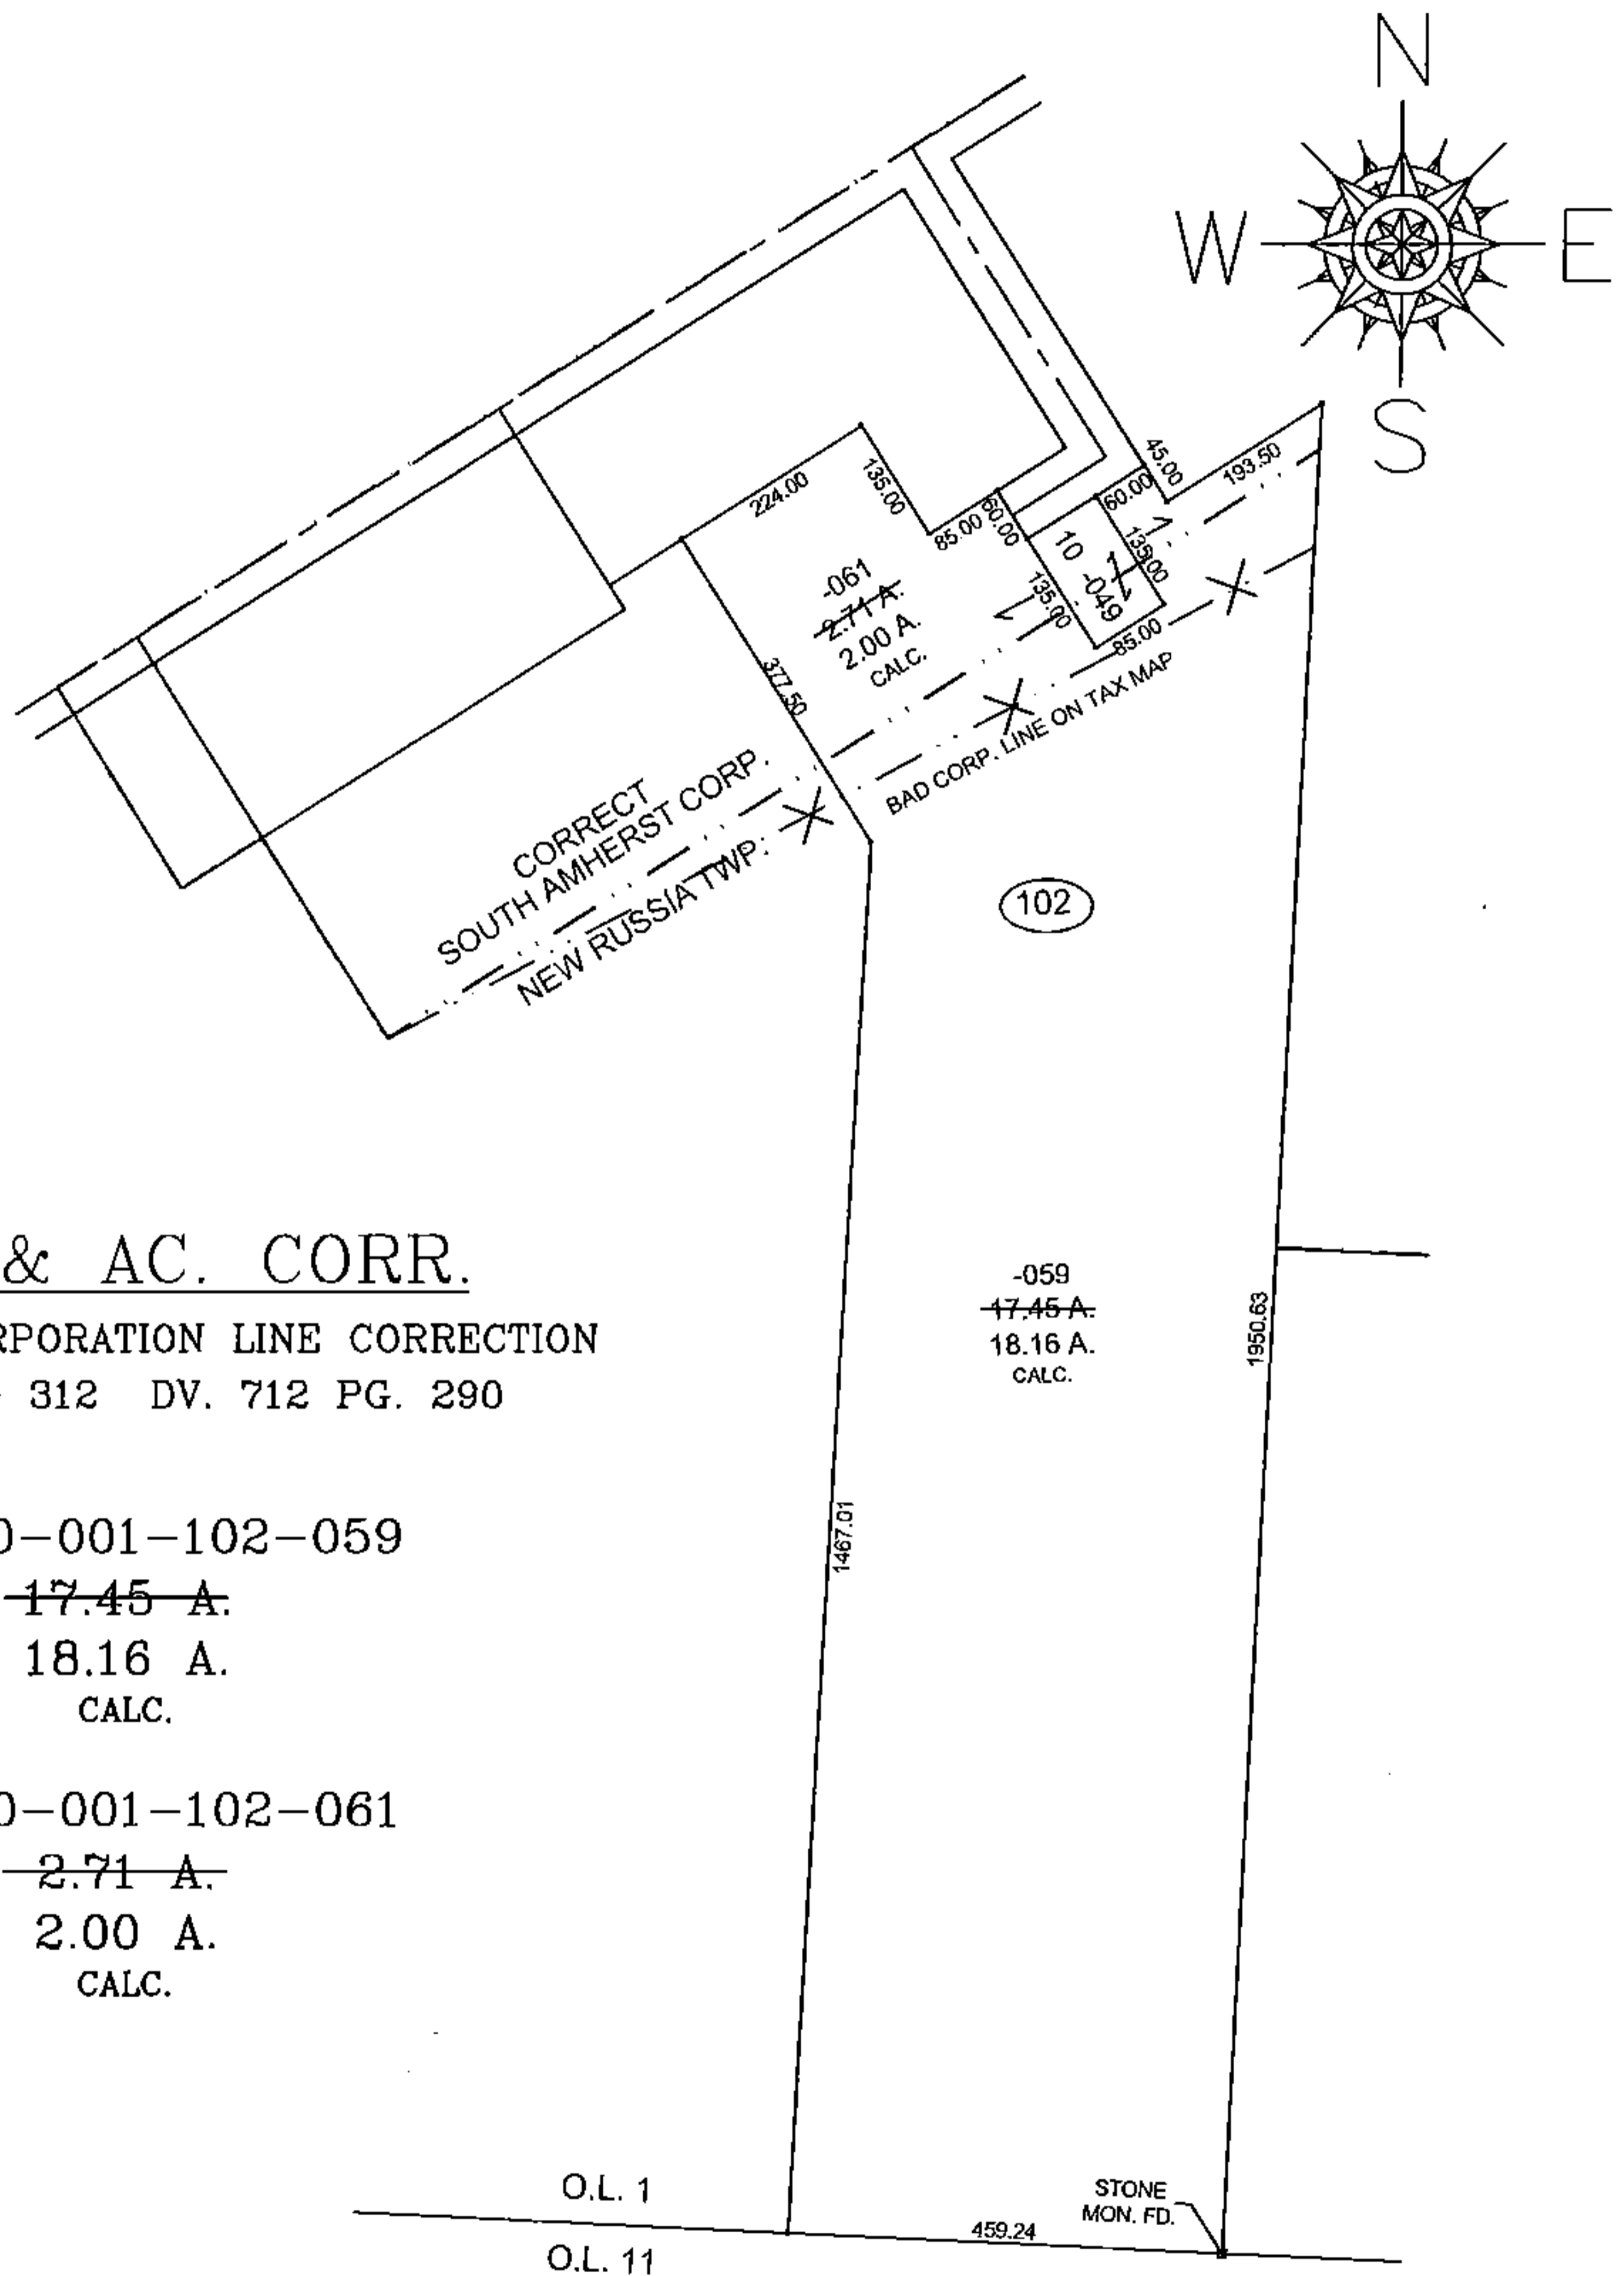

MAP & AC. CORR.

S. AMHERST CORPORATION LINE CORRECTION
PER ORD. # 312 DV. 712 PG. 290

09-00-001-102-059

~~17.45 A.~~
18.16 A.
CALC.


09-00-001-102-061

~~2.71 A.~~
2.00 A.
CALC.

O.L. 1

O.L. 11

STONE
MON. FD.

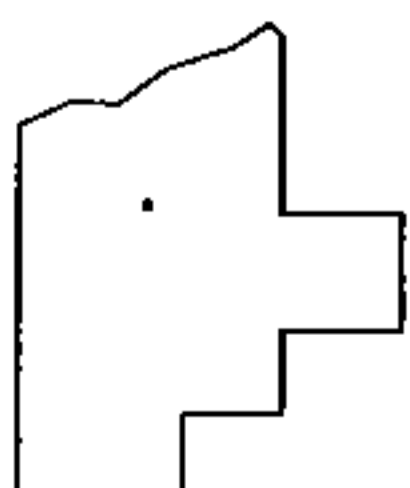

SPLITS/DEEDS PROCESSED

LORAIN COUNTY TAX MAP DEPARTMENT
226 MIDDLE AVE. ELYRIA, OHIO

SURVEYED BY: CHARLES P. WARYU

CLOSURE: 1:12,000

MAP PAGE(S): 09-00-001

APPROVED BY: TJS DATE: 10/22/14

SCALE: 1"=300 PRIOR INST.: DV XXXX/XXX