


PARENT PARCEL: 12-00-096-000-004

CHILD PARCEL: 12-00-096-000-057, -058

STARTING POINT: CENTERLINE OF HAWKE RD & ELYRIA-TWINSBURG RD

12-03050

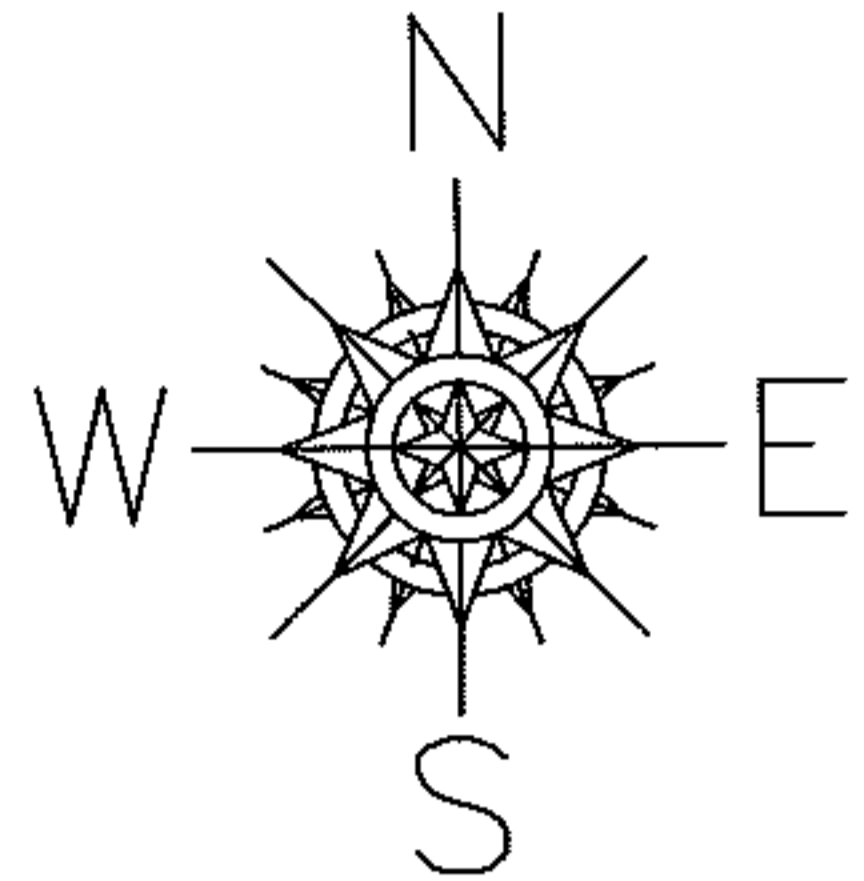

RD

~~-004~~
~~22.25 A.~~
-058
20.25 A.

-005
1.00 A.

580.80
-057
2.00 A.
580.80

150.00

150.00

939.45

HAWKE

ELYRIA-TWINSBURG RD

SPLITS/DEEDS PROCESSED

LORAIN COUNTY TAX MAP DEPARTMENT
226 MIDDLE AVE. ELYRIA, OHIO

SURVEYED BY: PETER ZWICK
CLOSURE: 0.00 : 10,000
MAP PAGE(S): 12-A
APPROVED BY: JAH DATE: 7/30/2012
SCALE: 1" = 100' PRIOR INSTRUMENT: 19990602073