


PARENT PARCEL: 09-00-054-000-037


14-03051-C

CHILD PARCEL: _____

STARTING POINT: AT A MON BOX AT THE INTERSECTION OF C/L OF PYLE SOUTH AMHERST RD. AND C/L OF BUTTERNUT RIDGE RD.

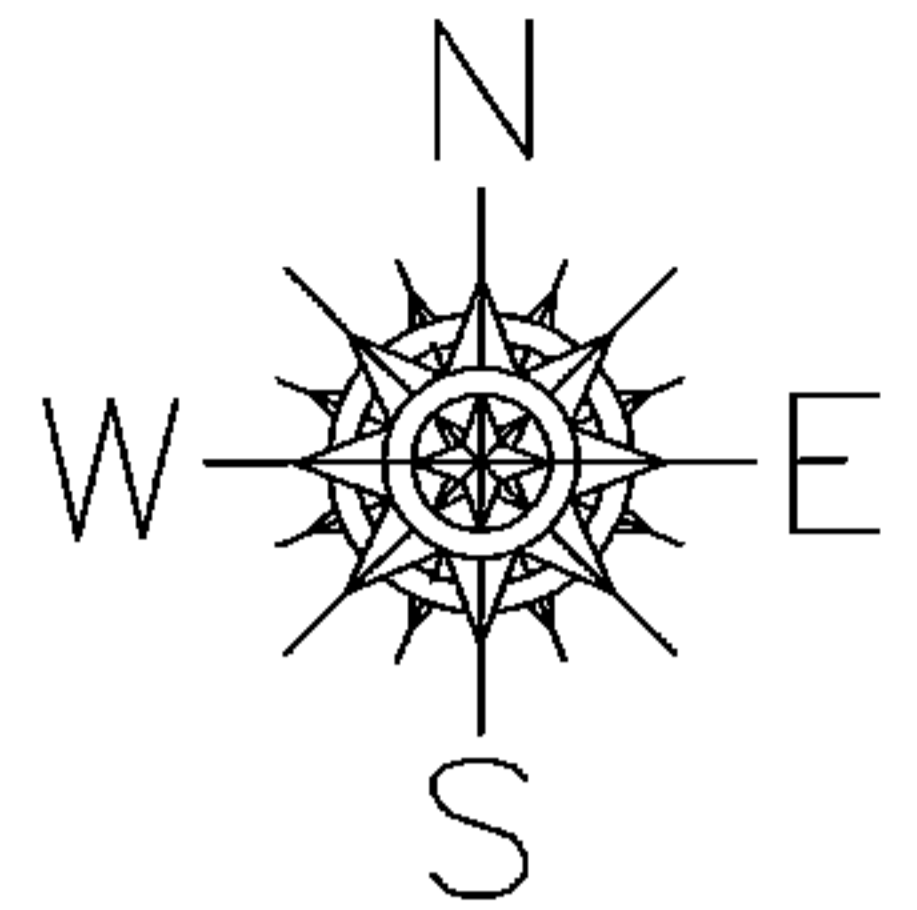


PYLE SOUTH AMHERST RD.

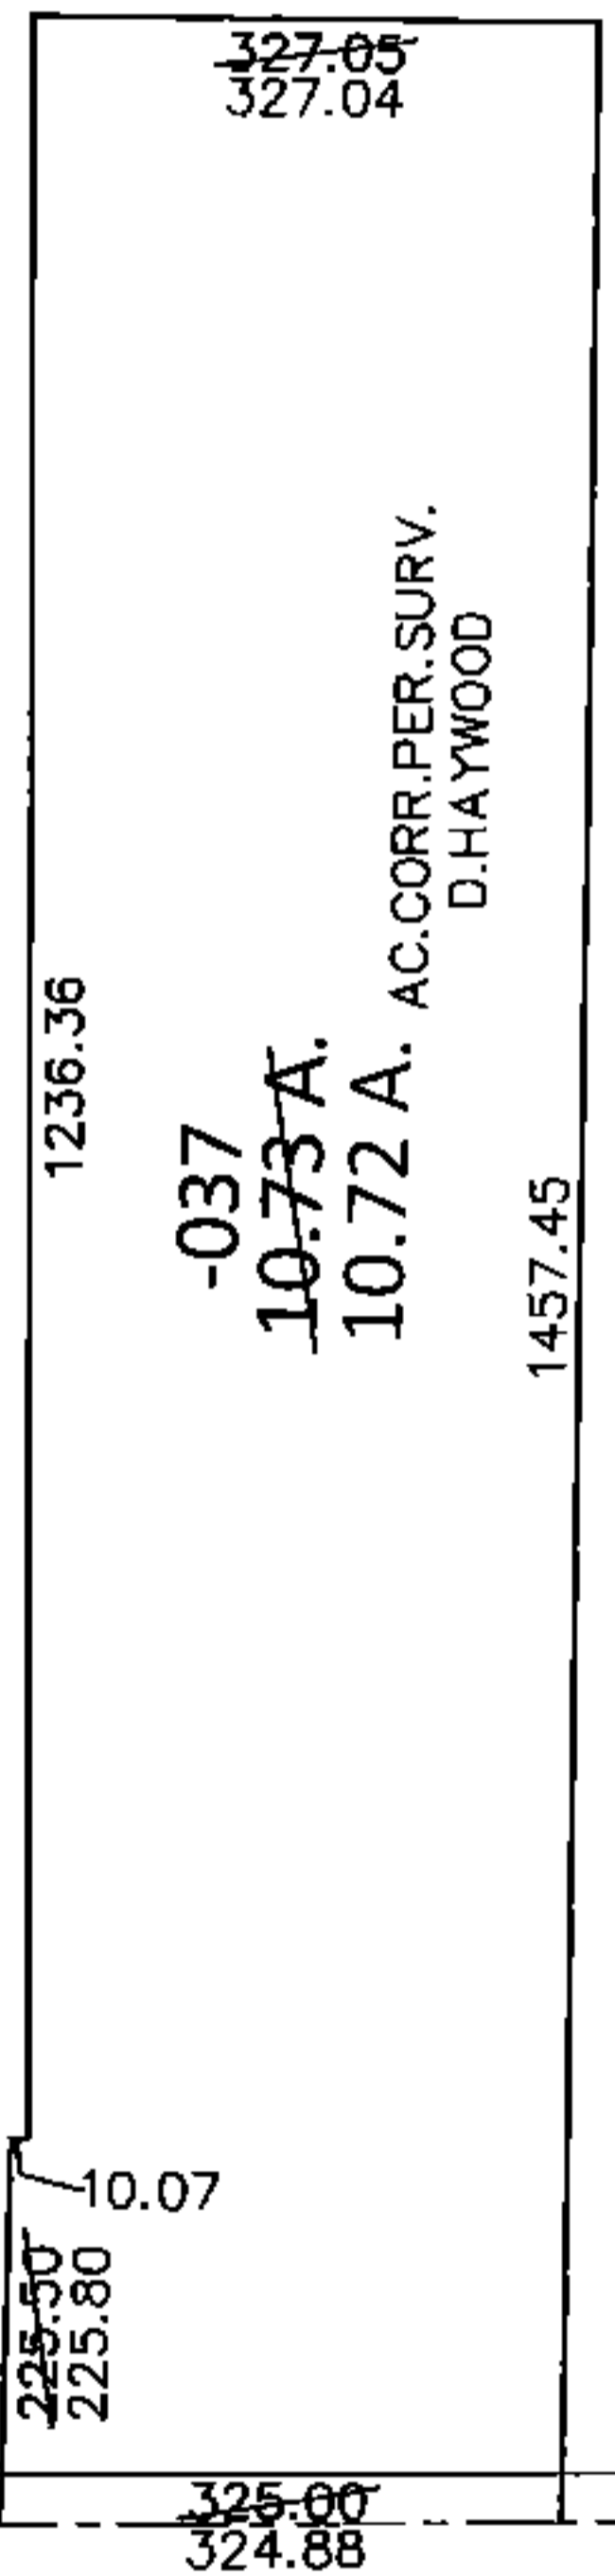

1826.29

BUTTERNUT RIDGE RD.

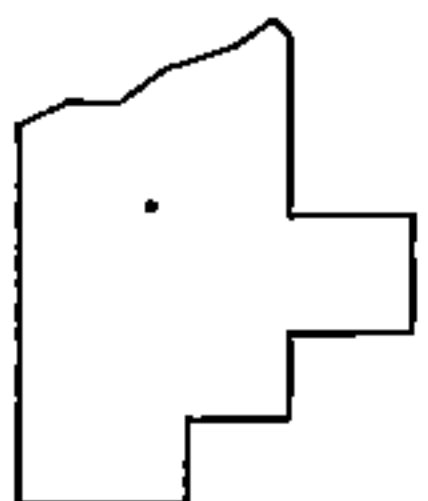

SPLITS/DEEDS PROCESSED

LORAIN COUNTY TAX MAP DEPARTMENT
226 MIDDLE AVE. ELYRIA, OHIO

SURVEYED BY: DALE R. HAYWOOD

CLOSURE: .01:10,000

MAP PAGE(S): 9-F

APPROVED BY: RRM DATE: 10-29-14

SCALE: 1"= 300 PRIOR INST.: OR 123/402