
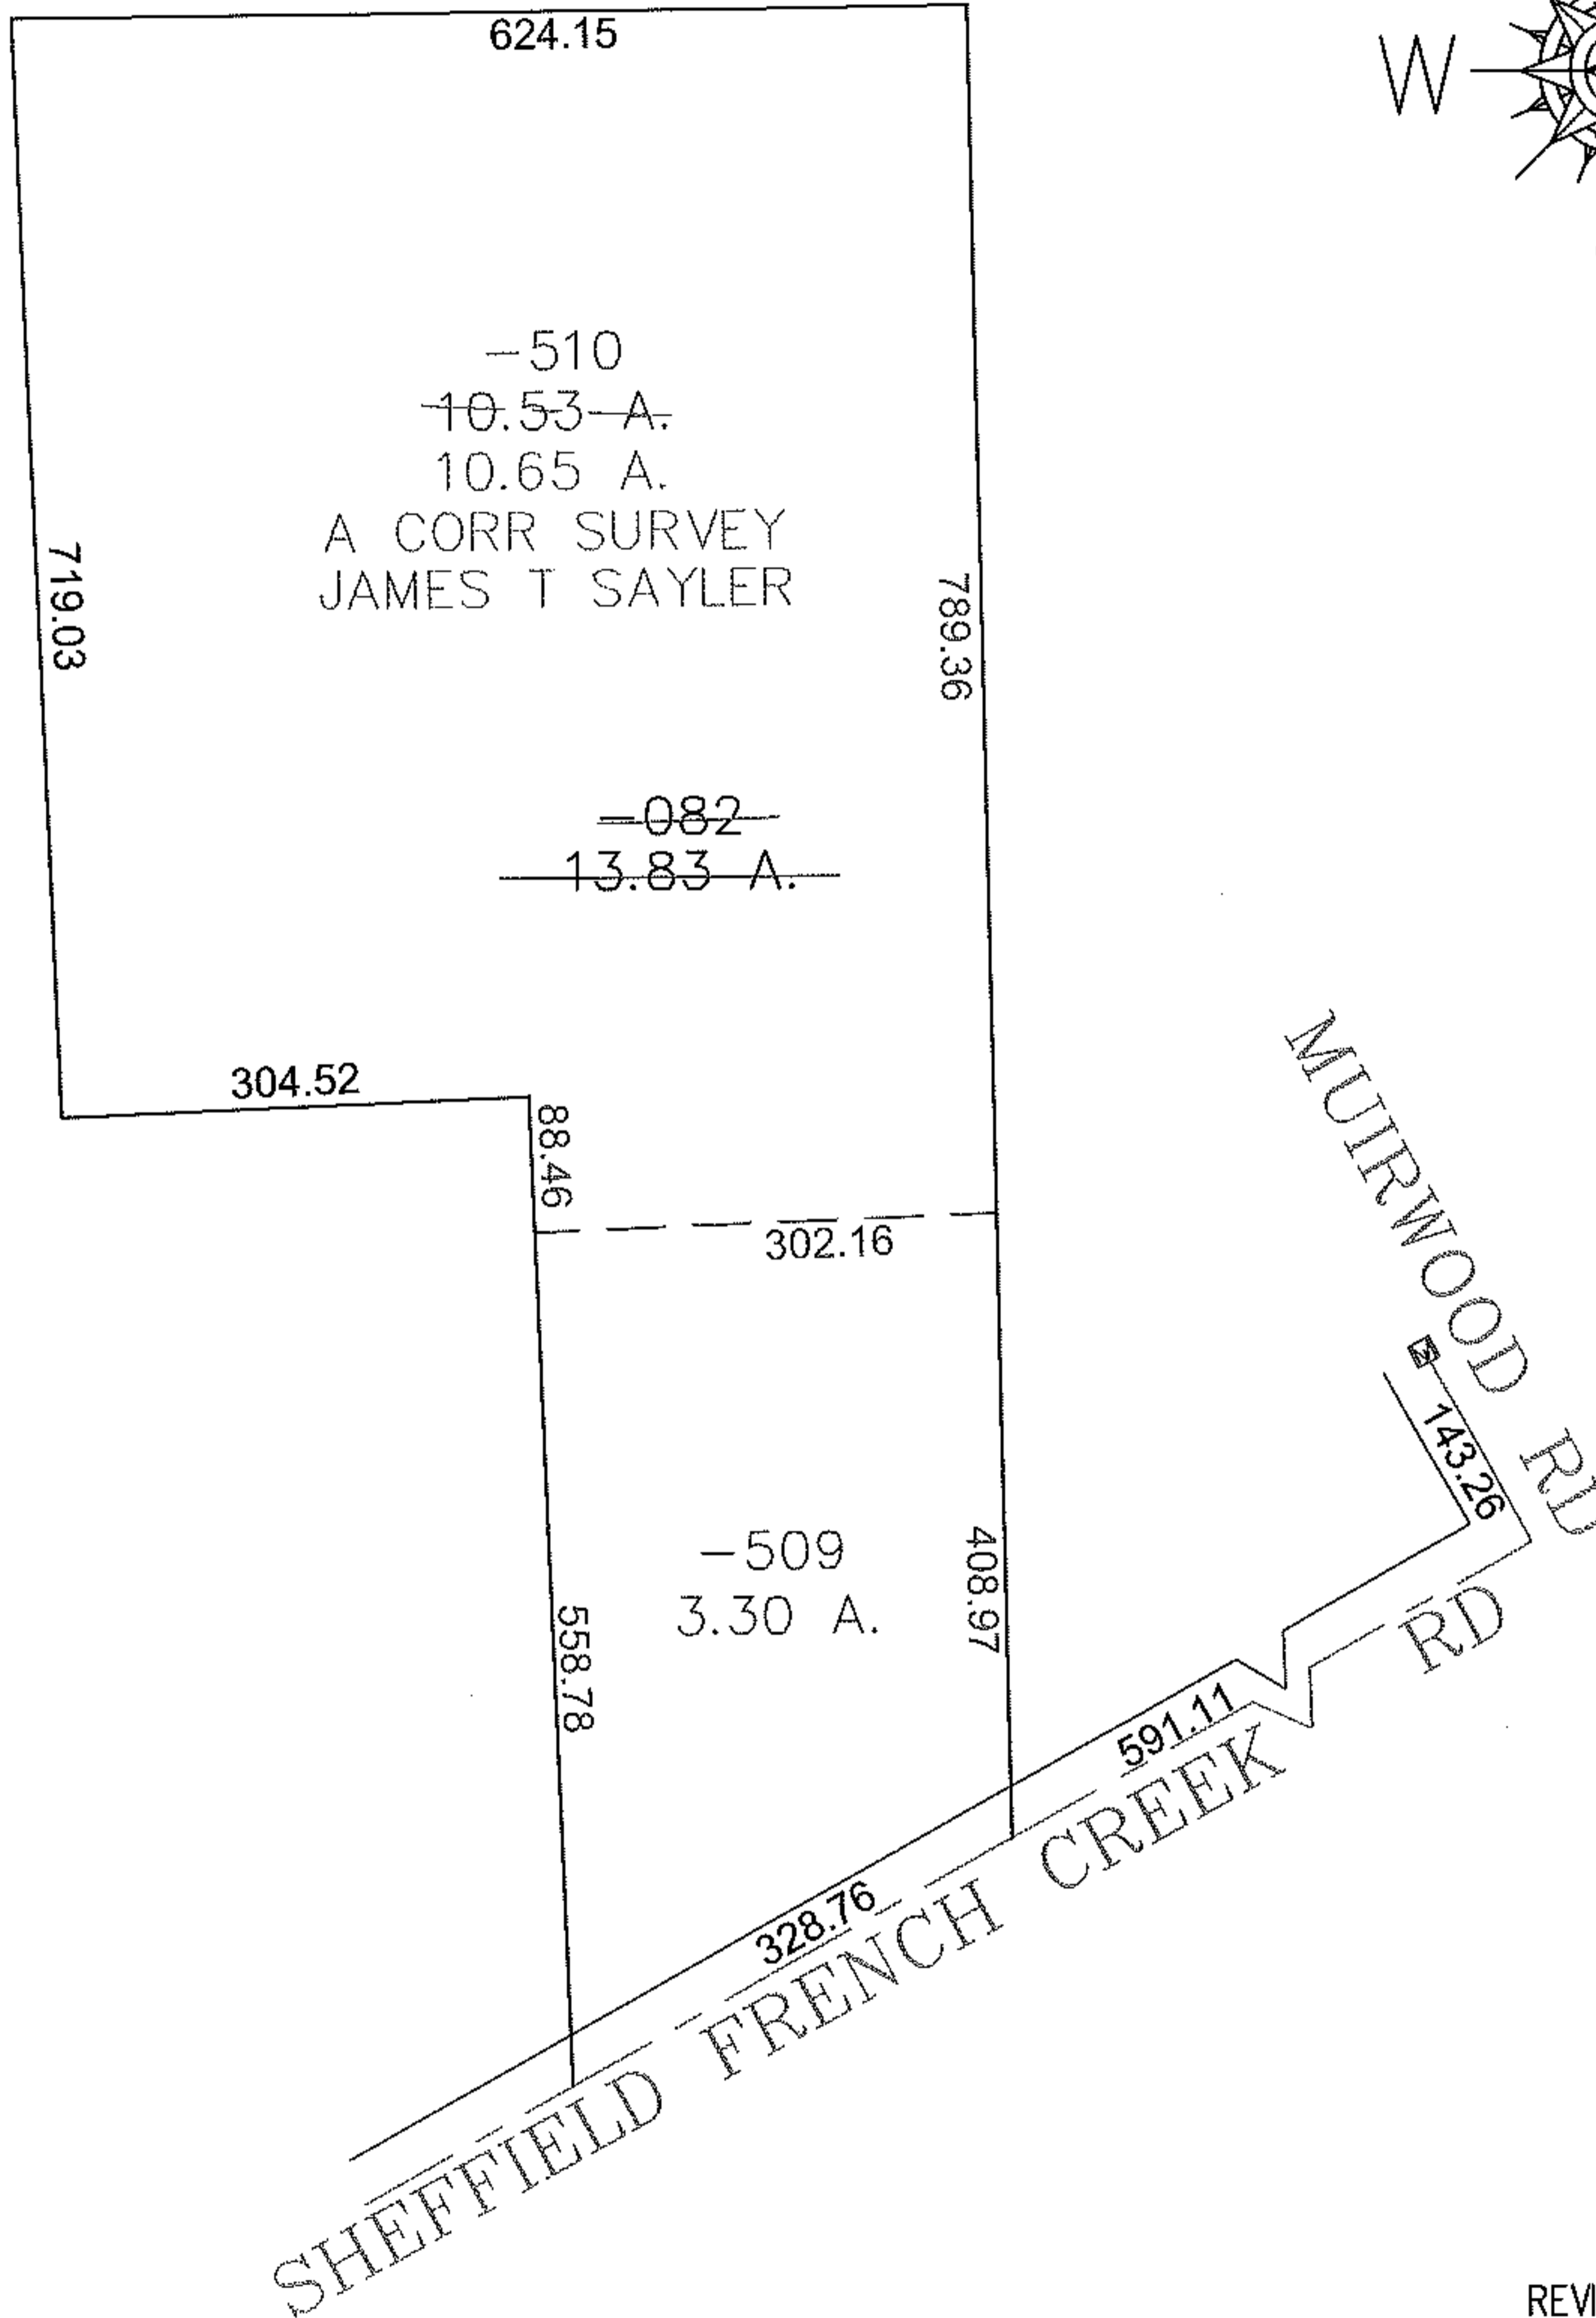


PARENT PARCEL: 04-00-003-101-082


CHILD PARCEL: 04-00-003-101-509, -510

12-03051

STARTING POINT: MONUMENT BOX ON MURIWOOD RD 143.26 FT FROM INTERSECTION
OF SHEFFIELD FRENCH CREEK RD

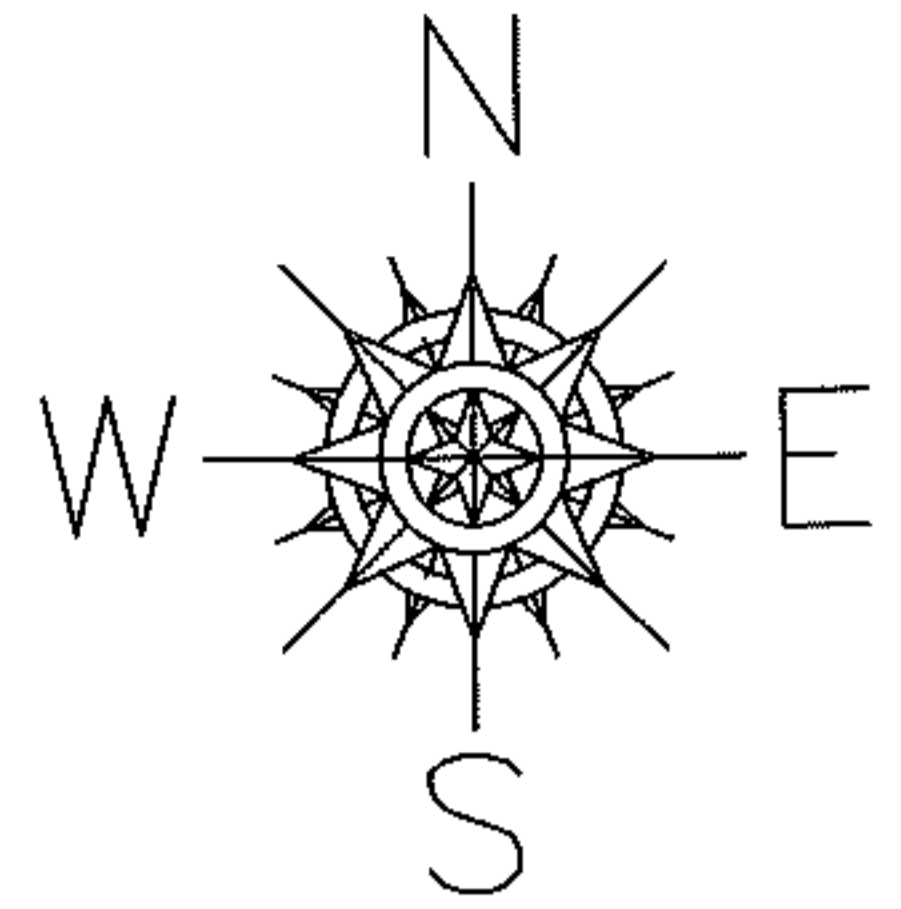

REVISED 9-26-12

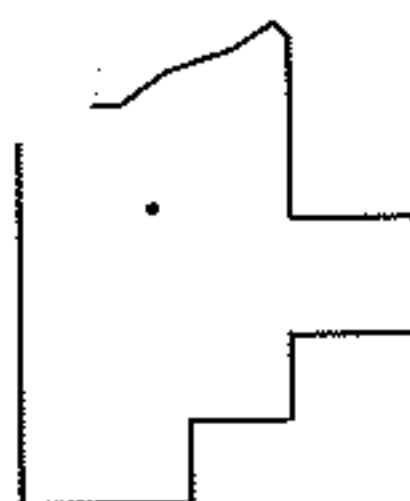

SPLITS/DEEDS PROCESSED
LORAIN COUNTY TAX MAP DEPARTMENT
226 MIDDLE AVE. ELYRIA, OHIO

SURVEYED BY:	JAMES T SAYLER
CLOSURE:	0.00 : 10,000
MAP PAGE(S):	04-00-003-G
APPROVED BY:	JAH DATE: 8-2-2012
SCALE:	1" = 200 PRIOR INSTRUMENT: 20100343998