
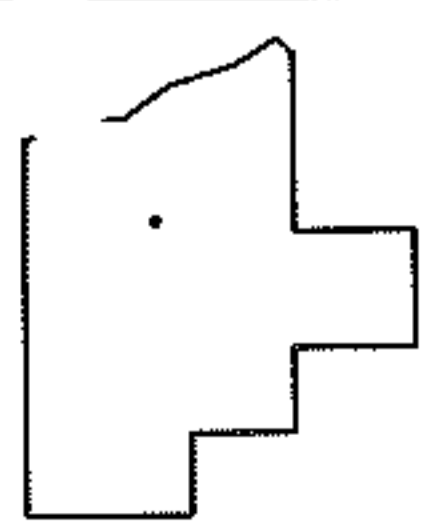
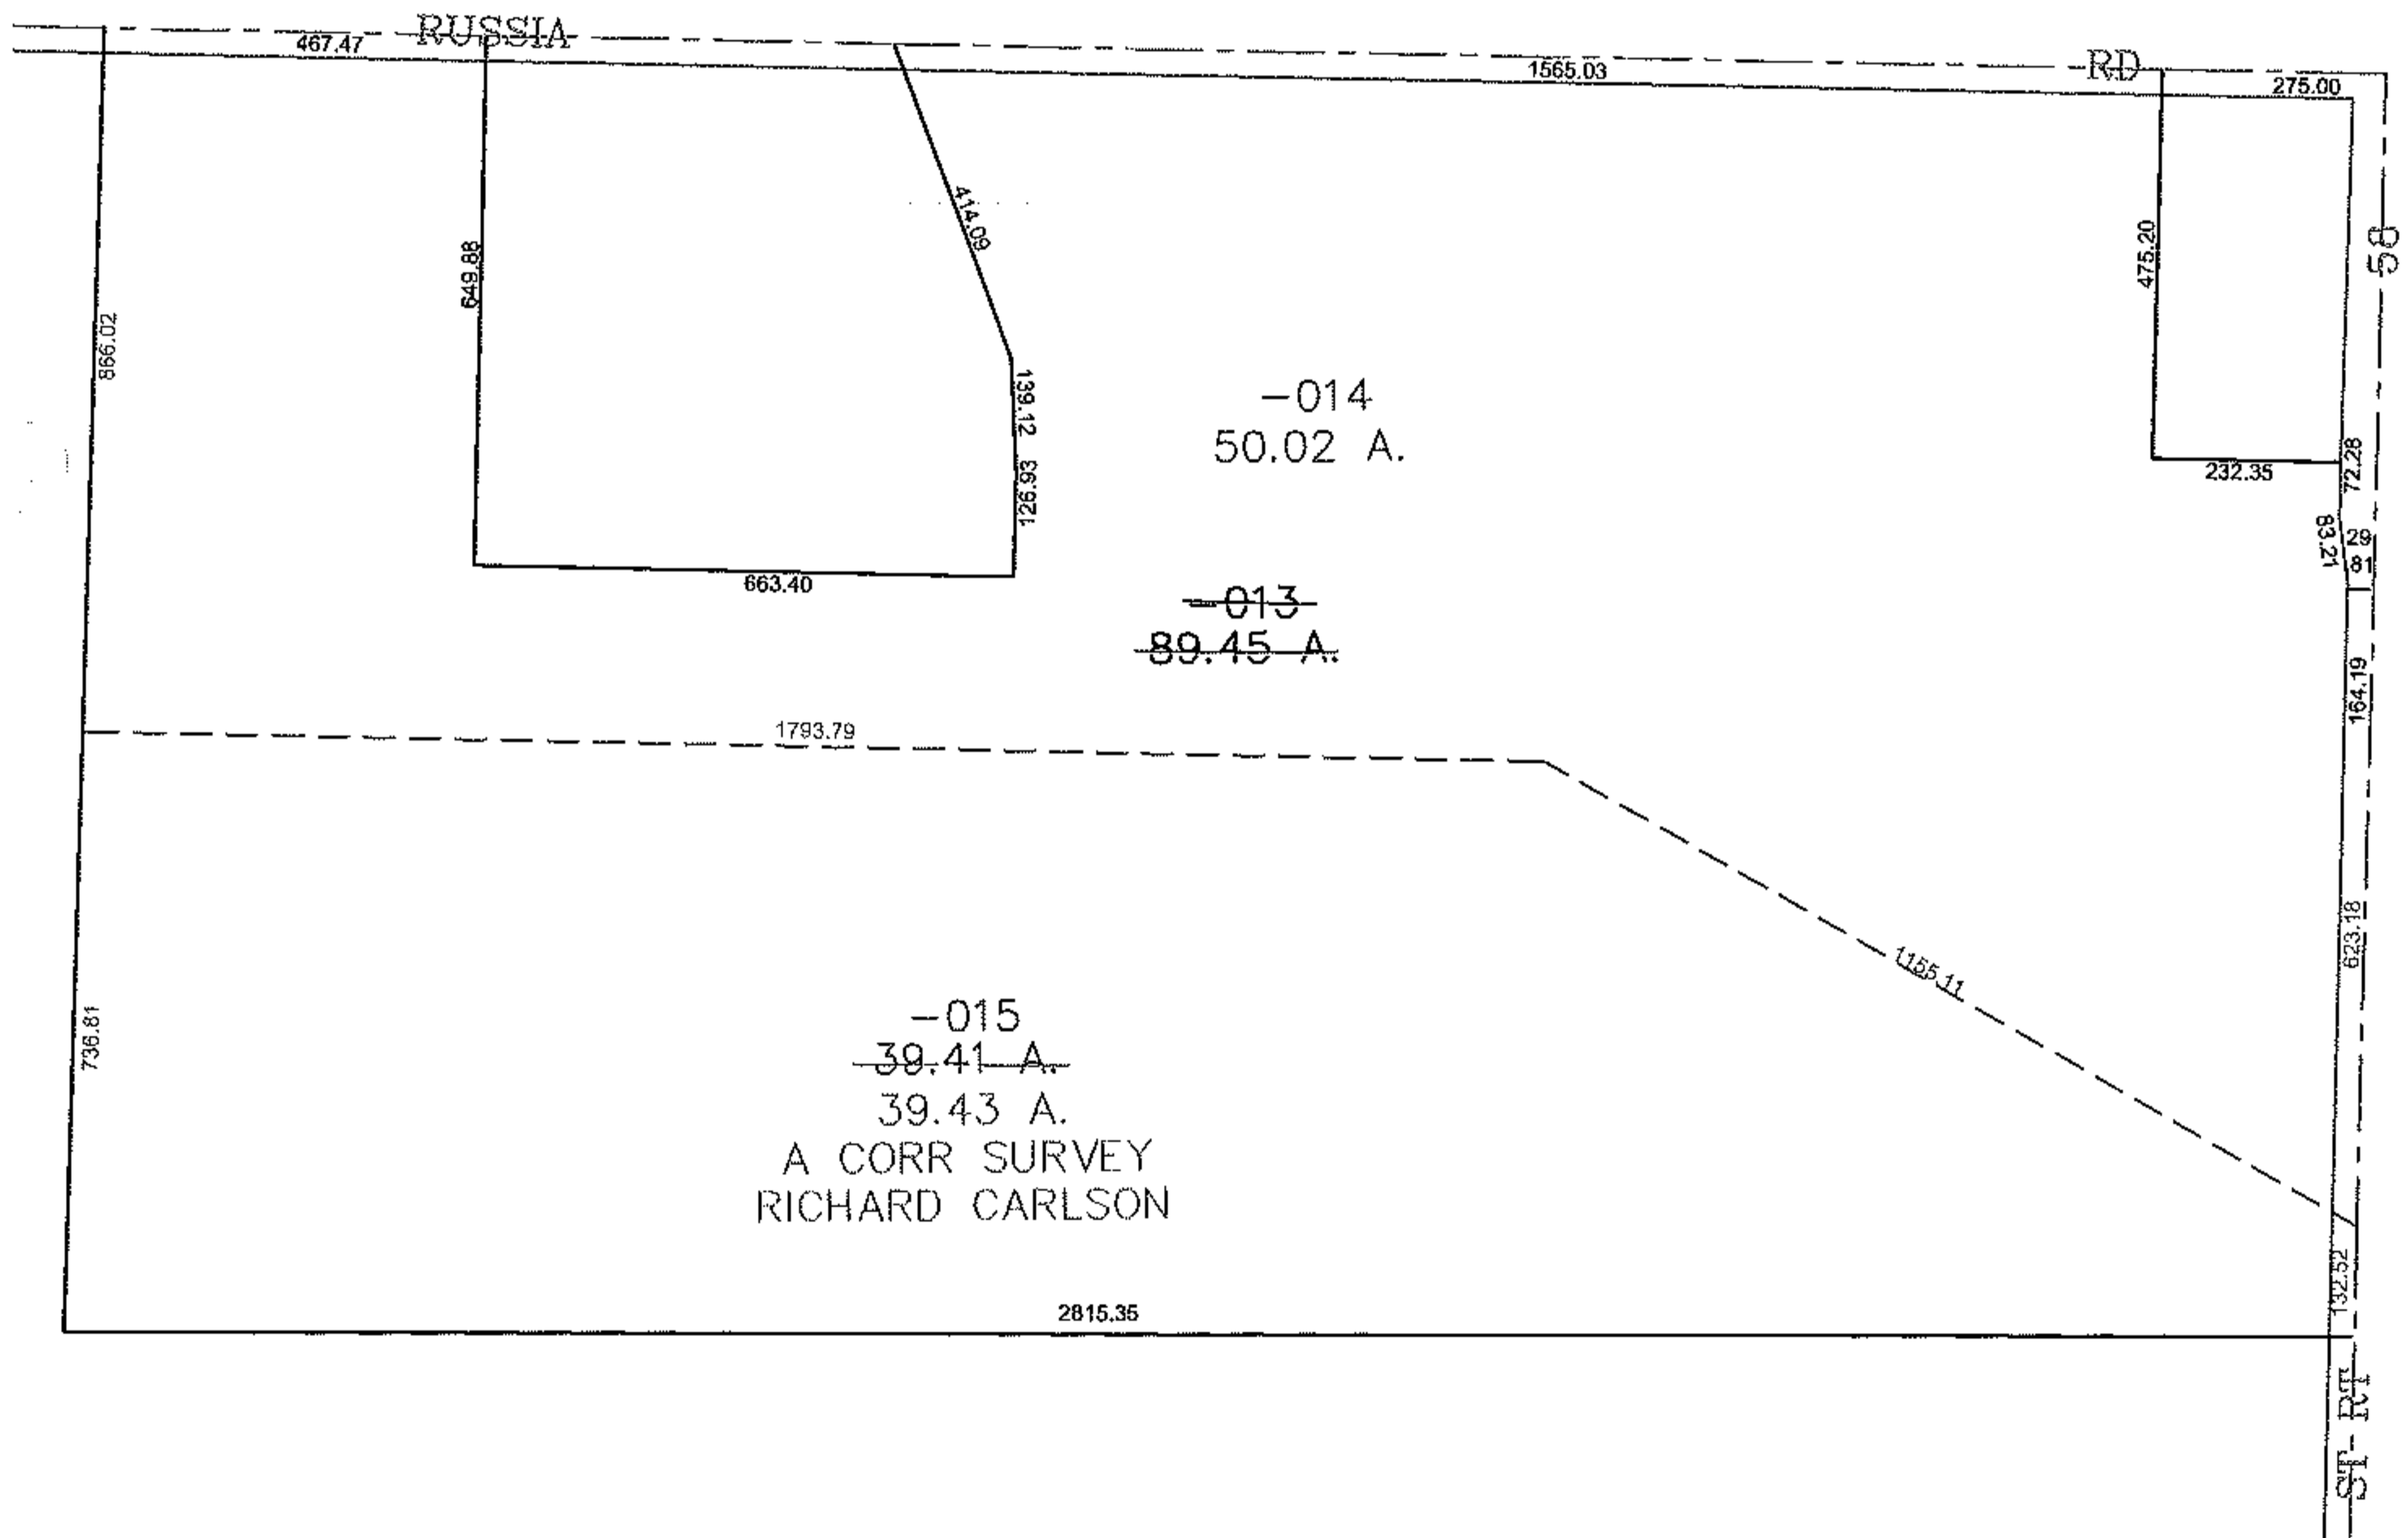


PARENT PARCEL: 09-00-025-000-013
CHILD PARCEL: 09-00-025-000-014, -015
STARTING POINT: CENTERLINE OF RUSSIA RD & ST RT 58

12-03052

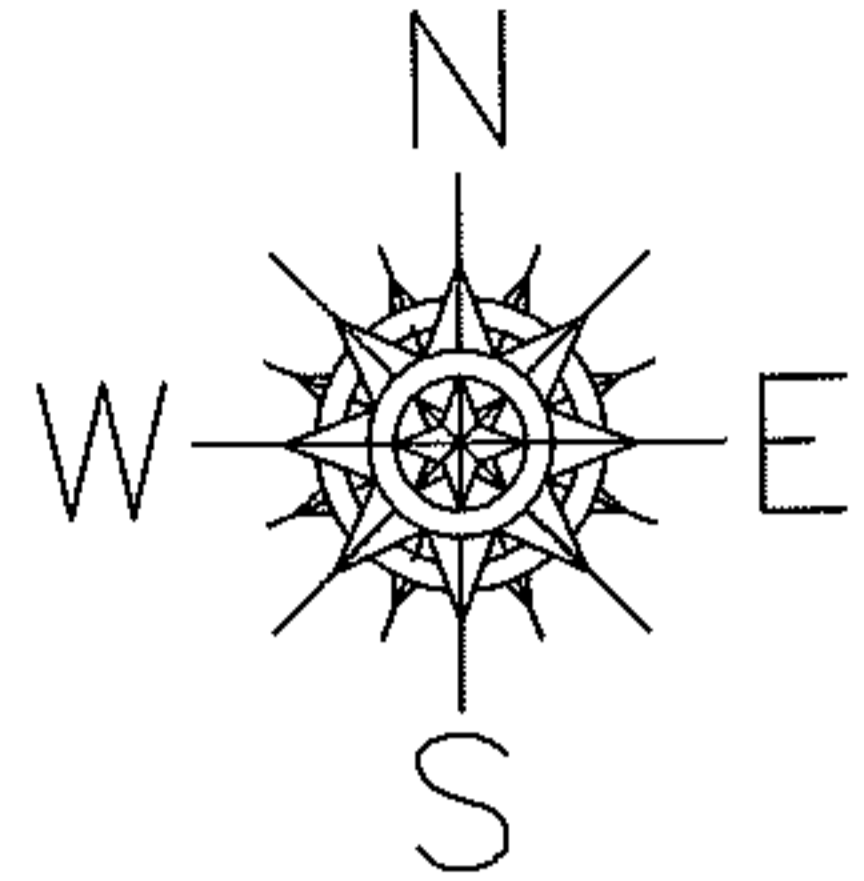

SPLITS/DEEDS PROCESSED
LORAIN COUNTY TAX MAP DEPARTMENT
226 MIDDLE AVE. ELYRIA, OHIO

SURVEYED BY: RICHARD CARLSON
CLOSURE: 0.00 : 10,000
MAP PAGE(S): 9-B
APPROVED BY: JAH DATE: 7-31-2012
SCALE: 1" = 400 PRIOR INST.: 20030940640