
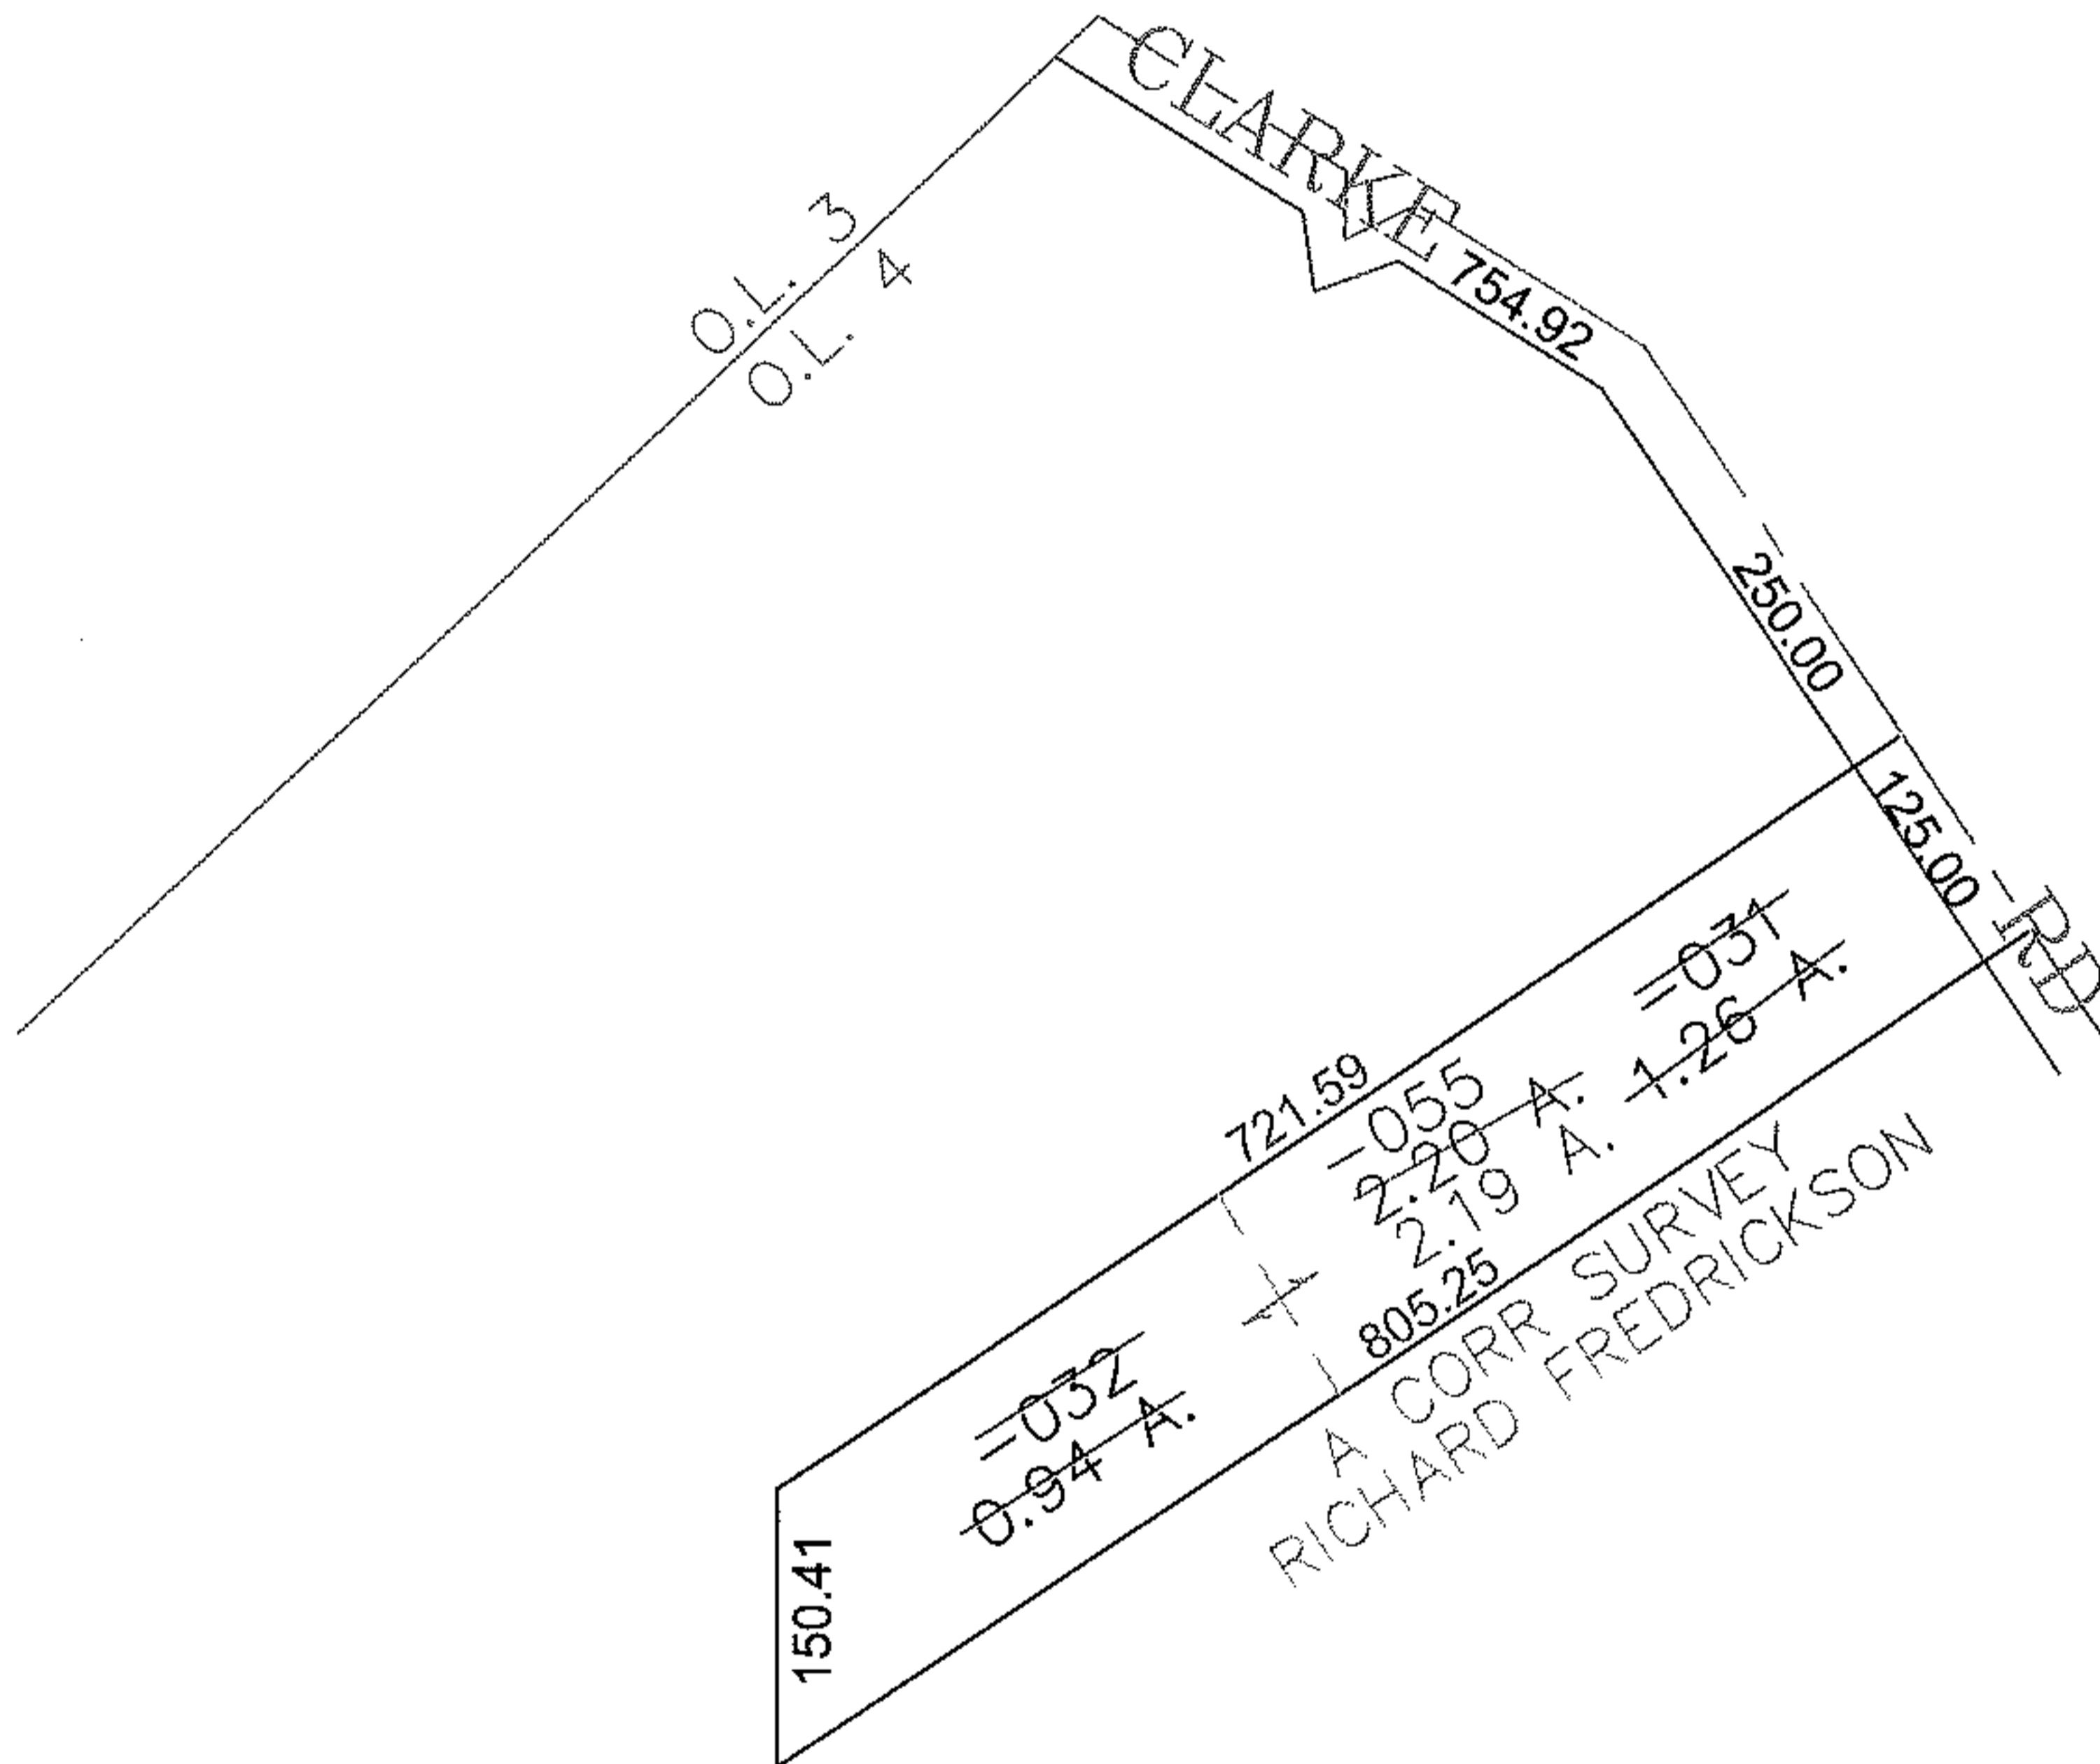


PARENT PARCEL: 12-00-004-000-031, -032

CHILD PARCEL: 12-00-004-000-055

STARTING POINT: CENTERLINE OF CLARKE RD & O.L. 4

12-03053

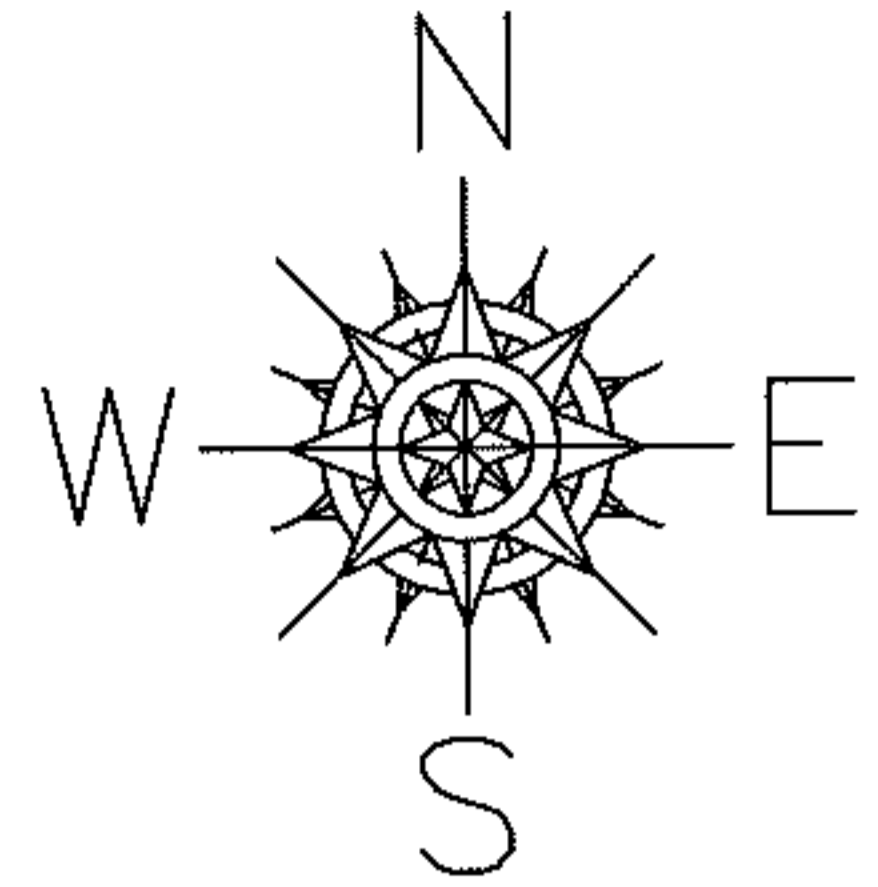

A CORR SURVEY
RICHARD FREDRICKSON

SPLITS/DEEDS PROCESSED

LORAIN COUNTY TAX MAP DEPARTMENT
226 MIDDLE AVE. ELYRIA, OHIO

SURVEYED BY: RICHARD FREDRICKSON

CLOSURE: 0.00 : 10,000

MAP PAGE(S): 12-00-004-B

APPROVED BY: JAH DATE: 8-3-2012

SCALE: 1" = 200 PRIOR INSTRUMENT: 20040046996