
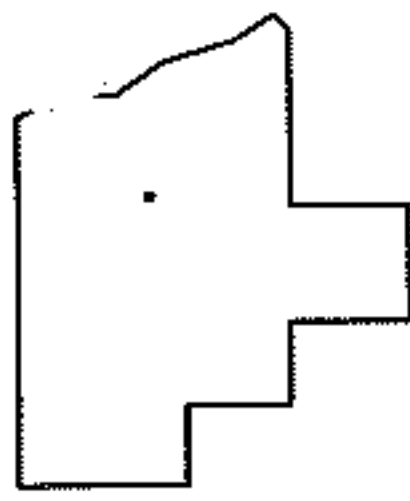
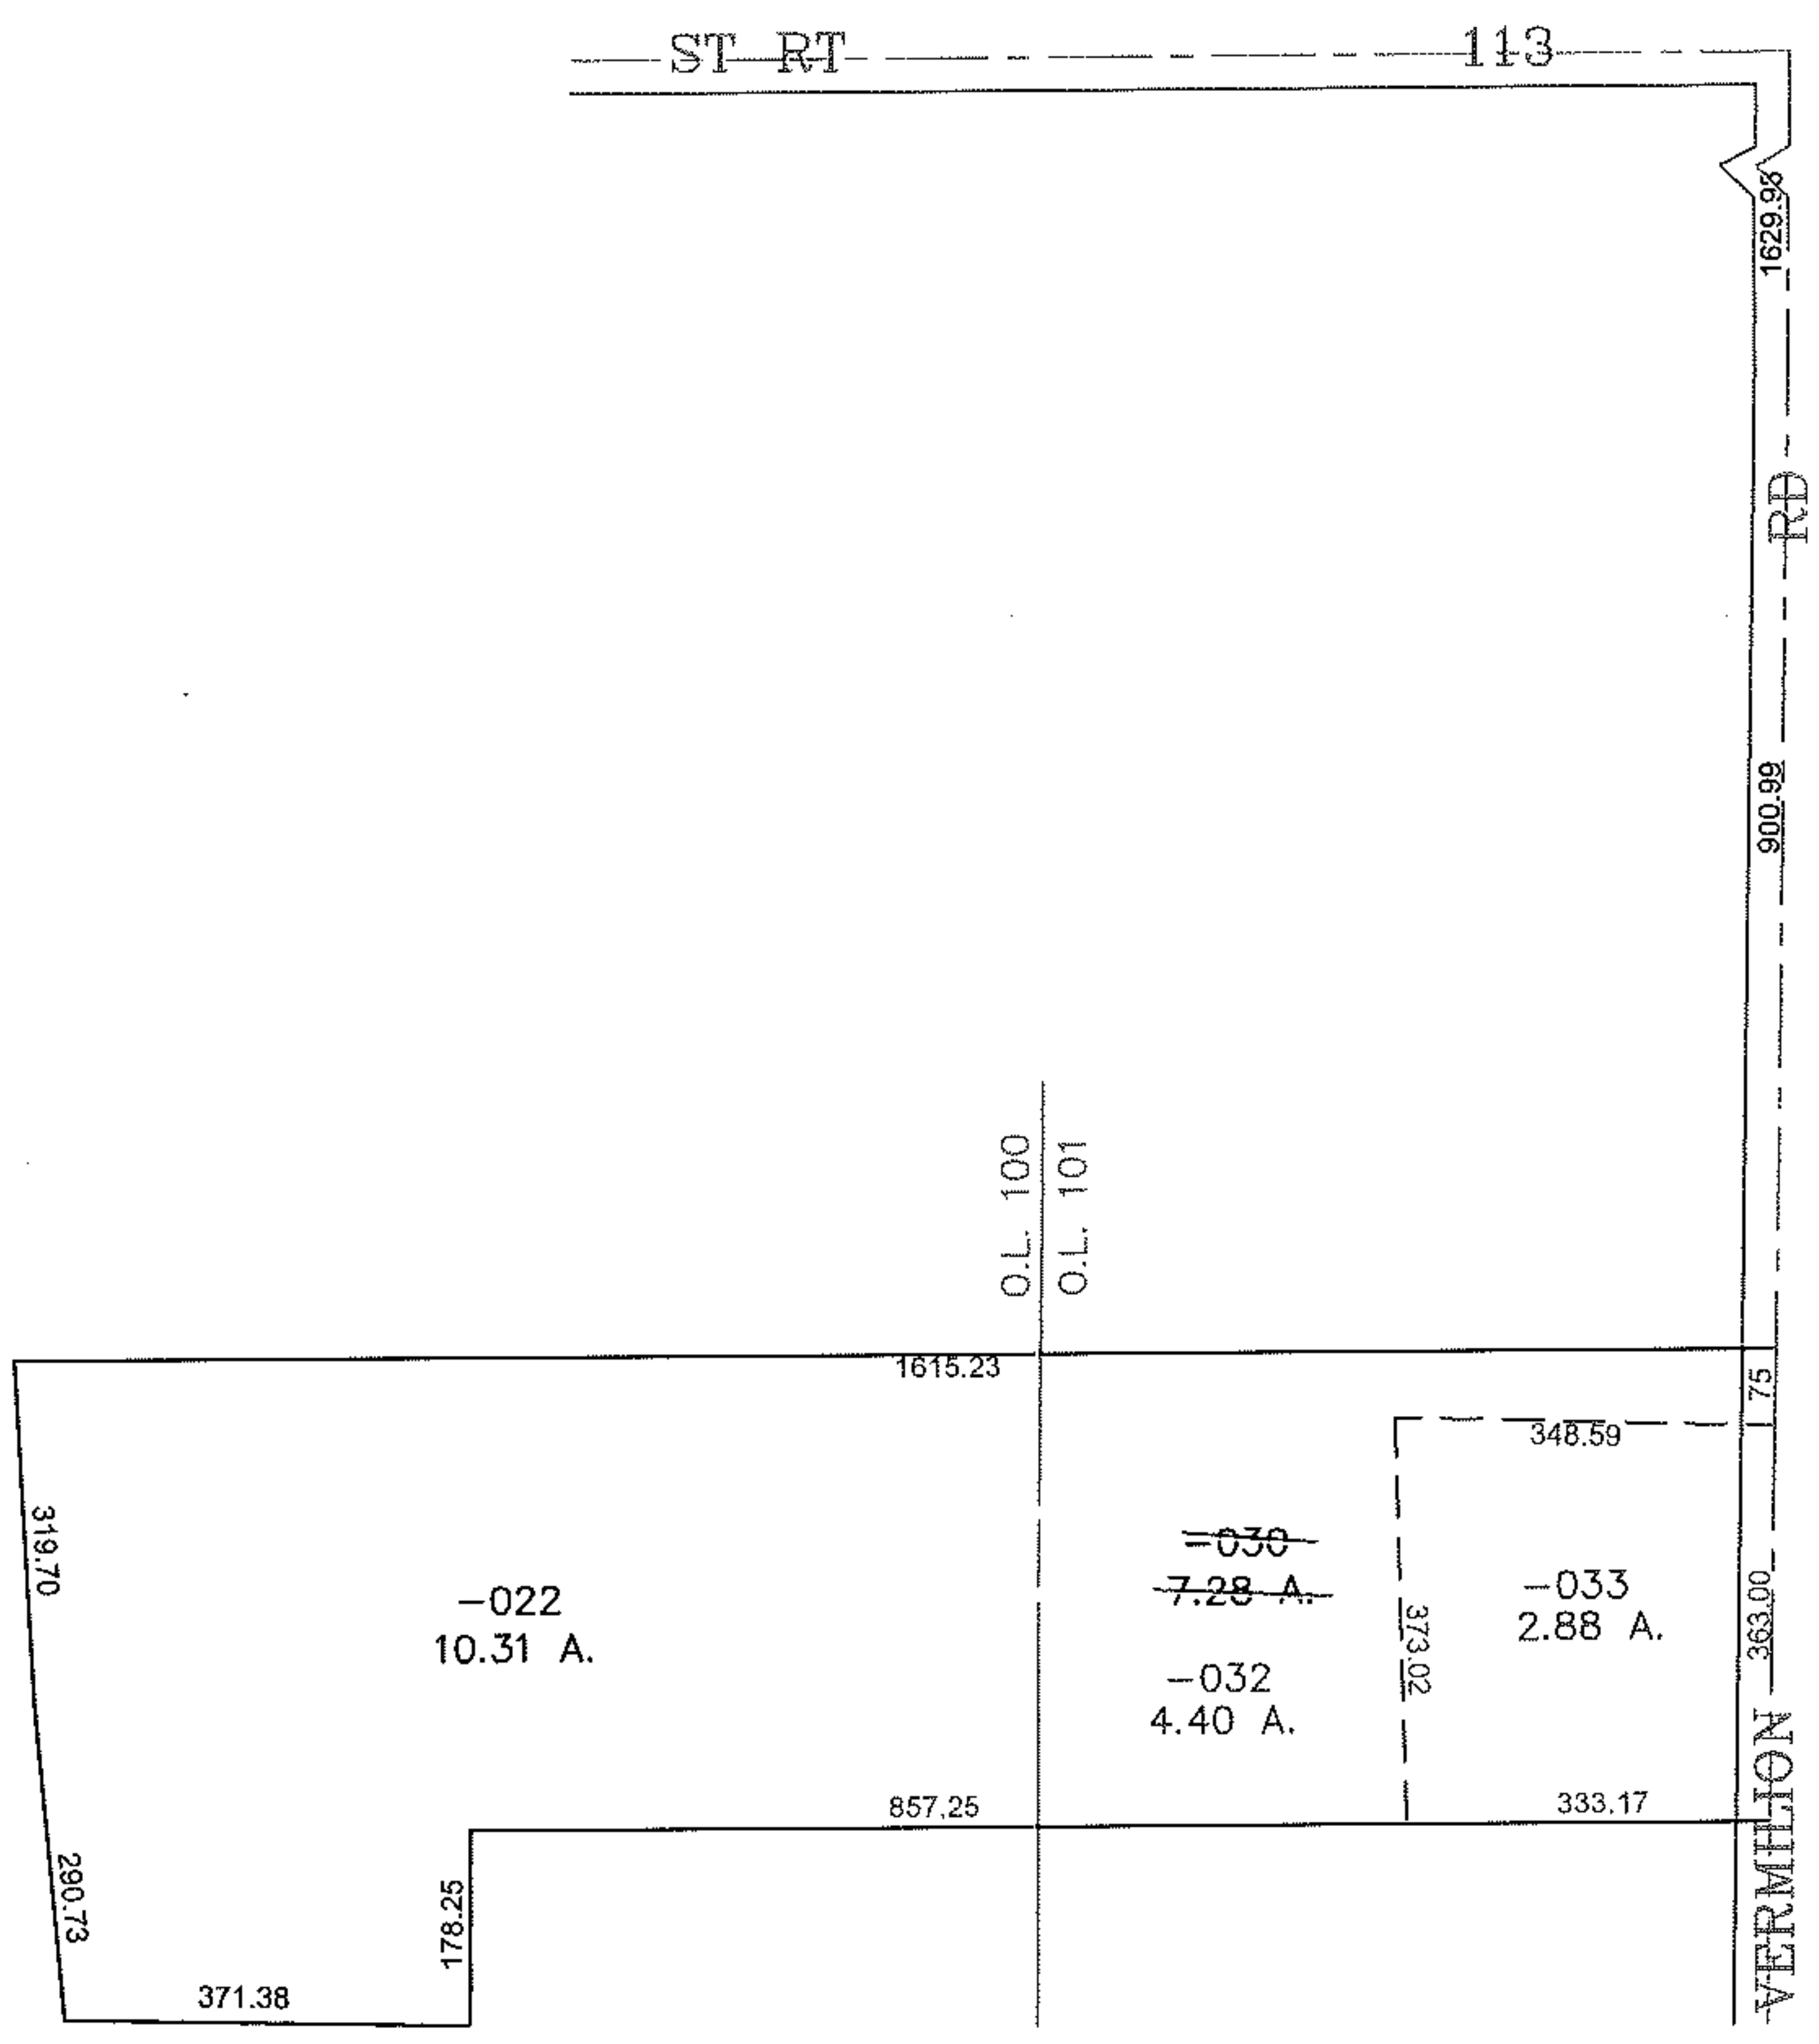


PARENT PARCEL: 08-00-101-000-030, 08-00-100-000-022

CHILD PARCEL: 08-00-101-000-032 & -033

STARTING POINT: CENTERLINE OF SR 113 & VERMILION RD

12-03054

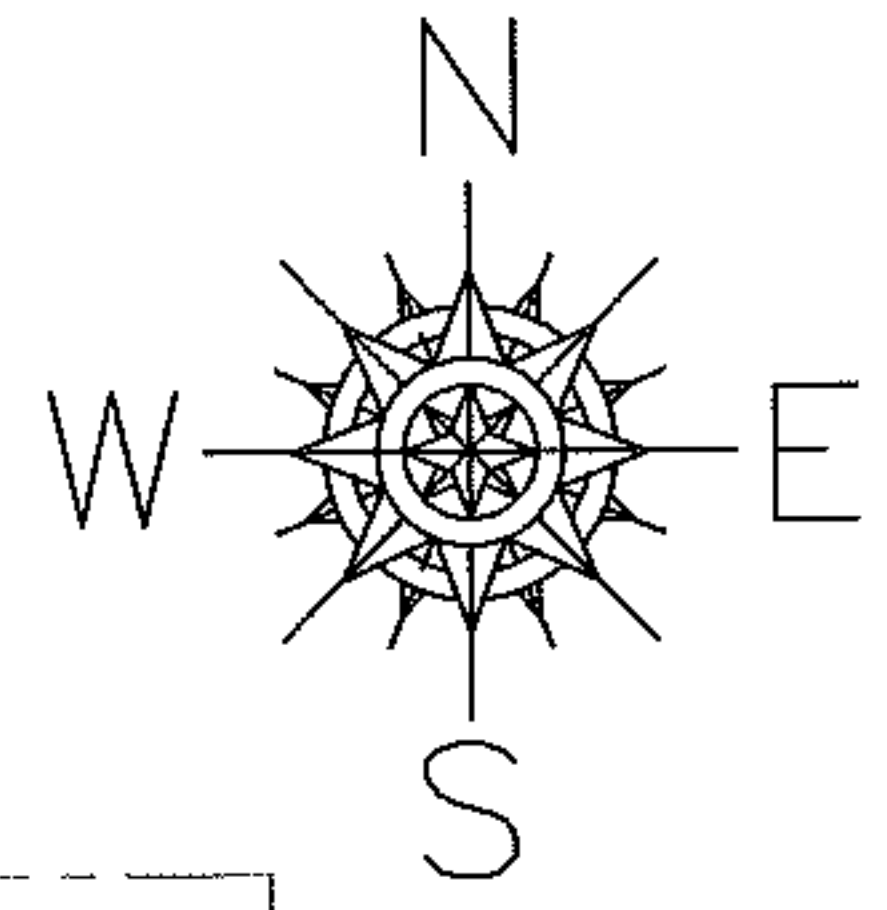

**SPLITS/DEEDS PROCESSED**  
 LORAIN COUNTY TAX MAP DEPARTMENT  
 226 MIDDLE AVE. ELYRIA, OHIO

SURVEYED BY: RICHARD CARLSON  
 CLOSURE: 0.00 : 10,000  
 MAP PAGE(S): 8-B 8-C  
 APPROVED BY: JAH DATE: 8-3-2012  
 SCALE: 1" = 300 PRIOR INSTRUMENT: 20040012572