


PARENT PARCEL: 07-00-029-000-098

CHILD PARCEL: XX-XX-XXX-XXX-XXX

STARTING POINT: CL OF STONEY RIDGE RD. & CL OF BARRES RD.

14-03055-A

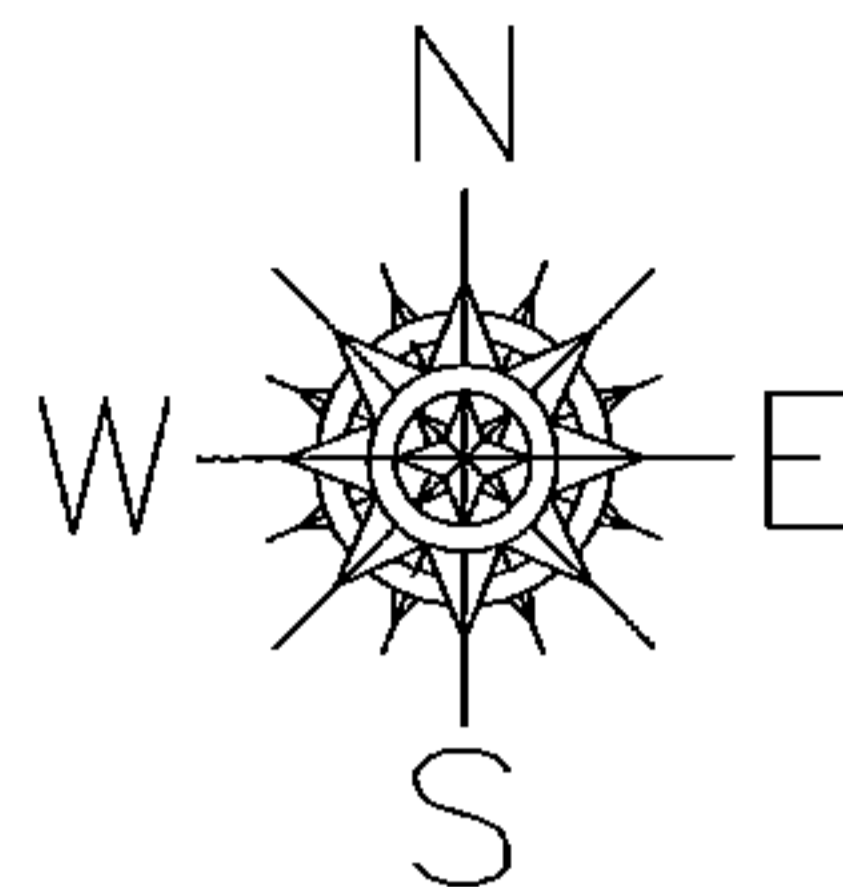

BARRES RD. 60'

217.35

ACREAGE CORRECTION

07-00-029-000-098

~~1.32 A.~~

1.30 A.

CORR. PER SURV.
DANE A. HAPONEK
OR 1479/560
INST.#20050099561
IS INCORRECT

STONEY RIDGE RD. 60'

2762.84

158.33

O.L. 32
O.L. 29

416.75

-098

~~1.32 A.~~

1.30 A.

491.95

46.26

104.77

SPLITS/DEEDS PROCESSED

LORAIN COUNTY TAX MAP DEPARTMENT
226 MIDDLE AVE. ELYRIA, OHIO

SURVEYED BY: DANE A. HAPONEK

CLOSURE: 0.01 : 10,000

MAP PAGE(S): 07-00-029

APPROVED BY: TJS DATE: 11/10/14

SCALE: 1" = 100 PRIOR INSTRUMENT: OR 1479/560