
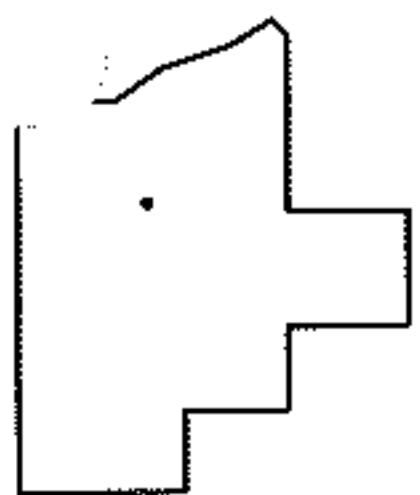
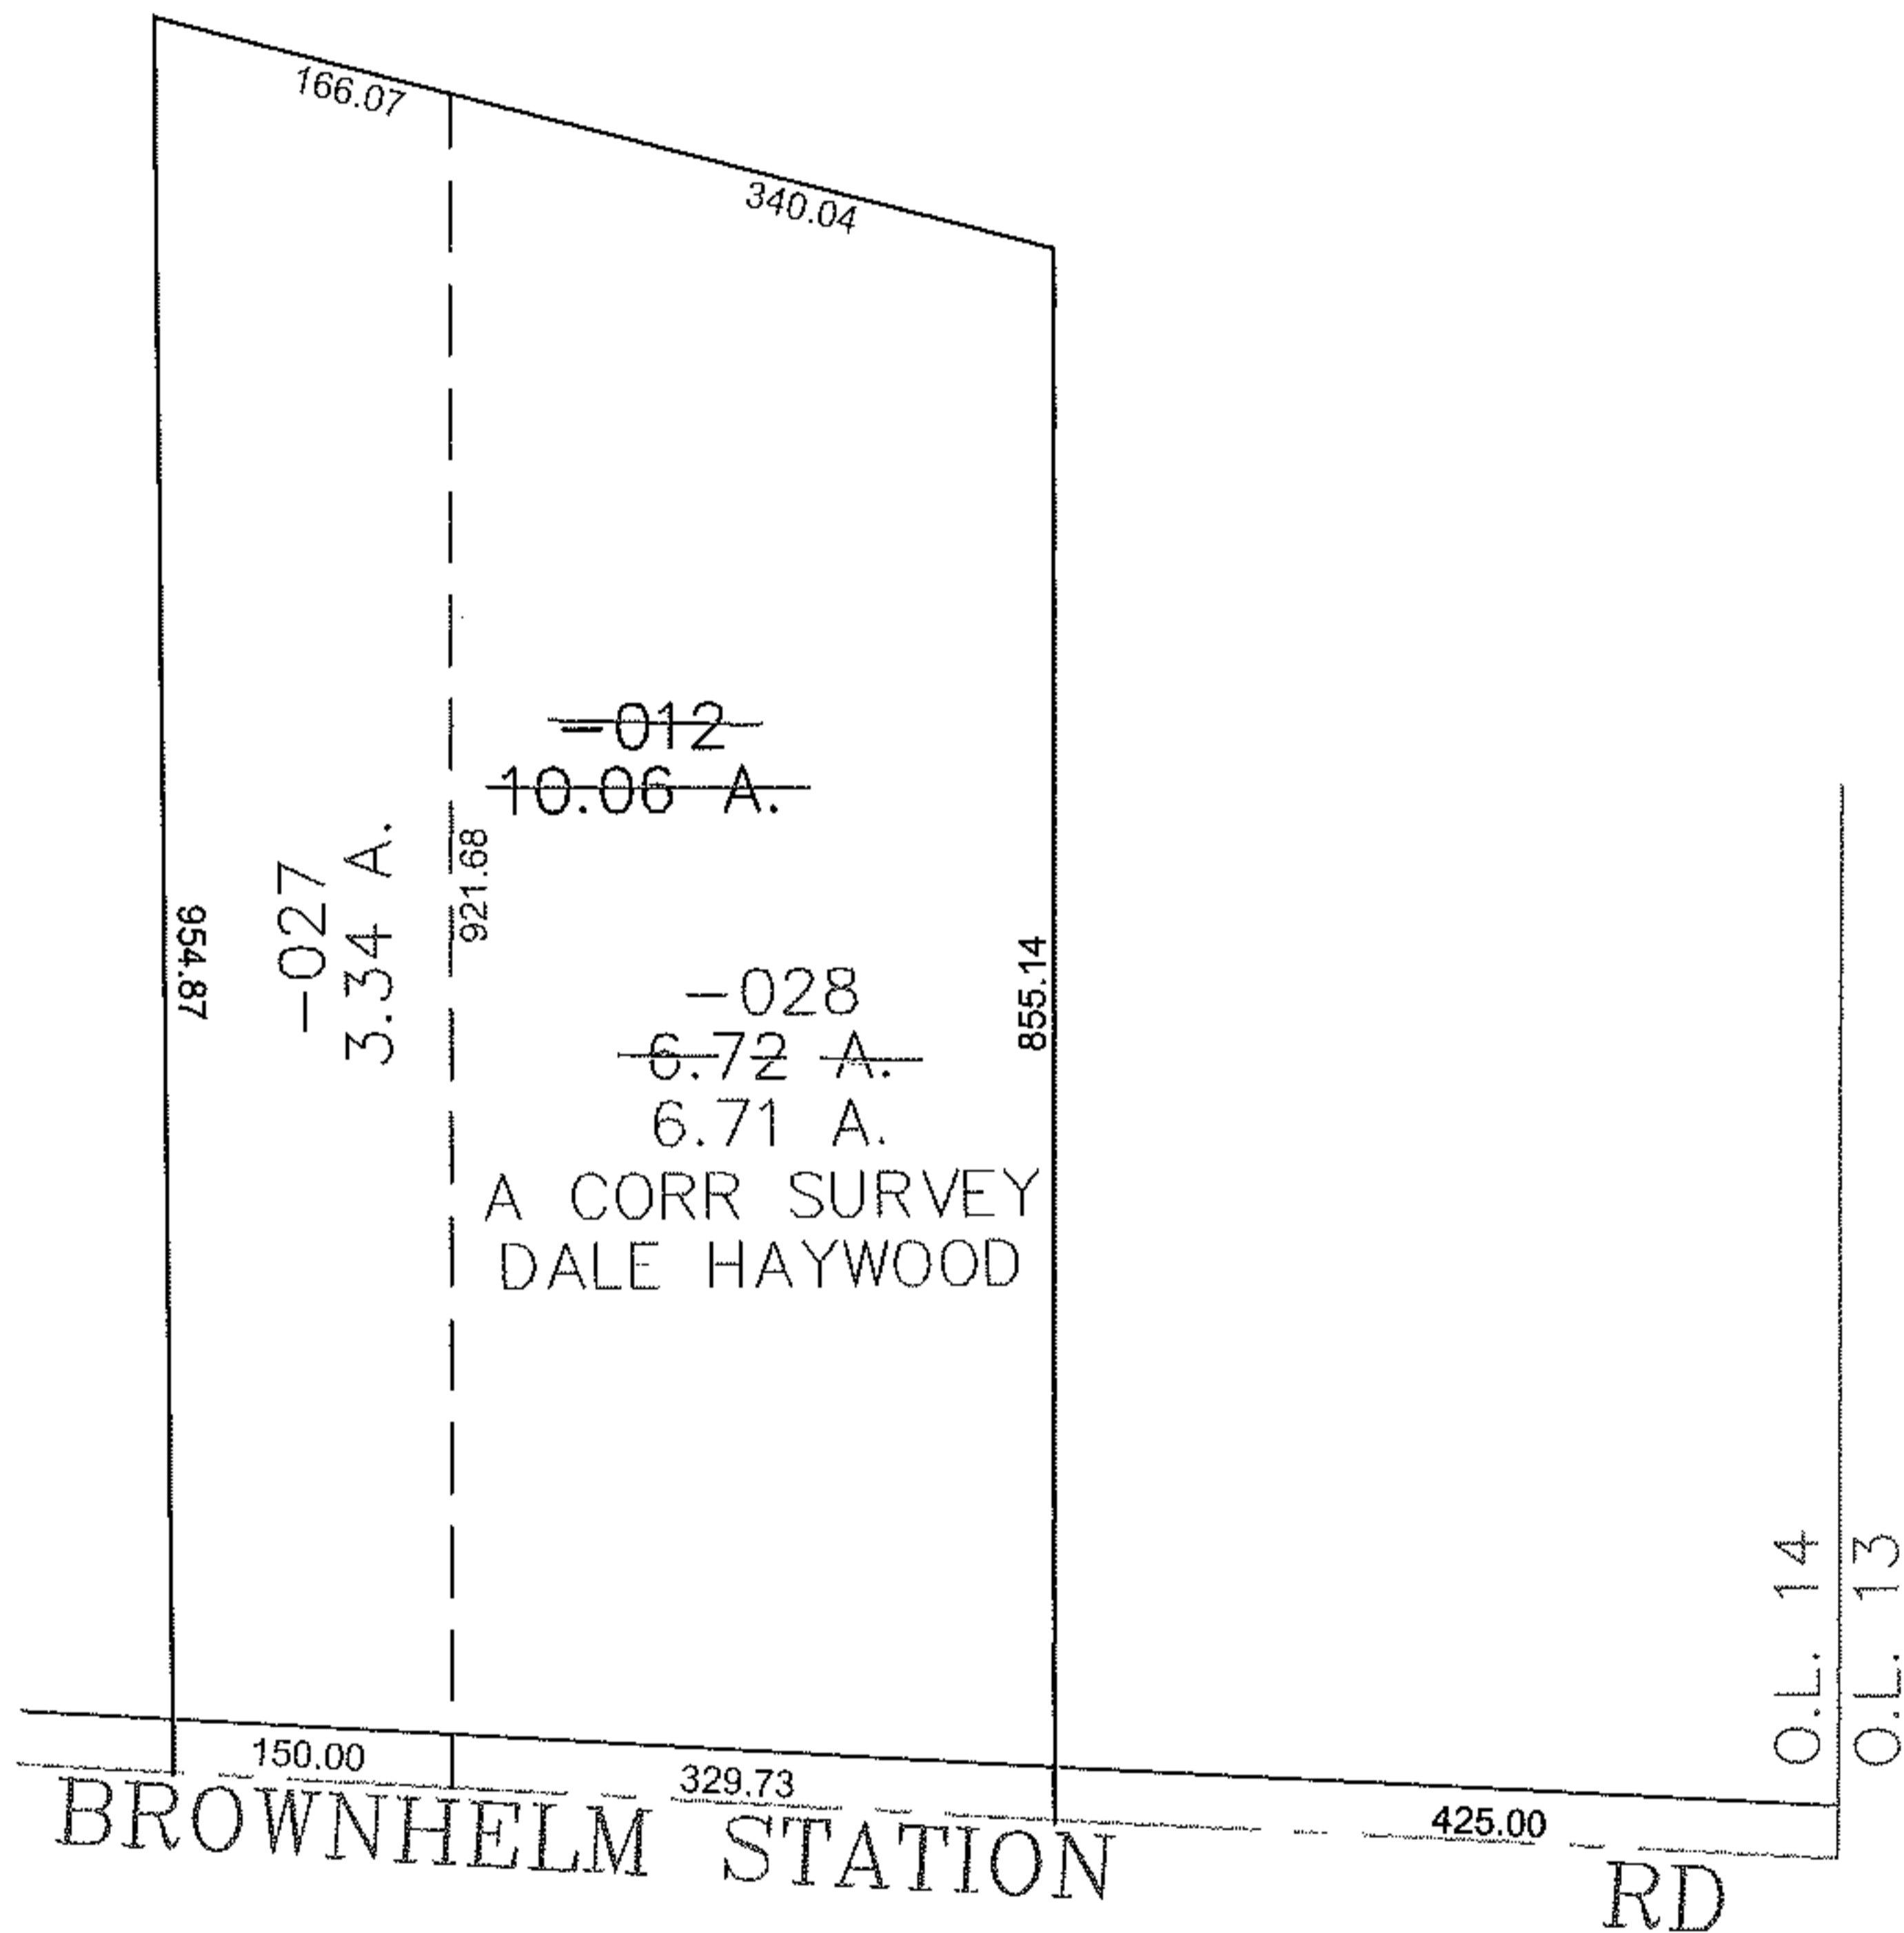


PARENT PARCEL: 01-00-014-000-012

CHILD PARCEL: 01-00-014-000-027, -028

12-03059

STARTING POINT: CENTERLINE OF BROWNHELM STATION RD & O.L. 14

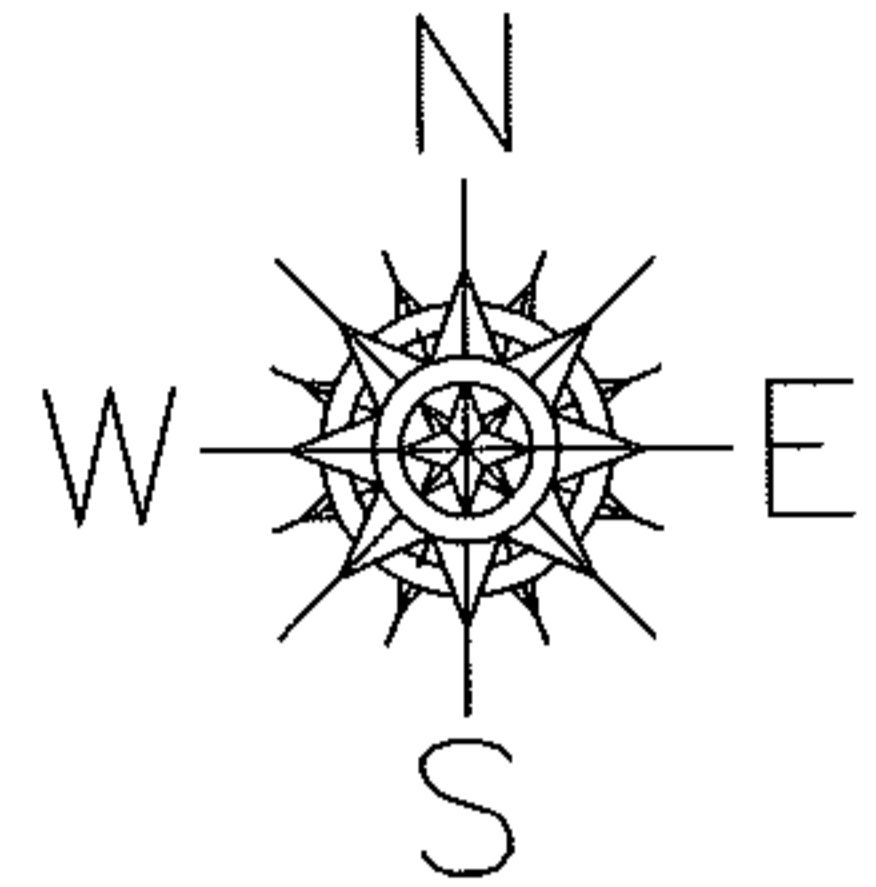

SPLITS/DEEDS PROCESSED
 LORAIN COUNTY TAX MAP DEPARTMENT
 226 MIDDLE AVE. ELYRIA, OHIO

SURVEYED BY: DALE R HAYWOOD
 CLOSURE: 0.00 : 10,000
 MAP PAGE(S): 1-B
 APPROVED BY: JAH DATE: 8-21-2012
 SCALE: 1" = 200 PRIOR INSTRUMENT: OR 1133/584