
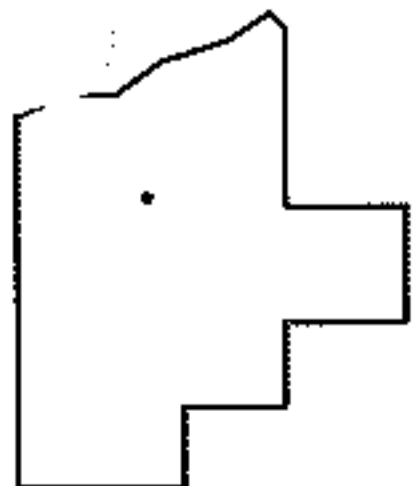
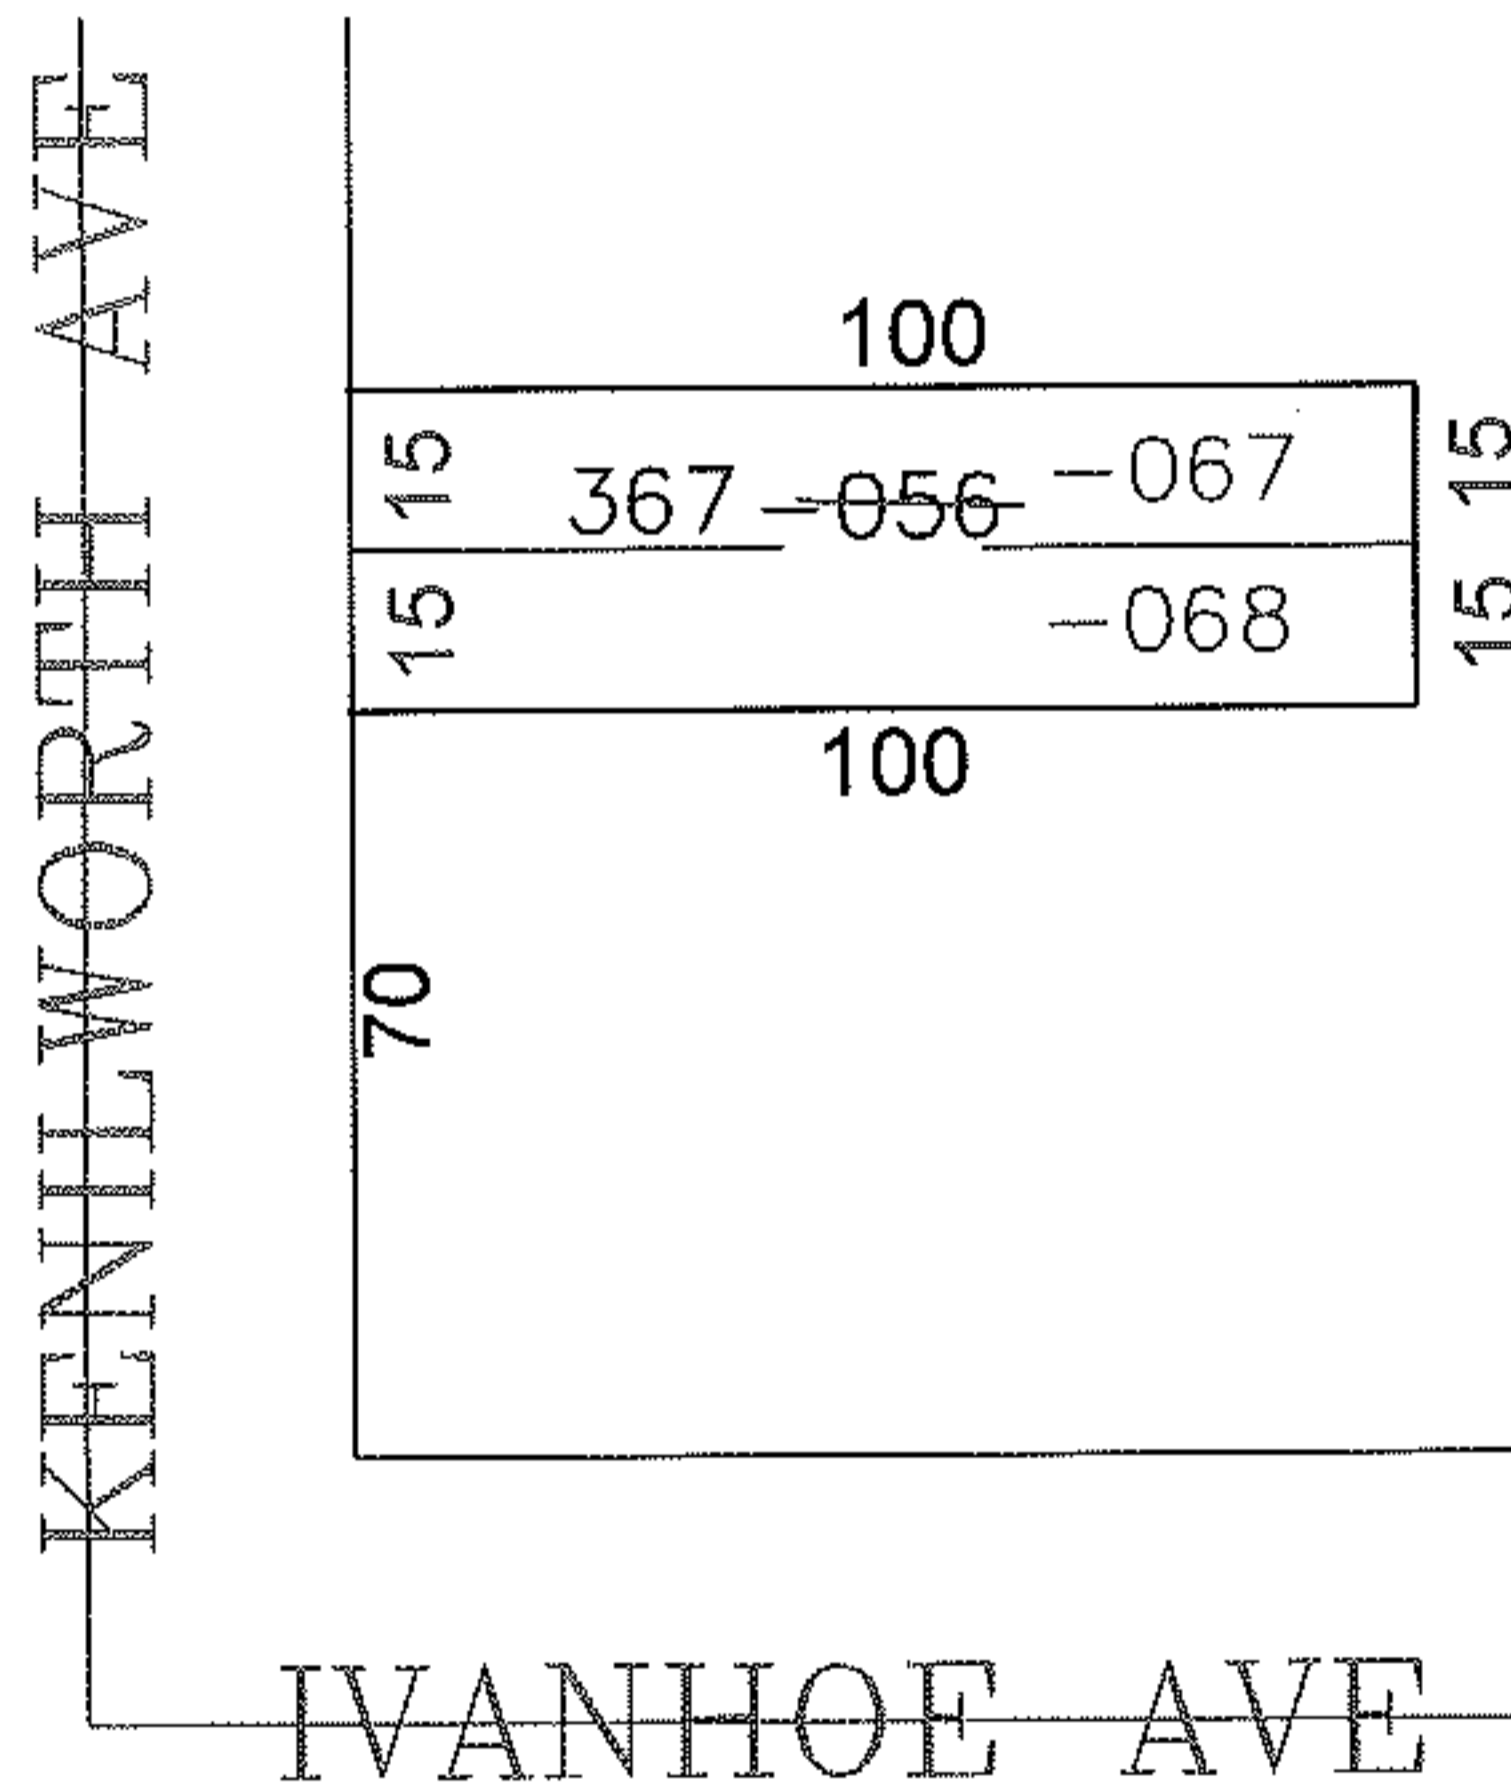


PARENT PARCEL: 03-00-039-112-056

CHILD PARCEL: 03-00-039-112-067, -068

STARTING POINT: SIDELINE OF IVANHOE AVE & KENILWORTH AVE

12-03061

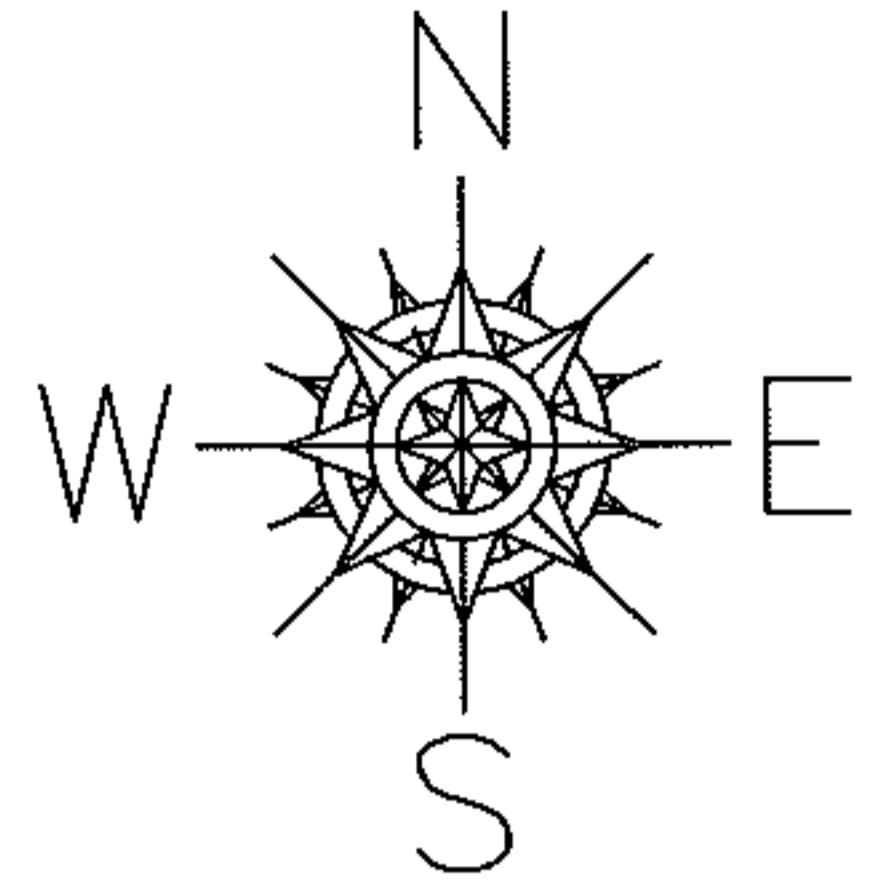

**SPLITS/DEEDS PROCESSED**

LORAIN COUNTY TAX MAP DEPARTMENT  
226 MIDDLE AVE. ELYRIA, OHIO

SURVEYED BY: PATRICK MCGANNON

CLOSURE: 0.00 : 10,000

MAP PAGE(S): 03-00-039-B

APPROVED BY: JAH DATE: 8-29-2012

SCALE: 1" = 50' PRIOR INST.: 199804101989