
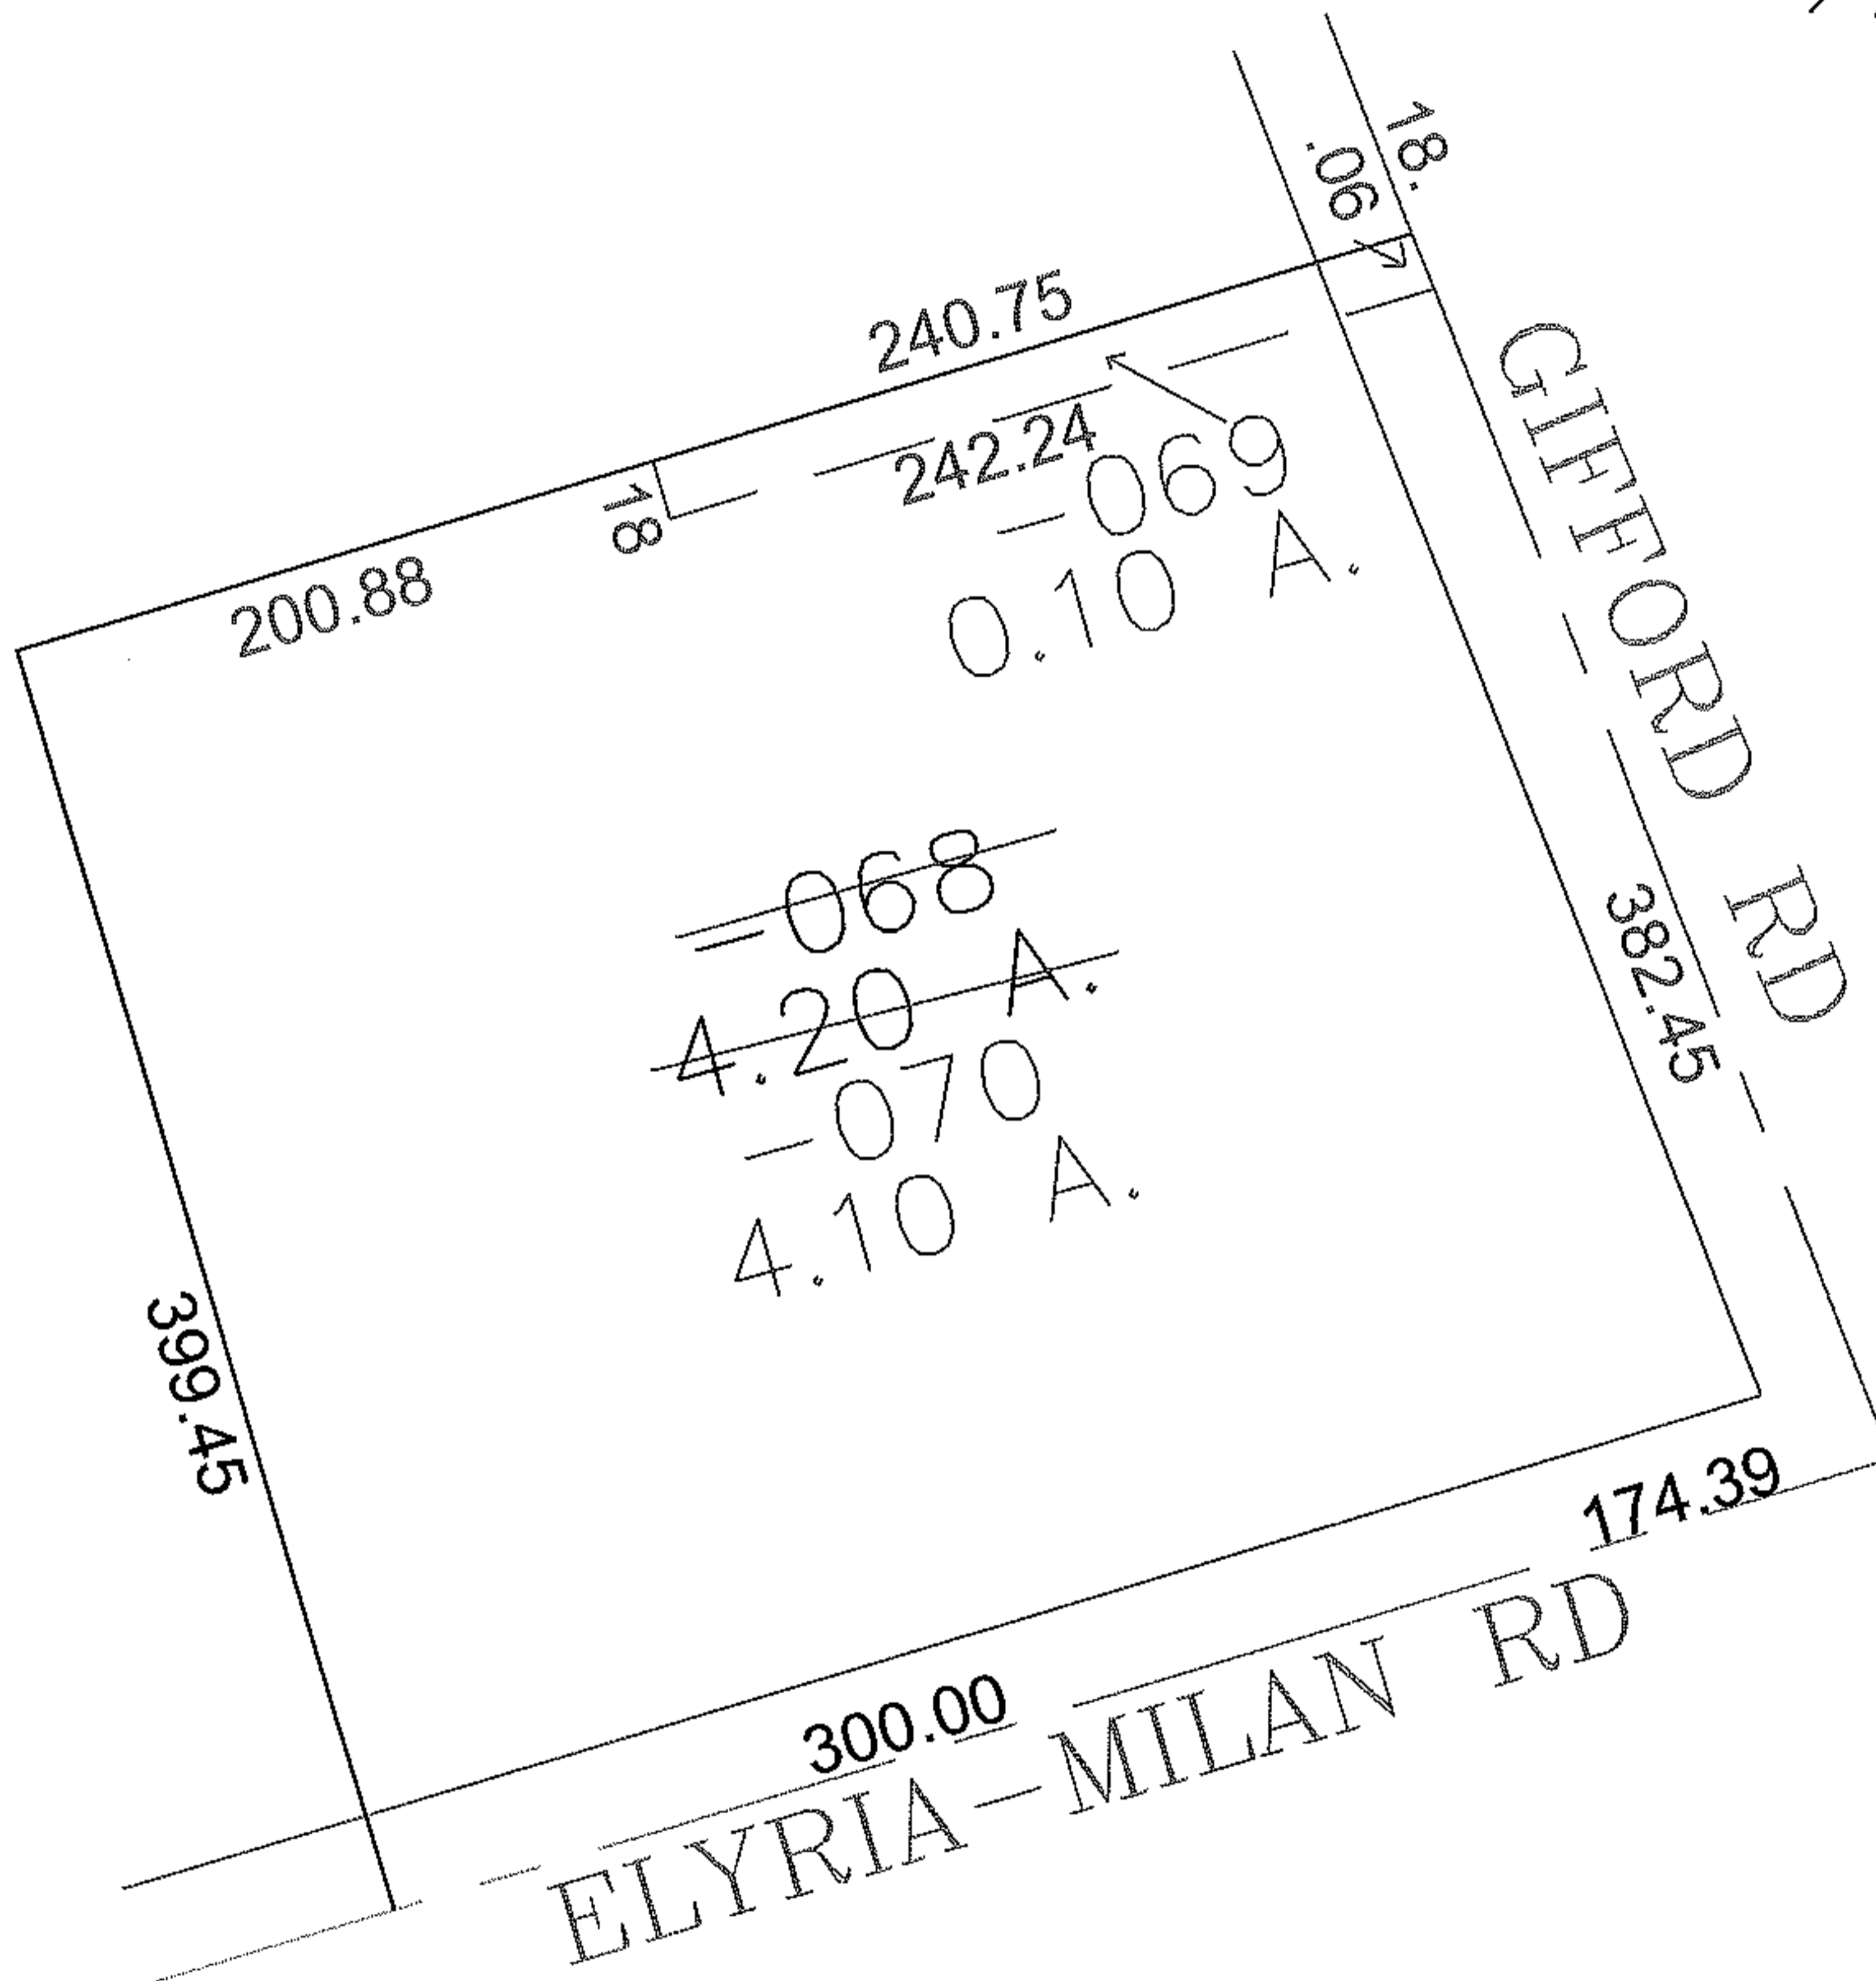


PARENT PARCEL: 08-00-091-000-068

CHILD PARCEL: 08-00-091-000-069, -070

STARTING POINT: CENTERLINE OF ELYRIA-MILAN RD & GIFFORD RD

12-03062

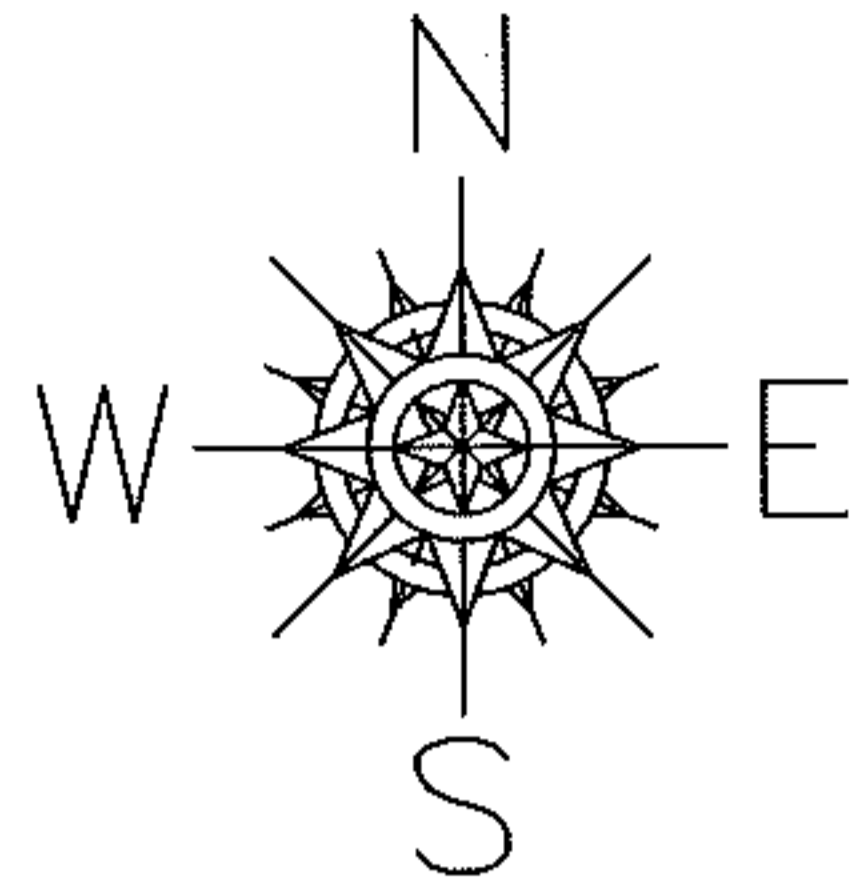

SPLITS/DEEDS PROCESSED

LORAIN COUNTY TAX MAP DEPARTMENT
226 MIDDLE AVE. ELYRIA, OHIO

SURVEYED BY: THOMAS SNEZEK

CLOSURE: 0.00 : 10.000

MAP PAGE(S): 8-C

APPROVED BY: JAH DATE: 8/29/2012

SCALE: 1" = 100 PRIOR INSTRUMENT: 20080257600