
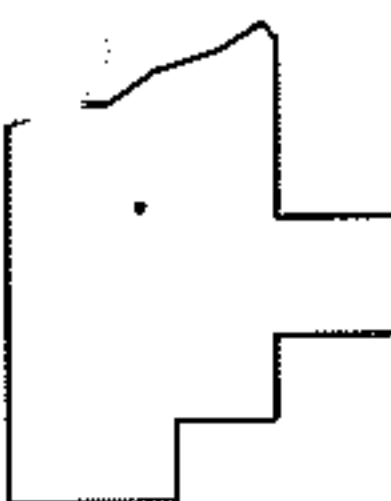
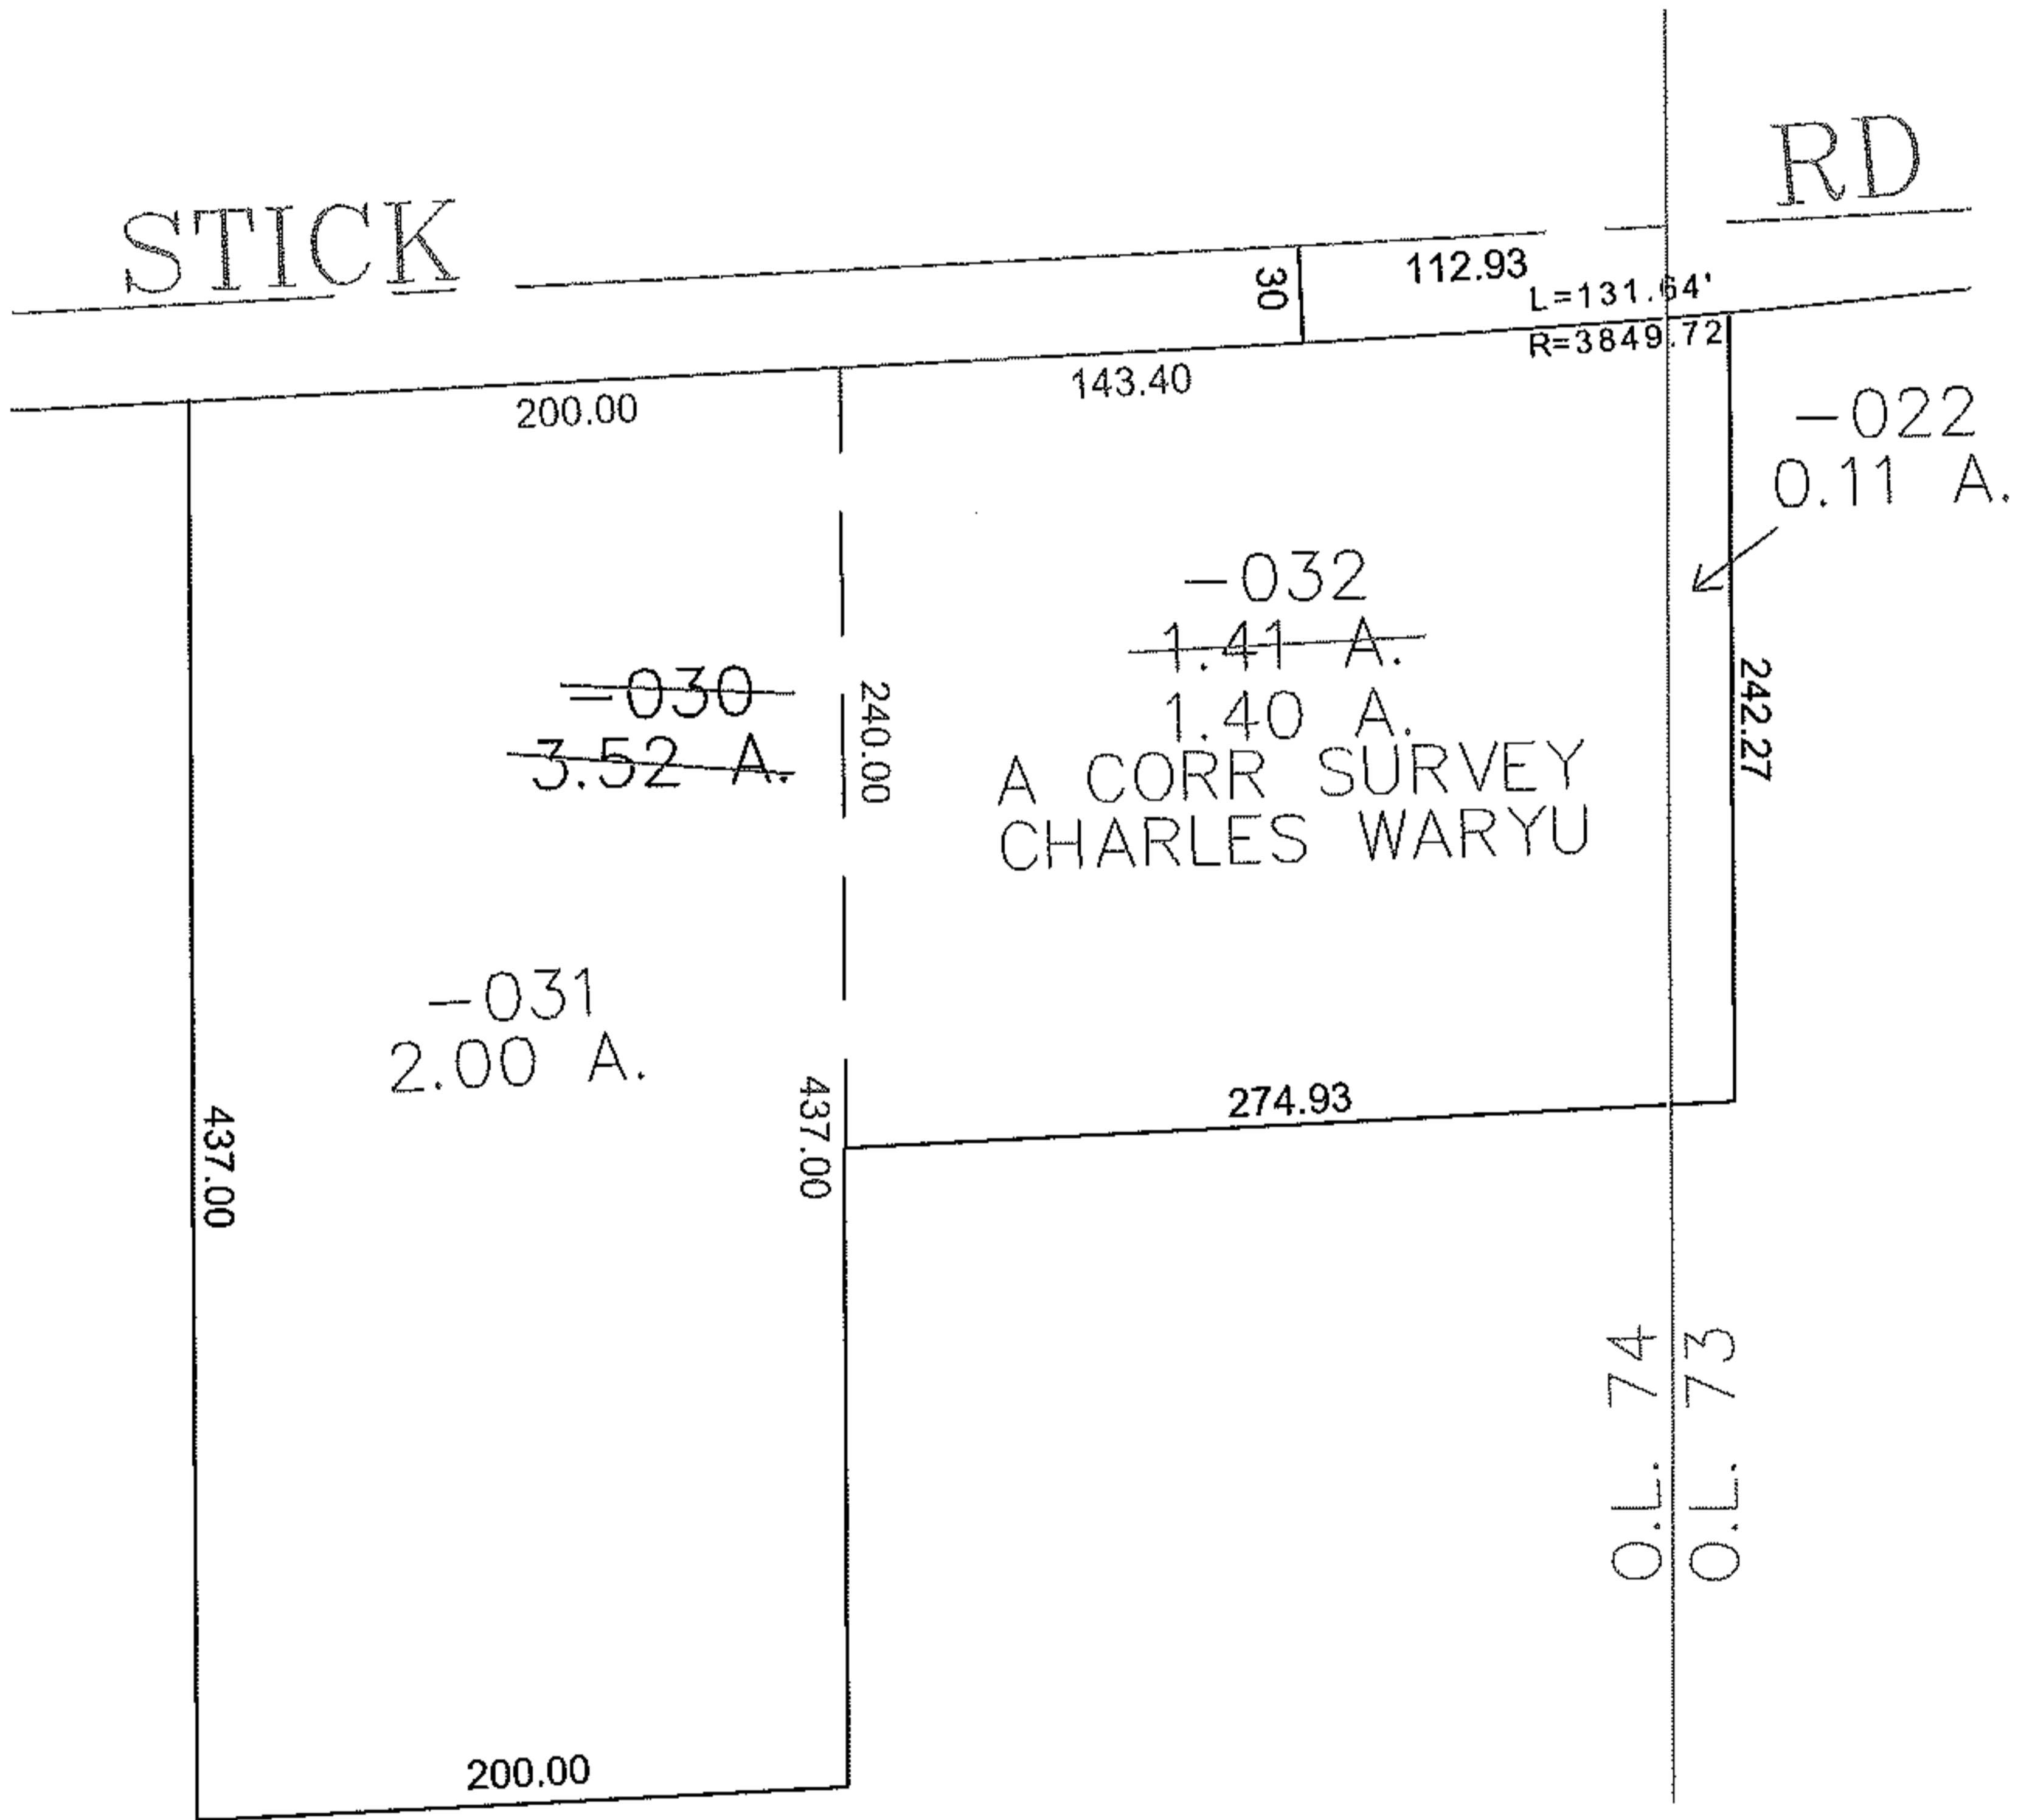


PARENT PARCEL: 01-00-074-000-030

CHILD PARCEL: 01-00-074-000-031, -032 01-00-073-000-022

STARTING POINT: CENTERLINE OF STICK RD & O.L. 74

12-03064

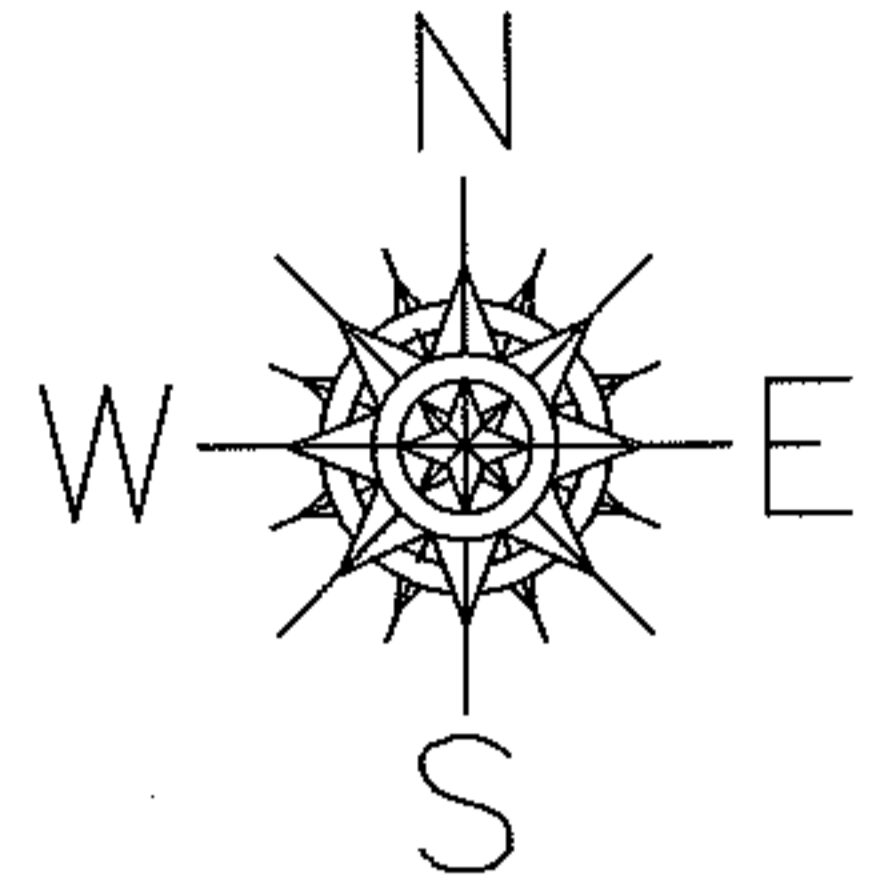

SPLITS/DEEDS PROCESSED

LORAIN COUNTY TAX MAP DEPARTMENT
226 MIDDLE AVE. ELYRIA, OHIO

SURVEYED BY: CHARLES WARYU
 CLOSURE: 0.00 : 10,000
 MAP PAGE(S): 01-00-074-B
 APPROVED BY: JAH DATE: 8-30-2012
 SCALE: 1" = 100' PRIOR INSTRUMENT: 20000676629