
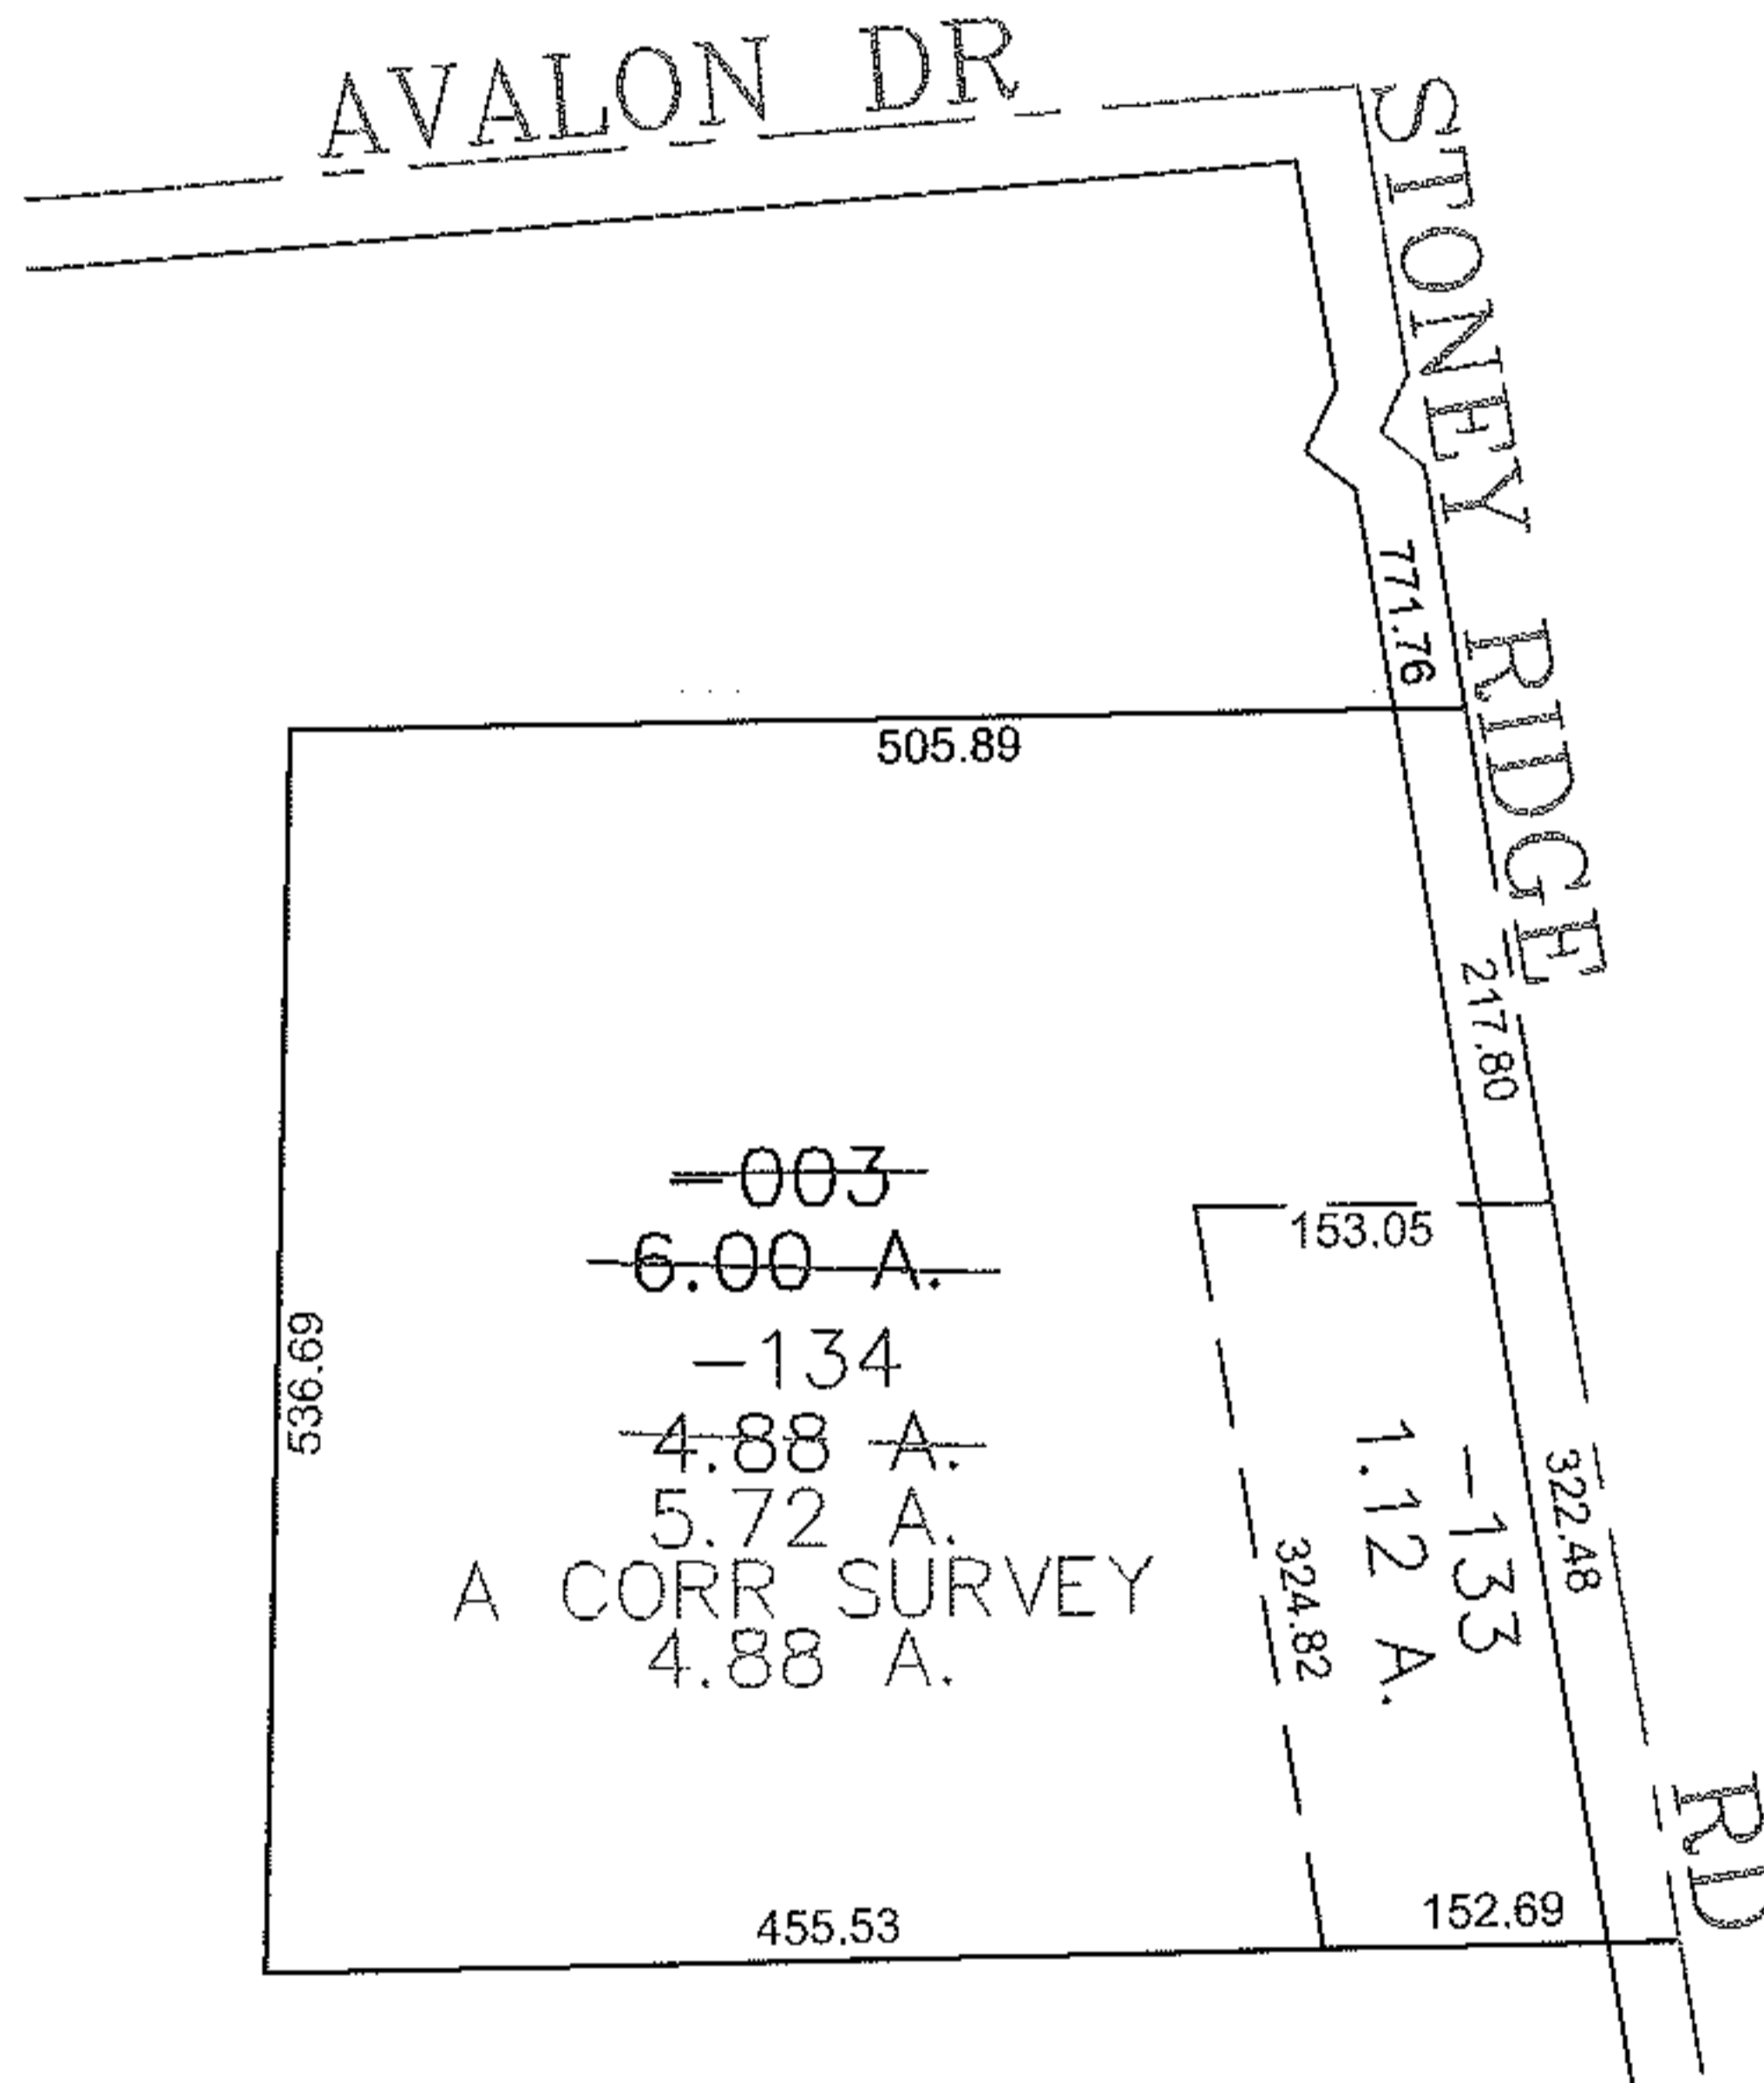


PARENT PARCEL: 07-00-031-000-003

CHILD PARCEL: 07-00-031-000-133, -134

STARTING POINT: CENTERLINE OF AVALON DR & STONEY RIDGE RD

12-03065

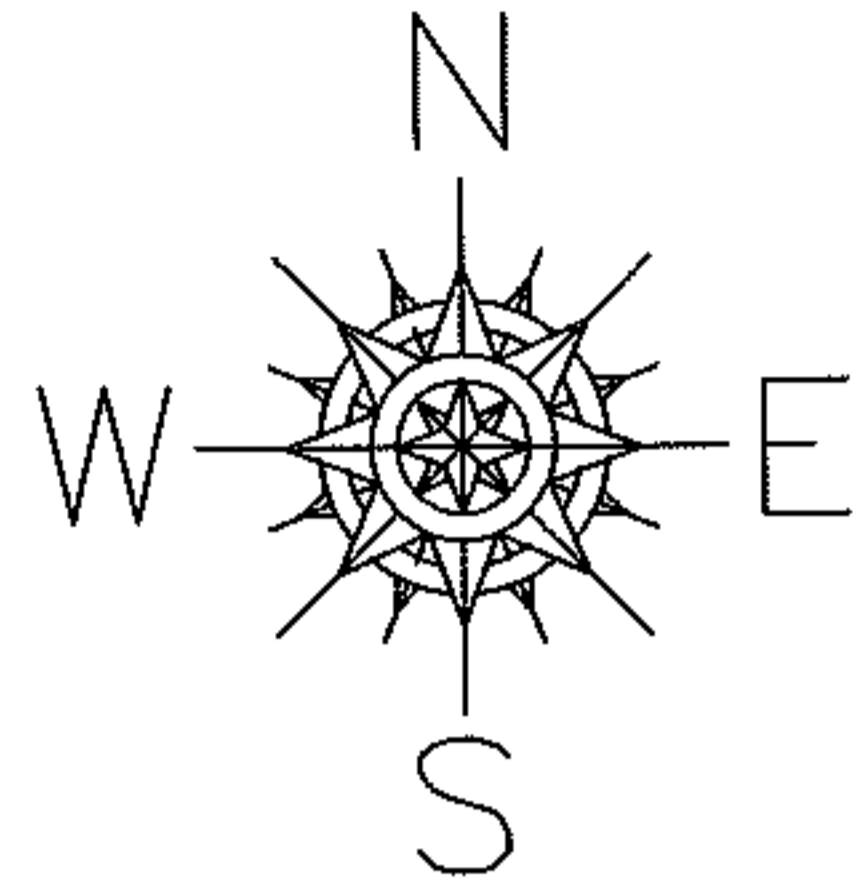

**SPLITS/DEEDS PROCESSED**

LORAIN COUNTY TAX MAP DEPARTMENT  
226 MIDDLE AVE. ELYRIA, OHIO

SURVEYED BY: ANTHONY MAIONE

CLOSURE: 0.00 : 10,000

MAP PAGE(S): 7-B

APPROVED BY: JAH DATE: 8-31-2012

SCALE: 1" = 200 PRIOR INSTRUMENT: 20030889495