
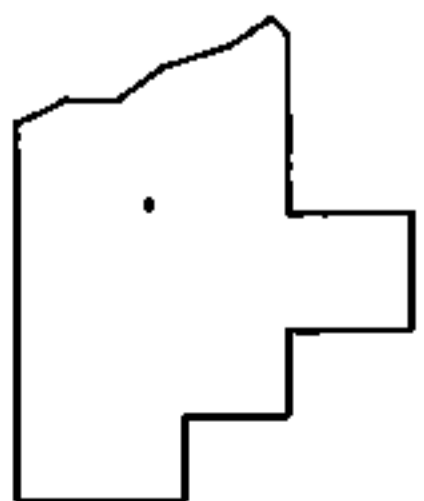
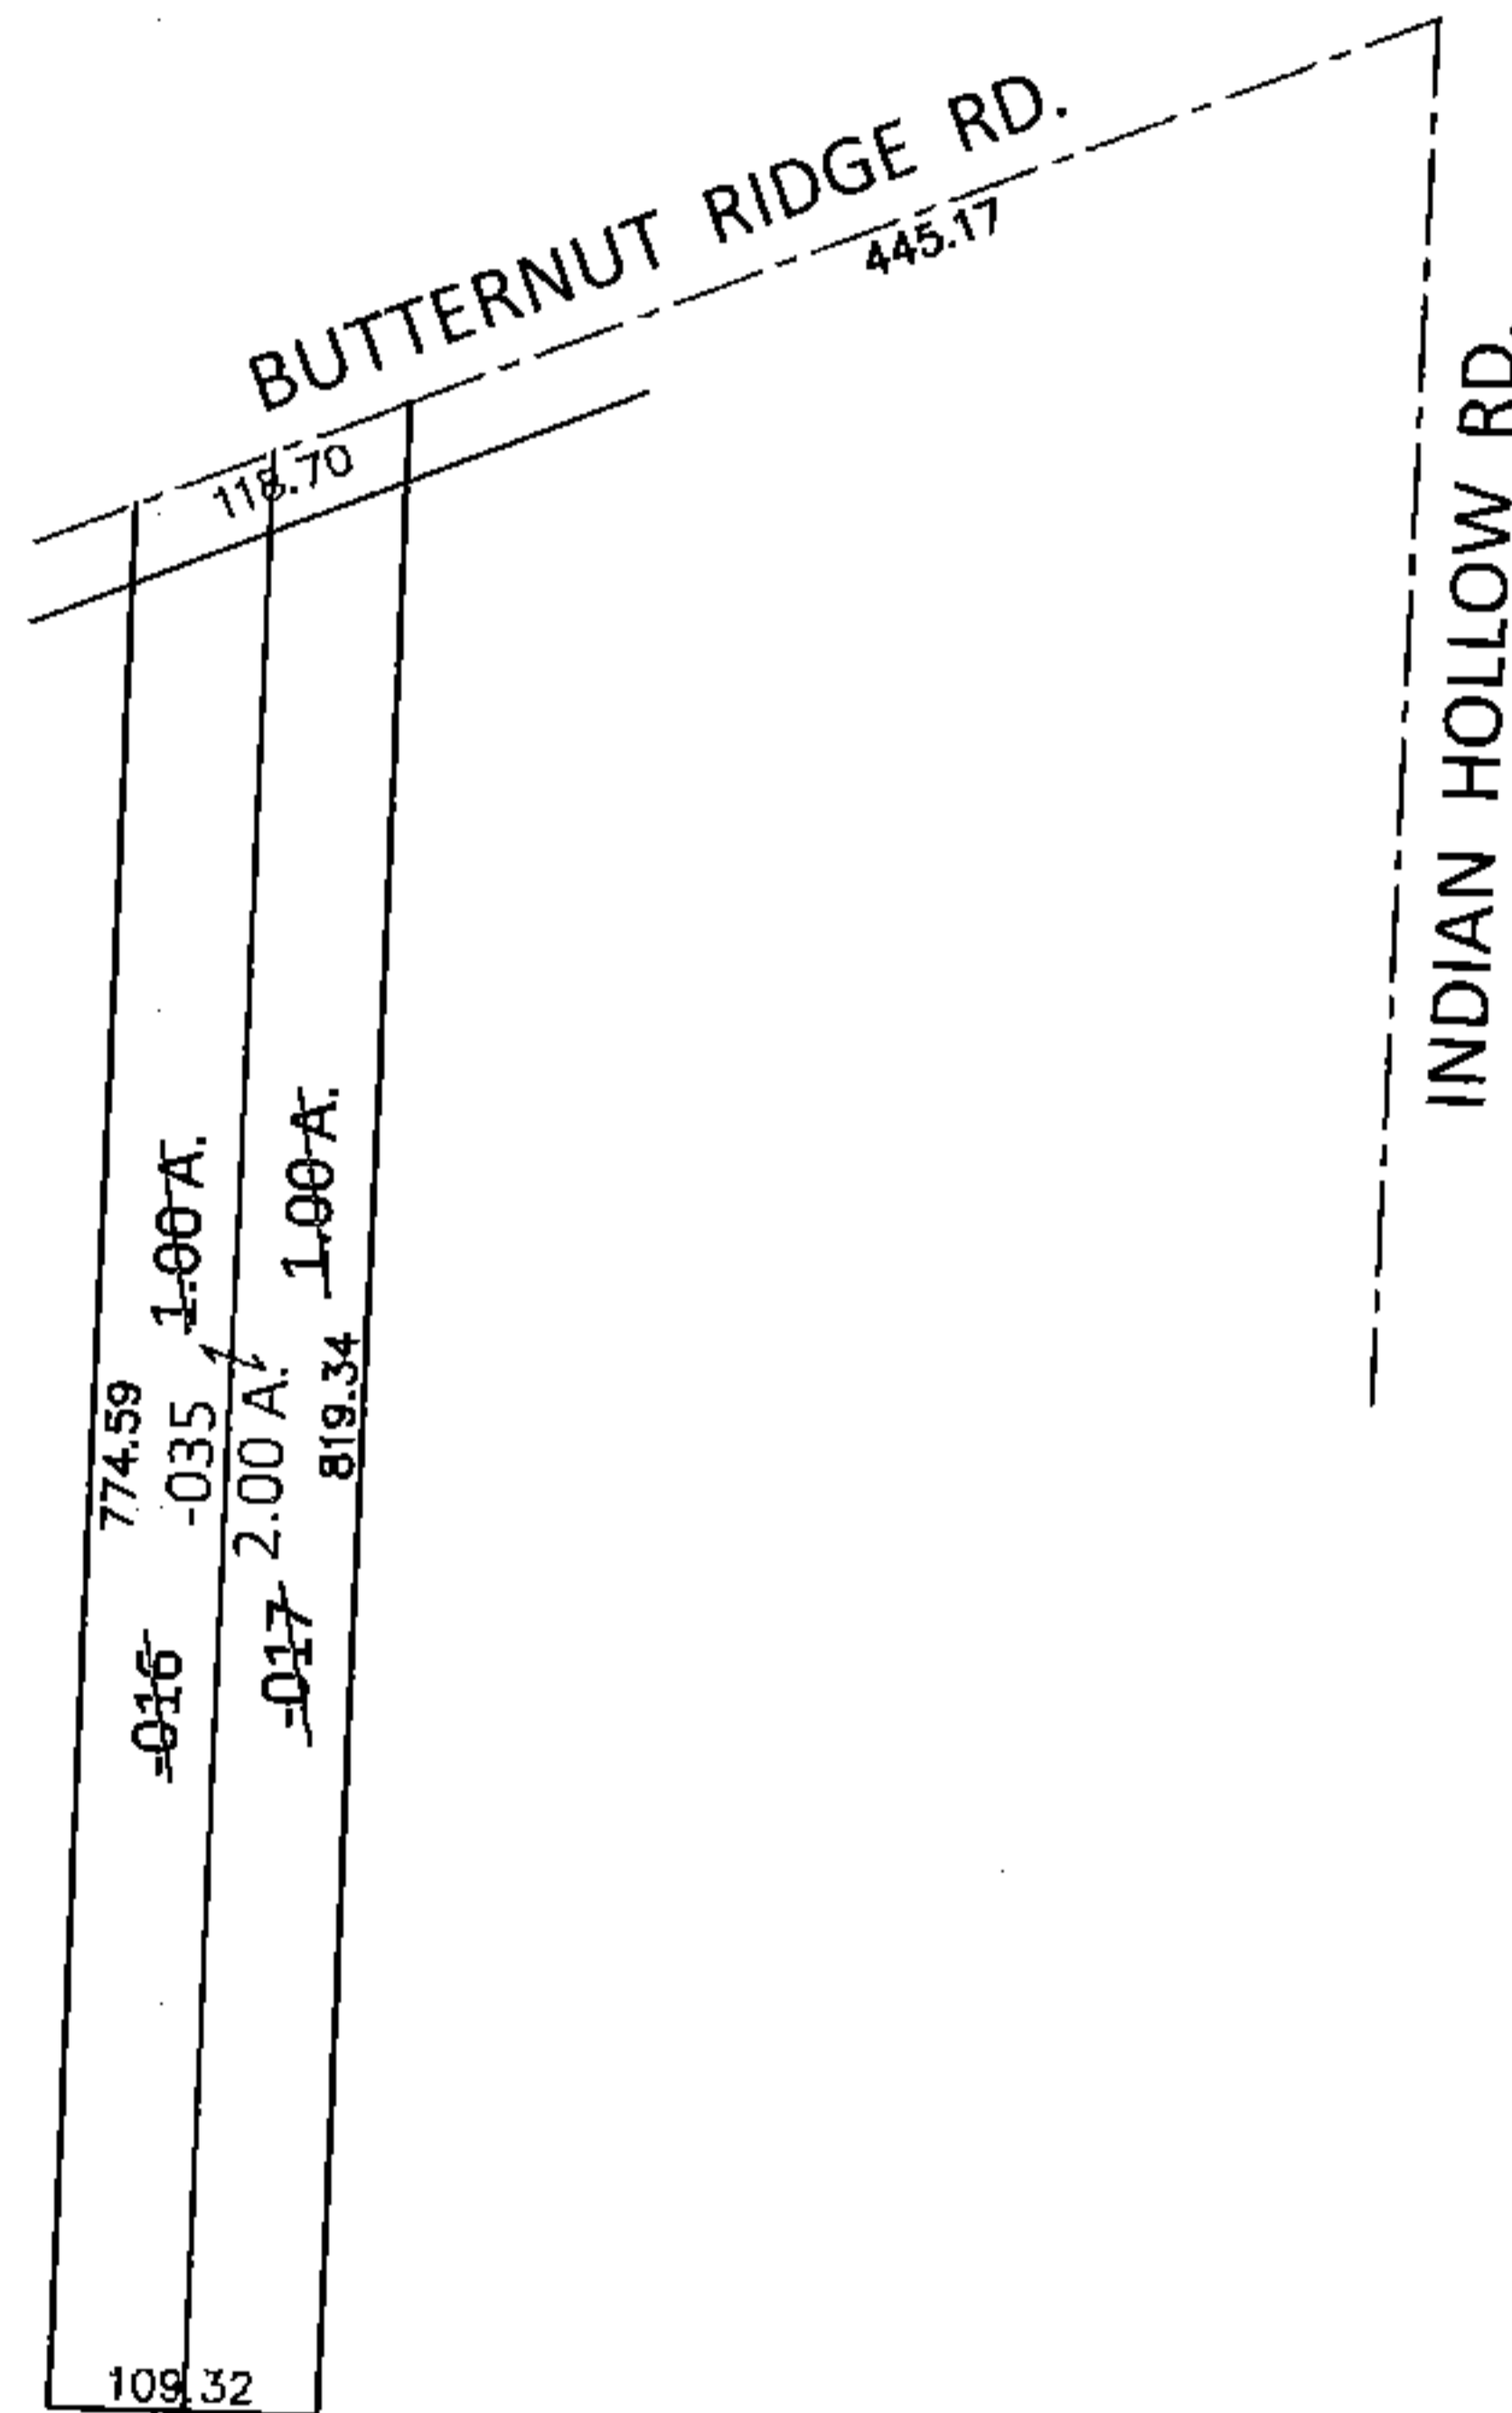


PARENT PARCEL: 10-00-007-109-016, -017

CHILD PARCEL: 10-00-007-109-035

STARTING POINT: INTERSECTION OF C/L OF BUTTERNUT RIDGE RD. AND C/L OF INDIAN HOLLOW RD.

14-03067-X

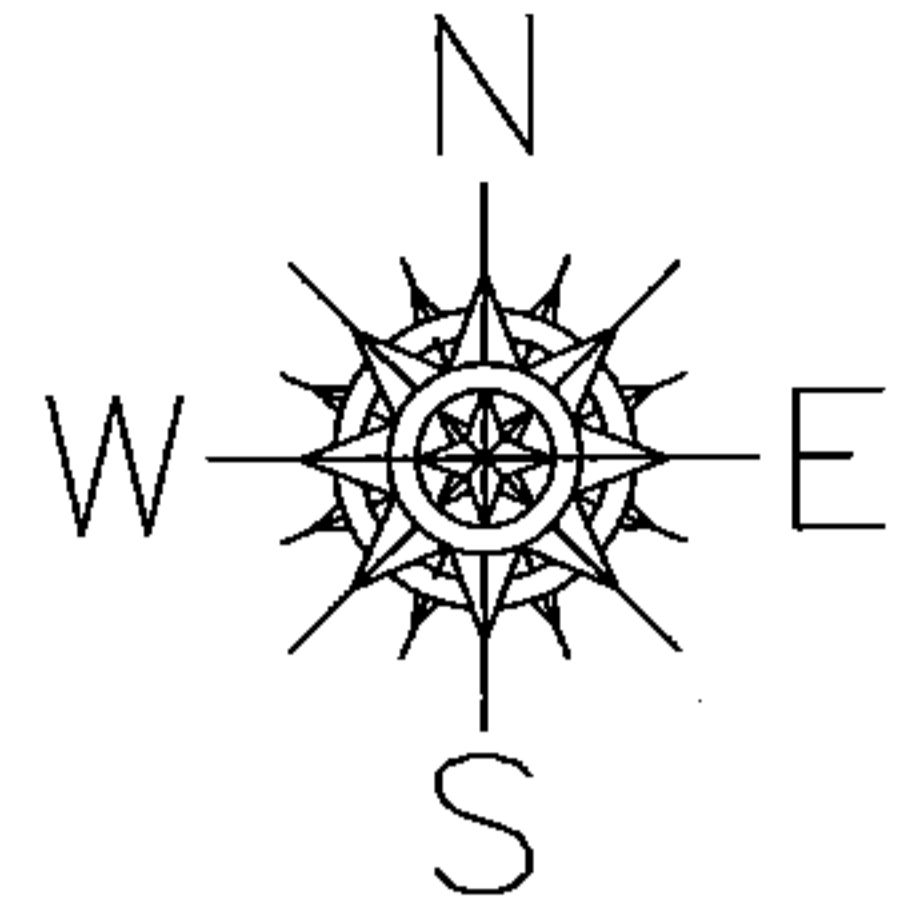

SPLITS/DEEDS PROCESSED

LORAIN COUNTY TAX MAP DEPARTMENT
226 MIDDLE AVE. ELYRIA, OHIO

SURVEYED BY: WARDEN & LAUNDON

CLOSURE: .01:10,000

MAP PAGE(S): 10-00-007-H

APPROVED BY: RRM DATE: 12-4-14

SCALE: 1"= 200 PRIOR INST.: 20020817193