

PARENT PARCEL: 19-03-031-000-003, -002 SEE BELOW FOR ACREAGE CORR NUMBERS

CHILD PARCEL: 19-03-031-000-004

STARTING POINT: NORTHEAST CORNER OF O.L. 32 & CENTERLINE OF ST RT 18


12-03067

19-03-032-000-002

19-02-030-000-056

19-03-033-000-001

ST RT 18

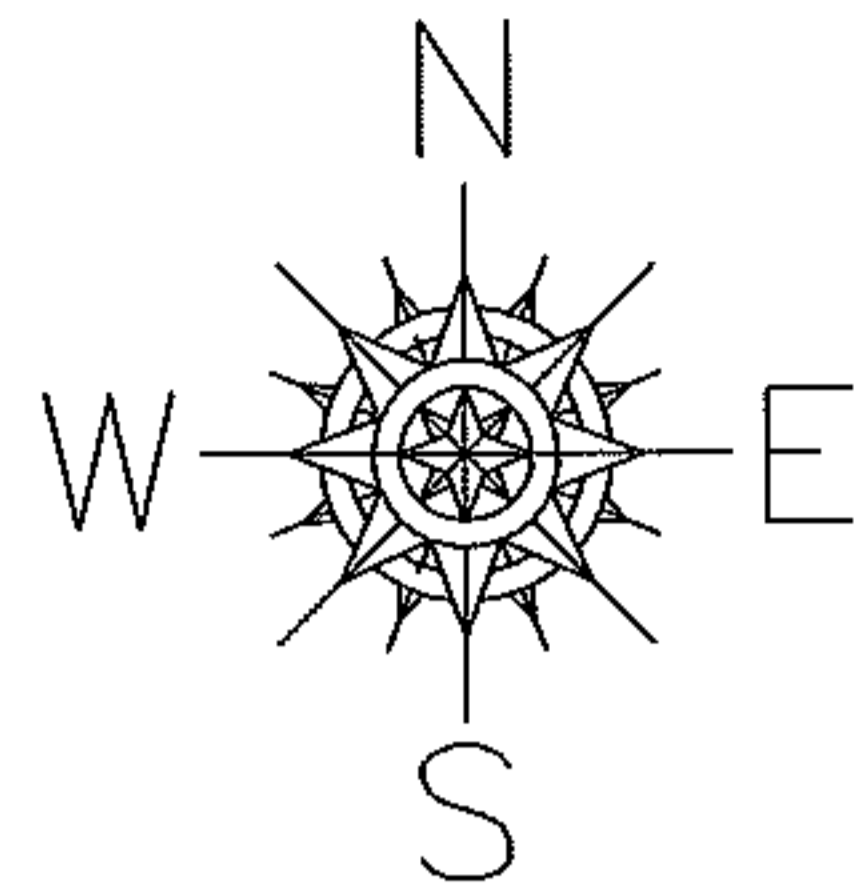

~~-001~~
~~19.77 A.~~
17.46 A.
A CORR SURVEY
DOUGLAS JEWELL

O.L. 33

O.L. 32

~~-002~~
~~33.00 A.~~
35.24 A.
A CORR SURVEY
DOUGLAS JEWELL

O.L. 32

O.L. 31

~~-004~~
~~108.56 A.~~
108.13 A.
A CORR SURVEY
DOUGLAS JEWELL

~~-002~~
~~70.81 A.~~

~~-003~~
~~37.75 A.~~

TRACT 3
O.L. 31

TRACT 2
O.L. 30

~~-056~~
~~36.52 A.~~
36.50 A.
A CORR SURVEY
DOUGLAS JEWELL

JONES RD

SPLITS/DEEDS PROCESSED

LORAIN COUNTY TAX MAP DEPARTMENT
226 MIDDLE AVE. ELYRIA, OHIO

SURVEYED BY: DOUGLAS JEWELL

CLOSURE: 0.00 : 10,000

MAP PAGE(S): 19-G

APPROVED BY: JAH DATE: 9-10-2012

SCALE: 1" = 700 PRIOR INSTRUMENT: OR 1191/392