


PARENT PARCEL: 03-00-113-104-046, -107

CHILD PARCEL: 03-00-113-104-114 THRU -116



STARTING POINT: CENTERLINE OF COOPER FOSTER PARK RD & BROADWAY AVE

12-03069

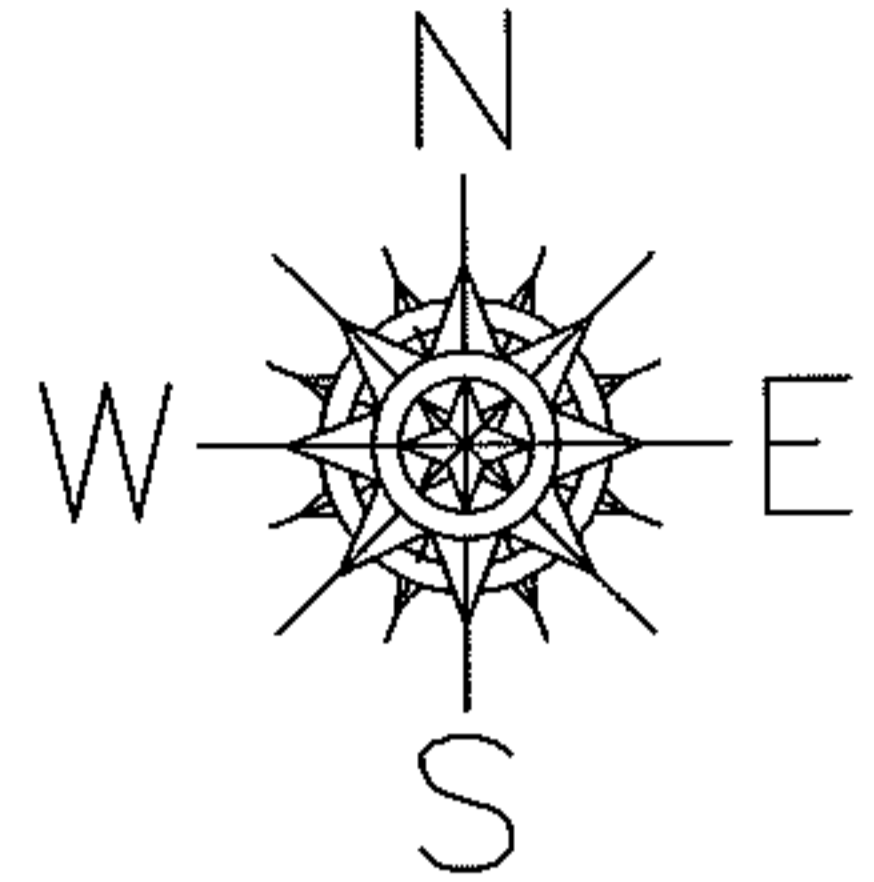

BROADWAY (PENFIELD) AVE

COOPER FOSTER PARK RD

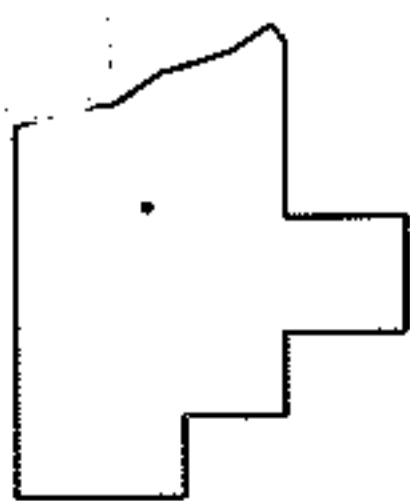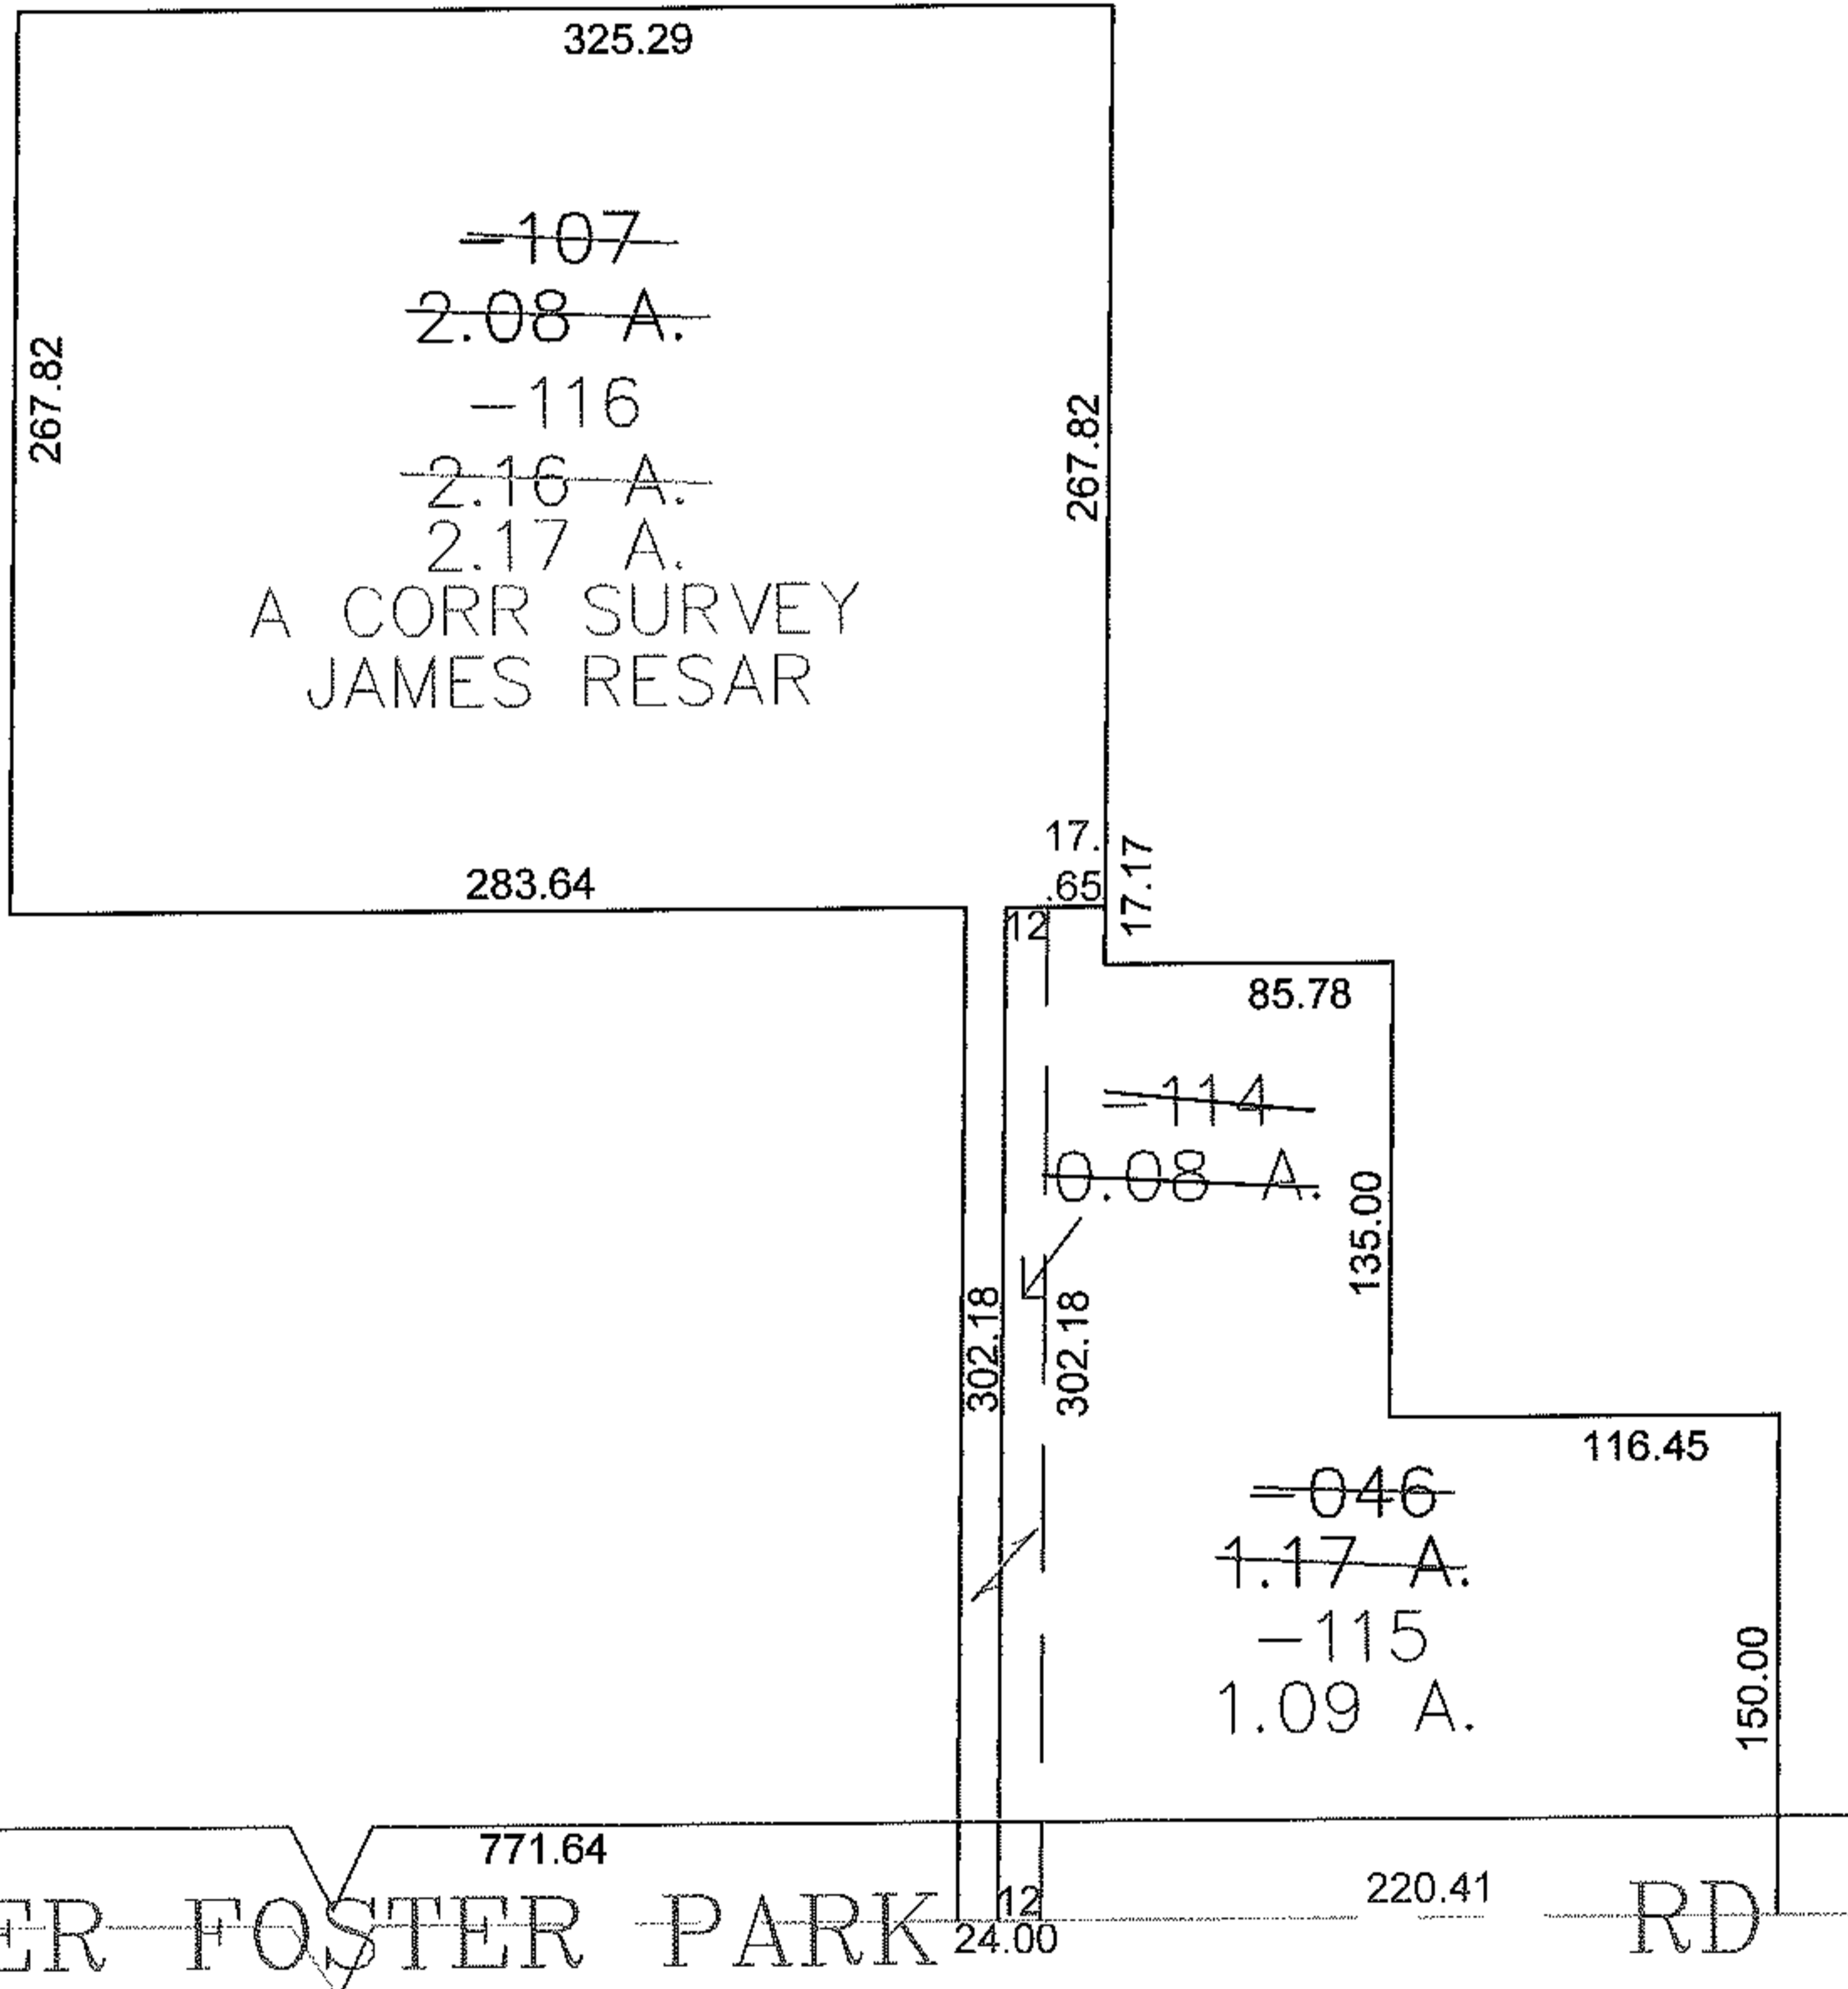

SPLITS/DEEDS PROCESSED

LORAIN COUNTY TAX MAP DEPARTMENT
226 MIDDLE AVE. ELYRIA, OHIO

SURVEYED BY: JAMES RESAR
 CLOSURE: 0.00 : 10.000
 MAP PAGE(S): 03-00-113-A
 APPROVED BY: JAH DATE: 9-19-2012
 SCALE: 1" = 100 PRIOR INSTRUMENT: 20090301594