
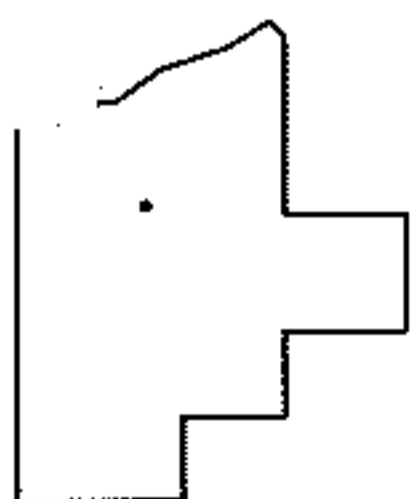
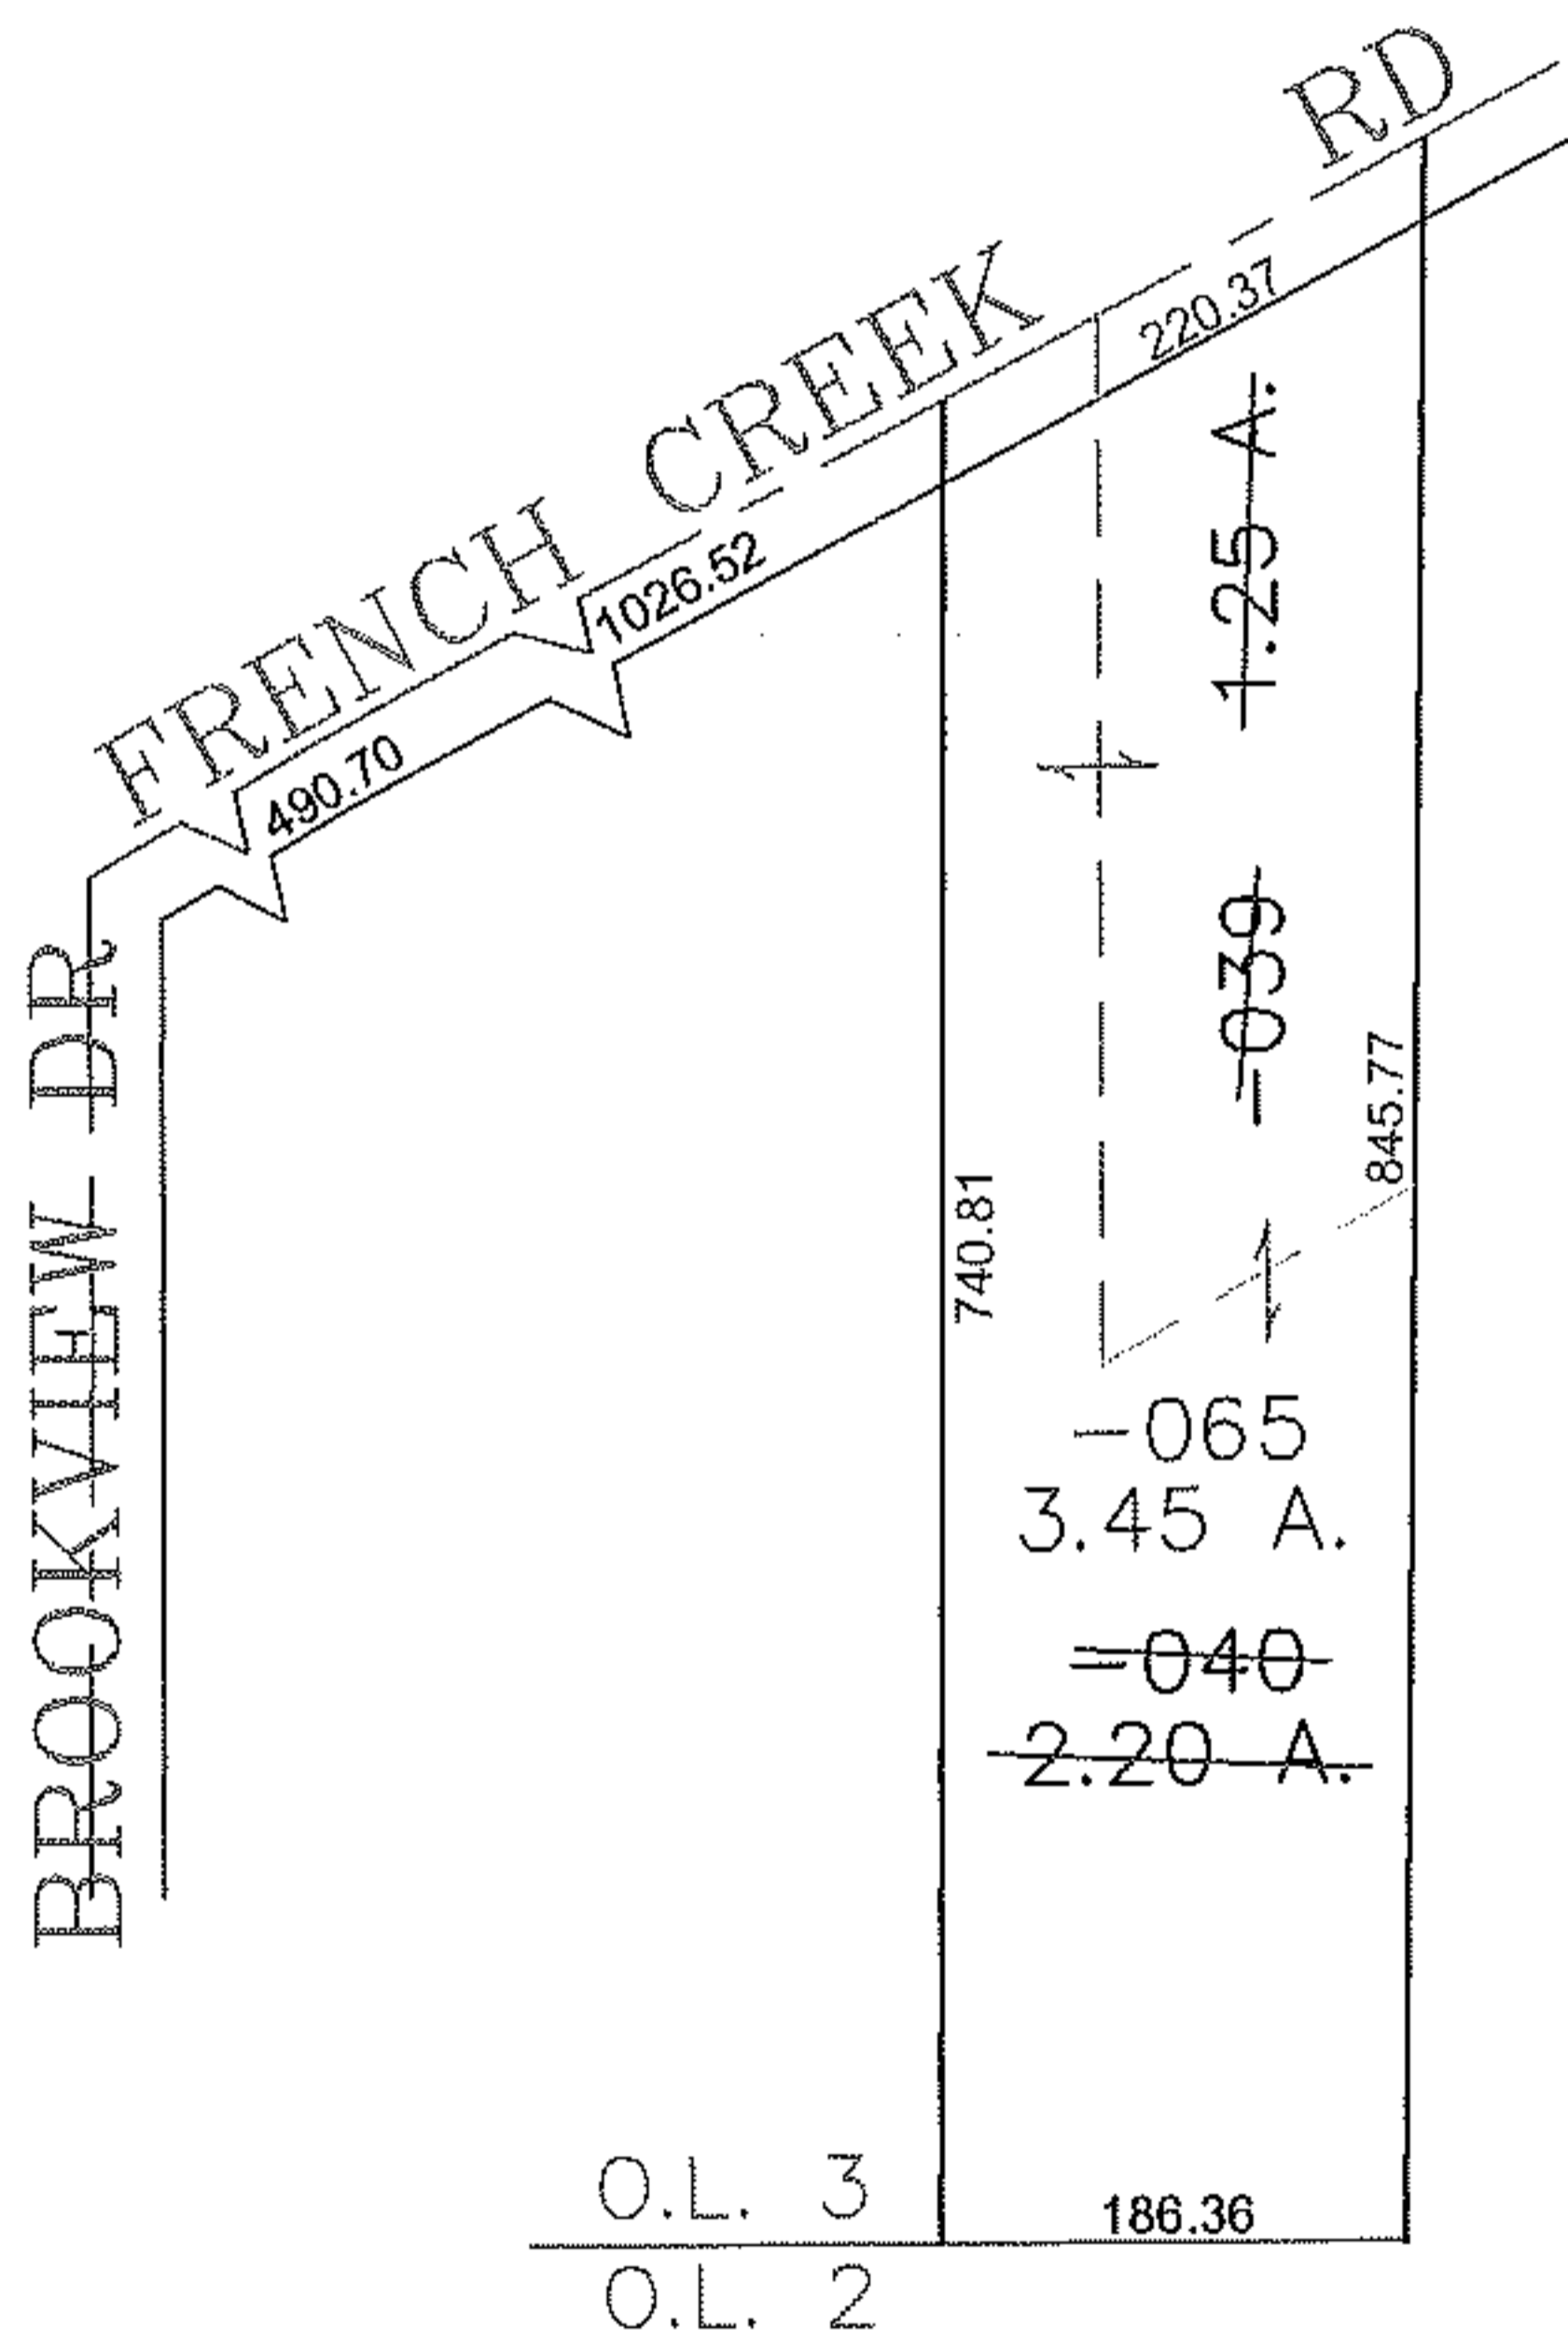


PARENT PARCEL: 04-00-003-103-039, -040

CHILD PARCEL: 04-00-003-103-065

STARTING POINT: CENTERLINE OF BROOKVIEW DR & FRENCH CREEK RD

12-03070

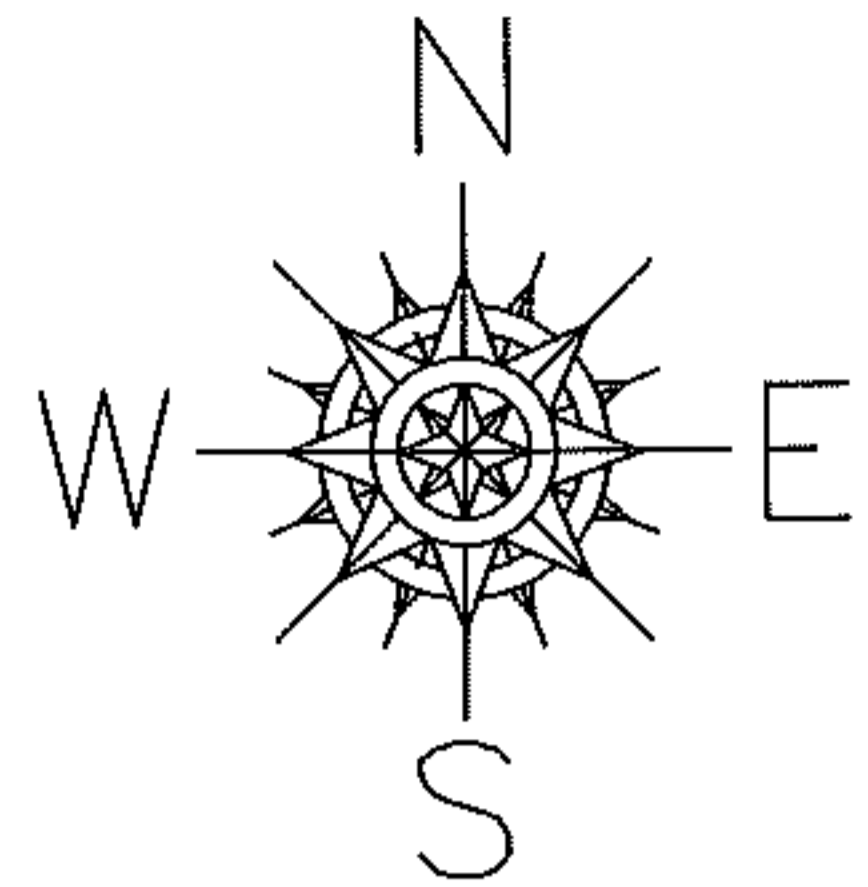

SPLITS/DEEDS PROCESSED
 LORAIN COUNTY TAX MAP DEPARTMENT
 226 MIDDLE AVE. ELYRIA, OHIO

SURVEYED BY: DANE HAPONEK
 CLOSURE: 0.00 : 10,000
 MAP PAGE(S): 04-00-003-H
 APPROVED BY: JAH DATE: 9/26/2012
 SCALE: 1" = 200 PRIOR INSTRUMENT: 20060129007