
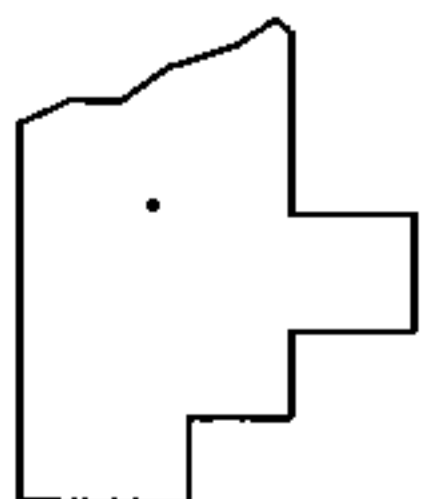
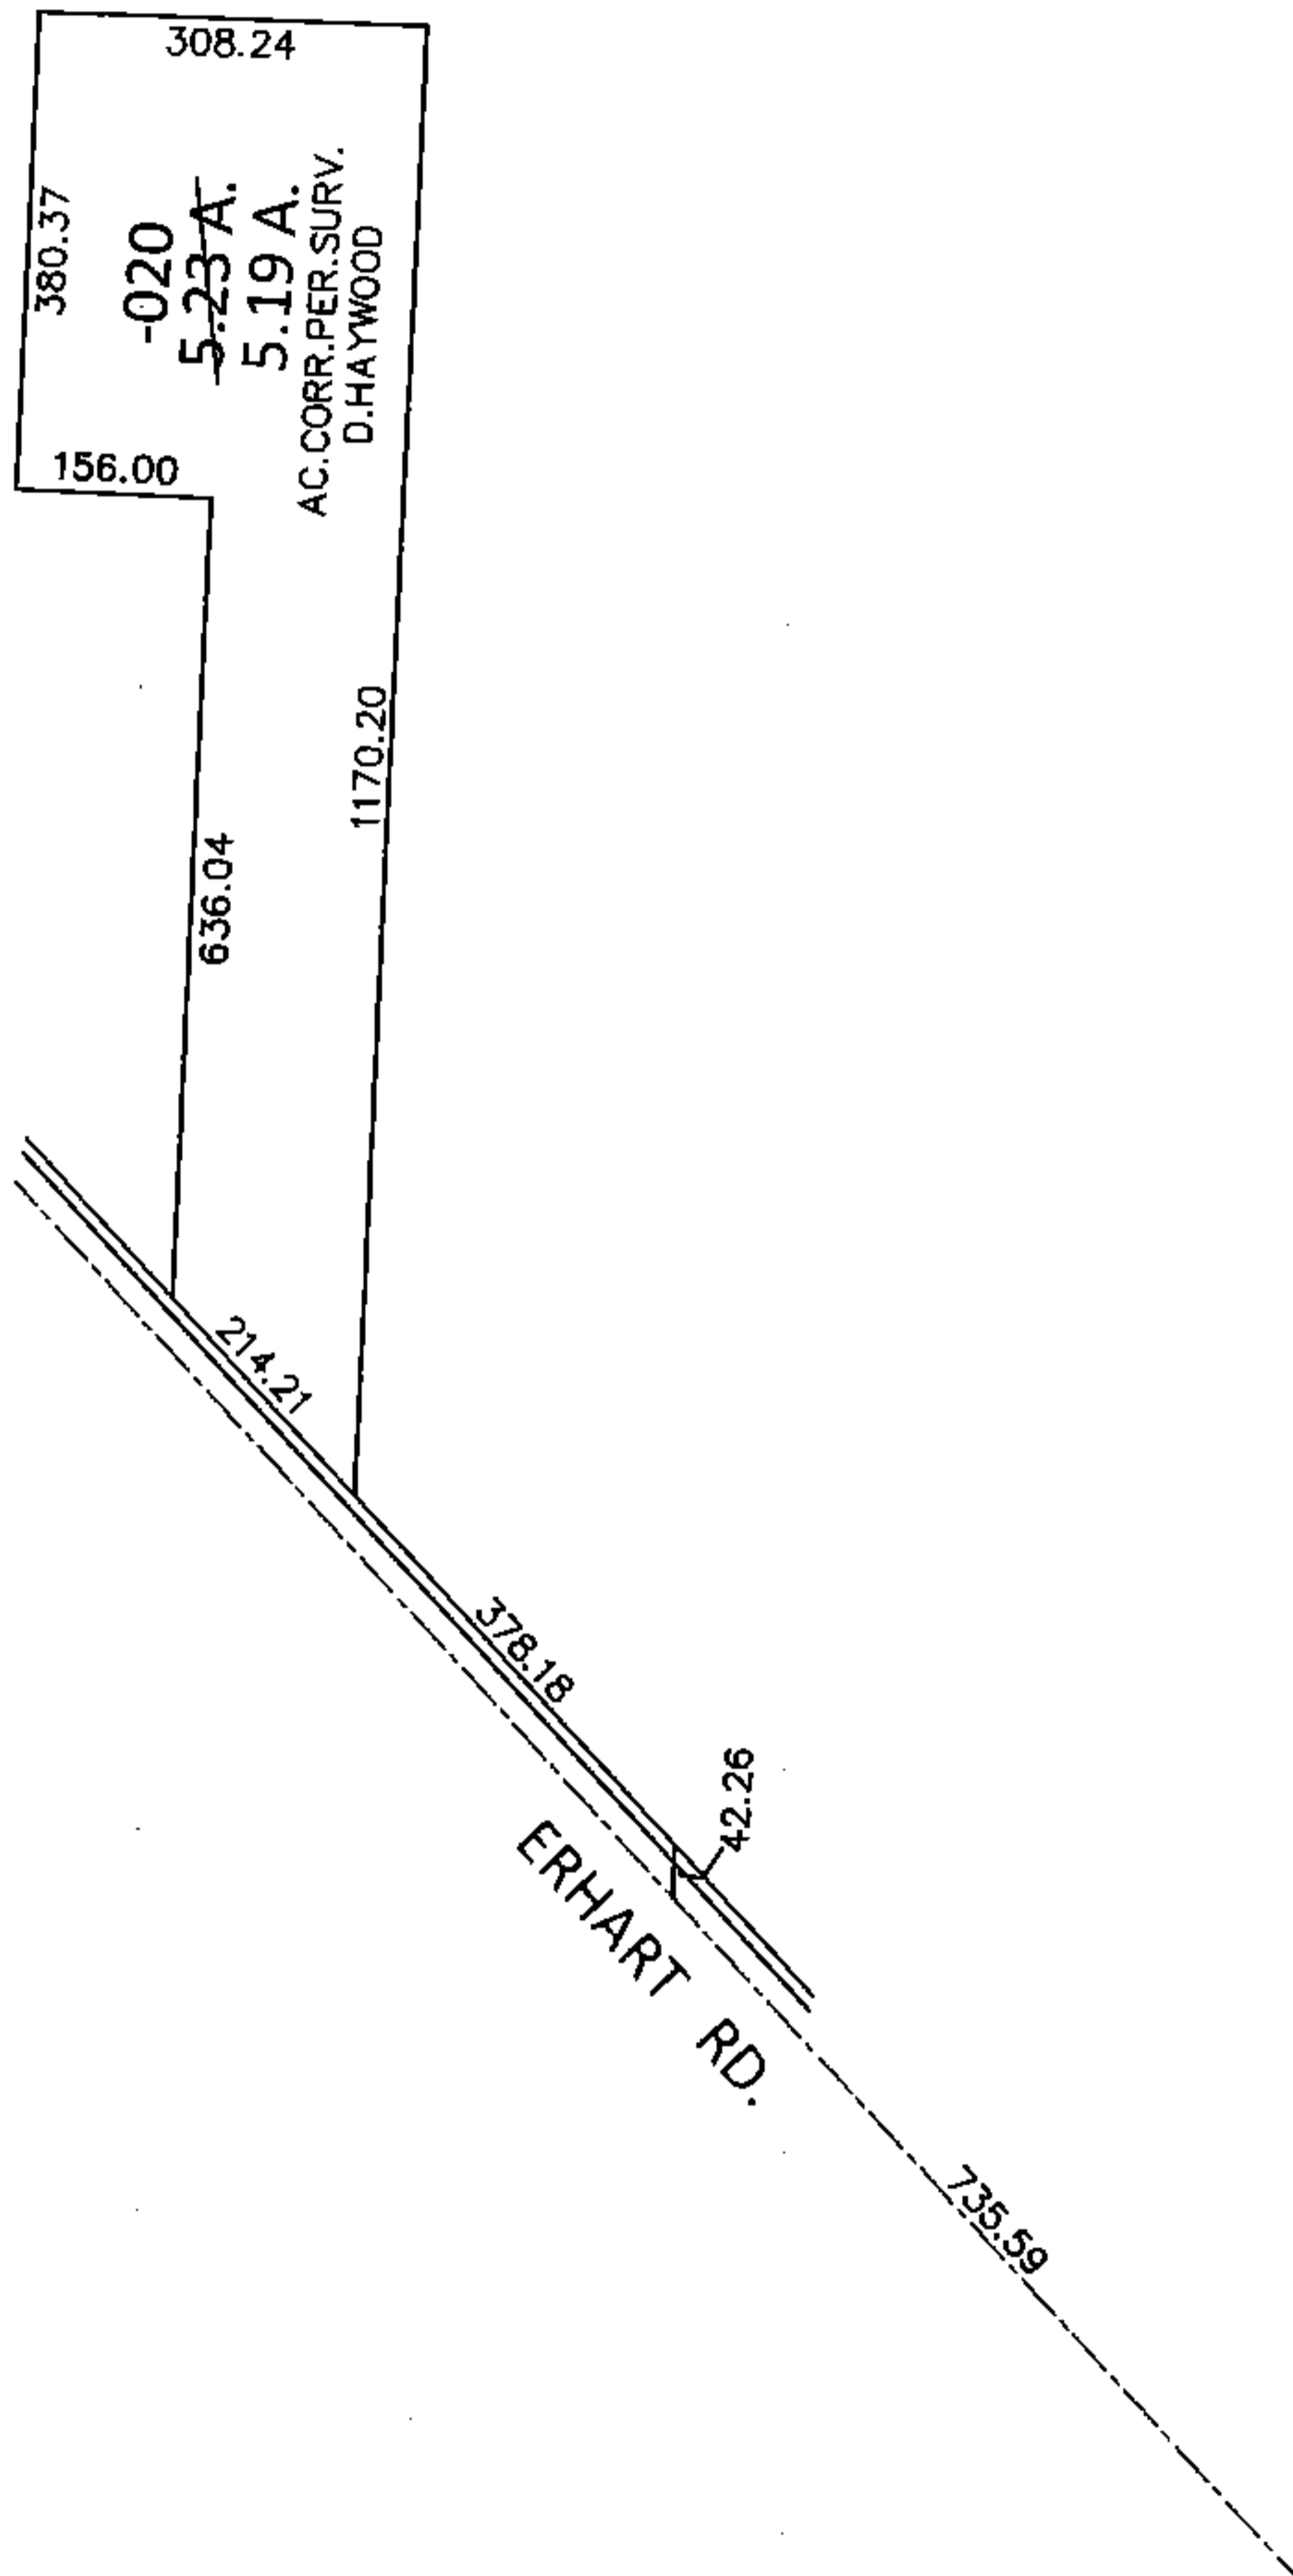


PARENT PARCEL: 16-00-091-000-020

CHILD PARCEL: _____

STARTING POINT: INTERSECTION OF C/L OF ERHART RD. AND C/L OF ERHART - NORTHERN RD.

14-03071-X

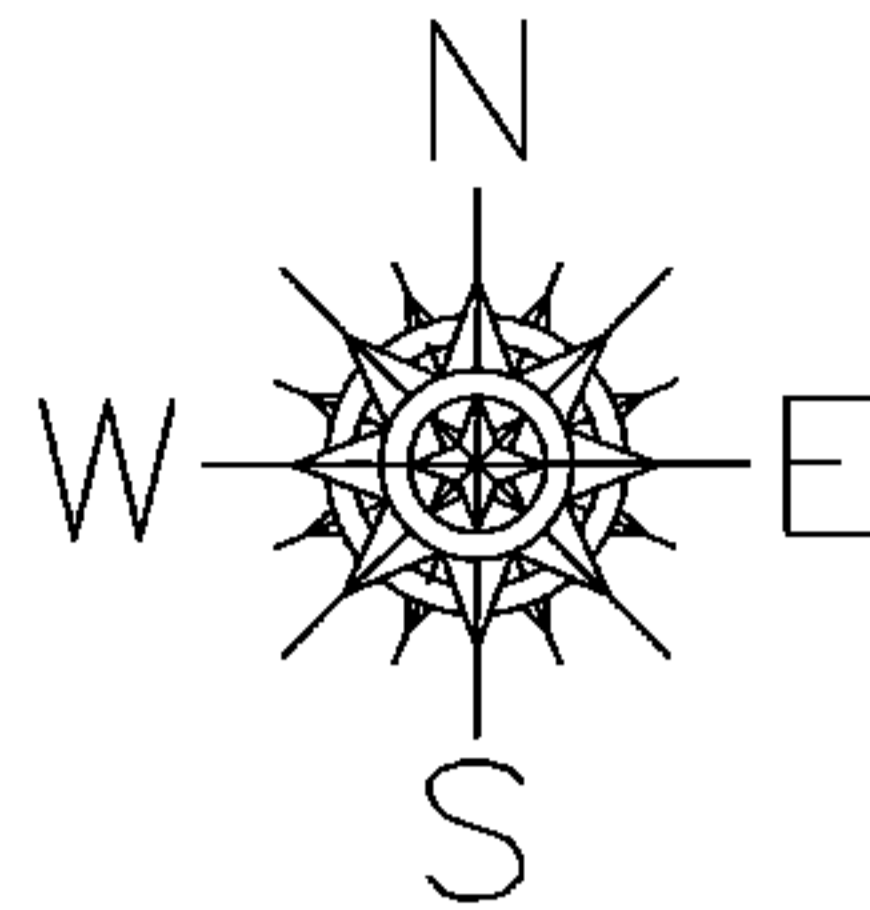

SPLITS/DEEDS PROCESSED

LORAIN COUNTY TAX MAP DEPARTMENT
226 MIDDLE AVE. ELYRIA, OHIO

SURVEYED BY: DALE R. HAYWOOD

CLOSURE: .01:10,000

MAP PAGE(S): 16-00-091-B

APPROVED BY: RRM DATE: 12-12-14

SCALE: 1"= 300 PRIOR INST.: 20130443589