
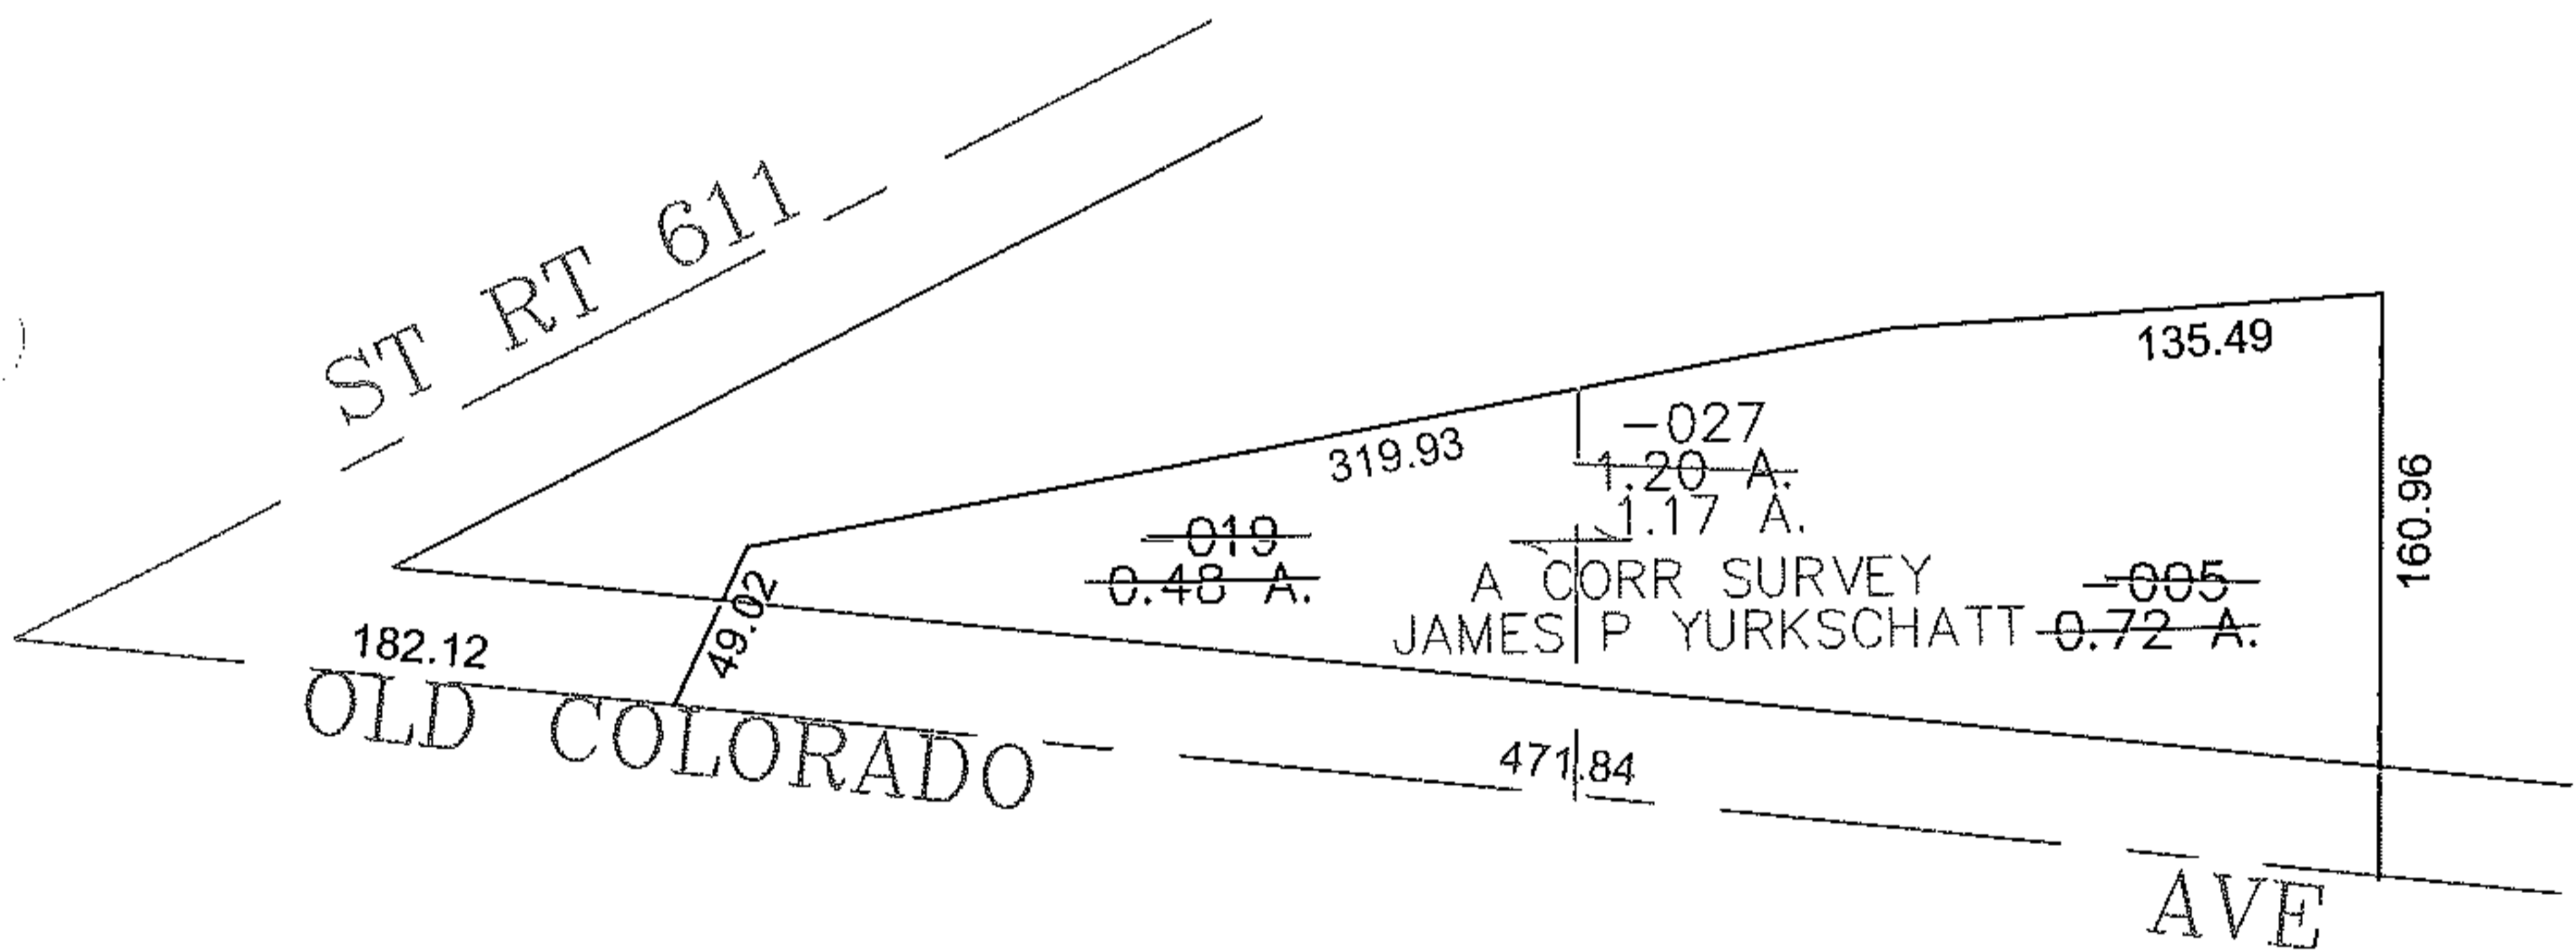


PARENT PARCEL: 03-00-022-102-005, -019

CHILD PARCEL: 03-00-022-102-027

STARTING POINT: CENTERLINE OF ST RT 611 & OLD COLORADO AVE

12-03072

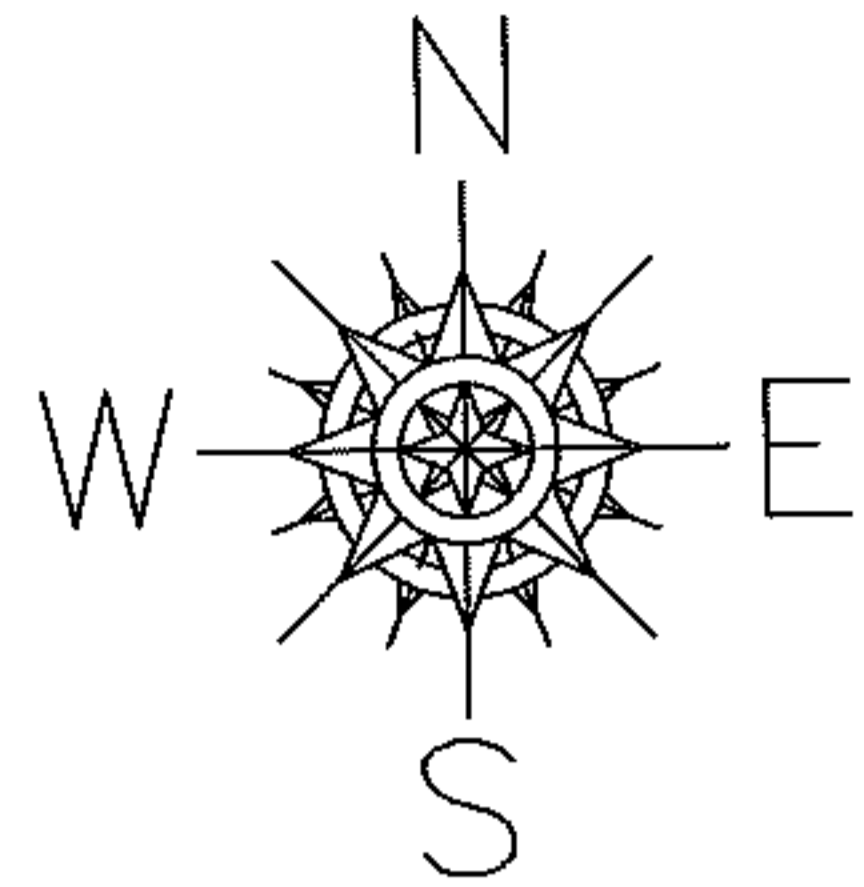

SPLITS/DEEDS PROCESSED

LORAIN COUNTY TAX MAP DEPARTMENT
226 MIDDLE AVE. ELYRIA, OHIO

SURVEYED BY: JAMES P YURKSCHATT

CLOSURE: 0.00 : 10.000

MAP PAGE(S): 03-00-022-A

APPROVED BY: JAH DATE: 9-27-2012

SCALE: 1" = 100 PRIOR INSTRUMENT: 19990612066