




RASVBL

PARENT PARCEL: 07-00-024-101-105, -104

CHILD PARCEL: 07-00-024-101-112 THRU -116

STARTING POINT: CENTERLINE OF BUTTERNUT RIDGE RD & ST RT 83

12-03074

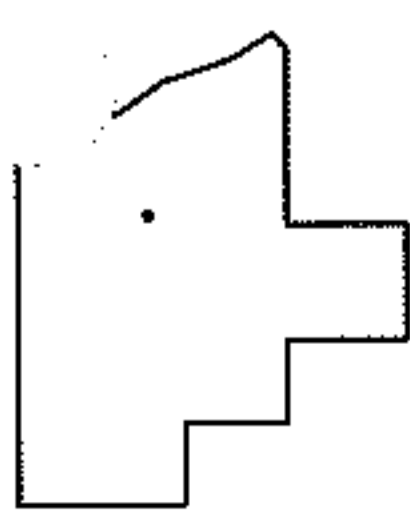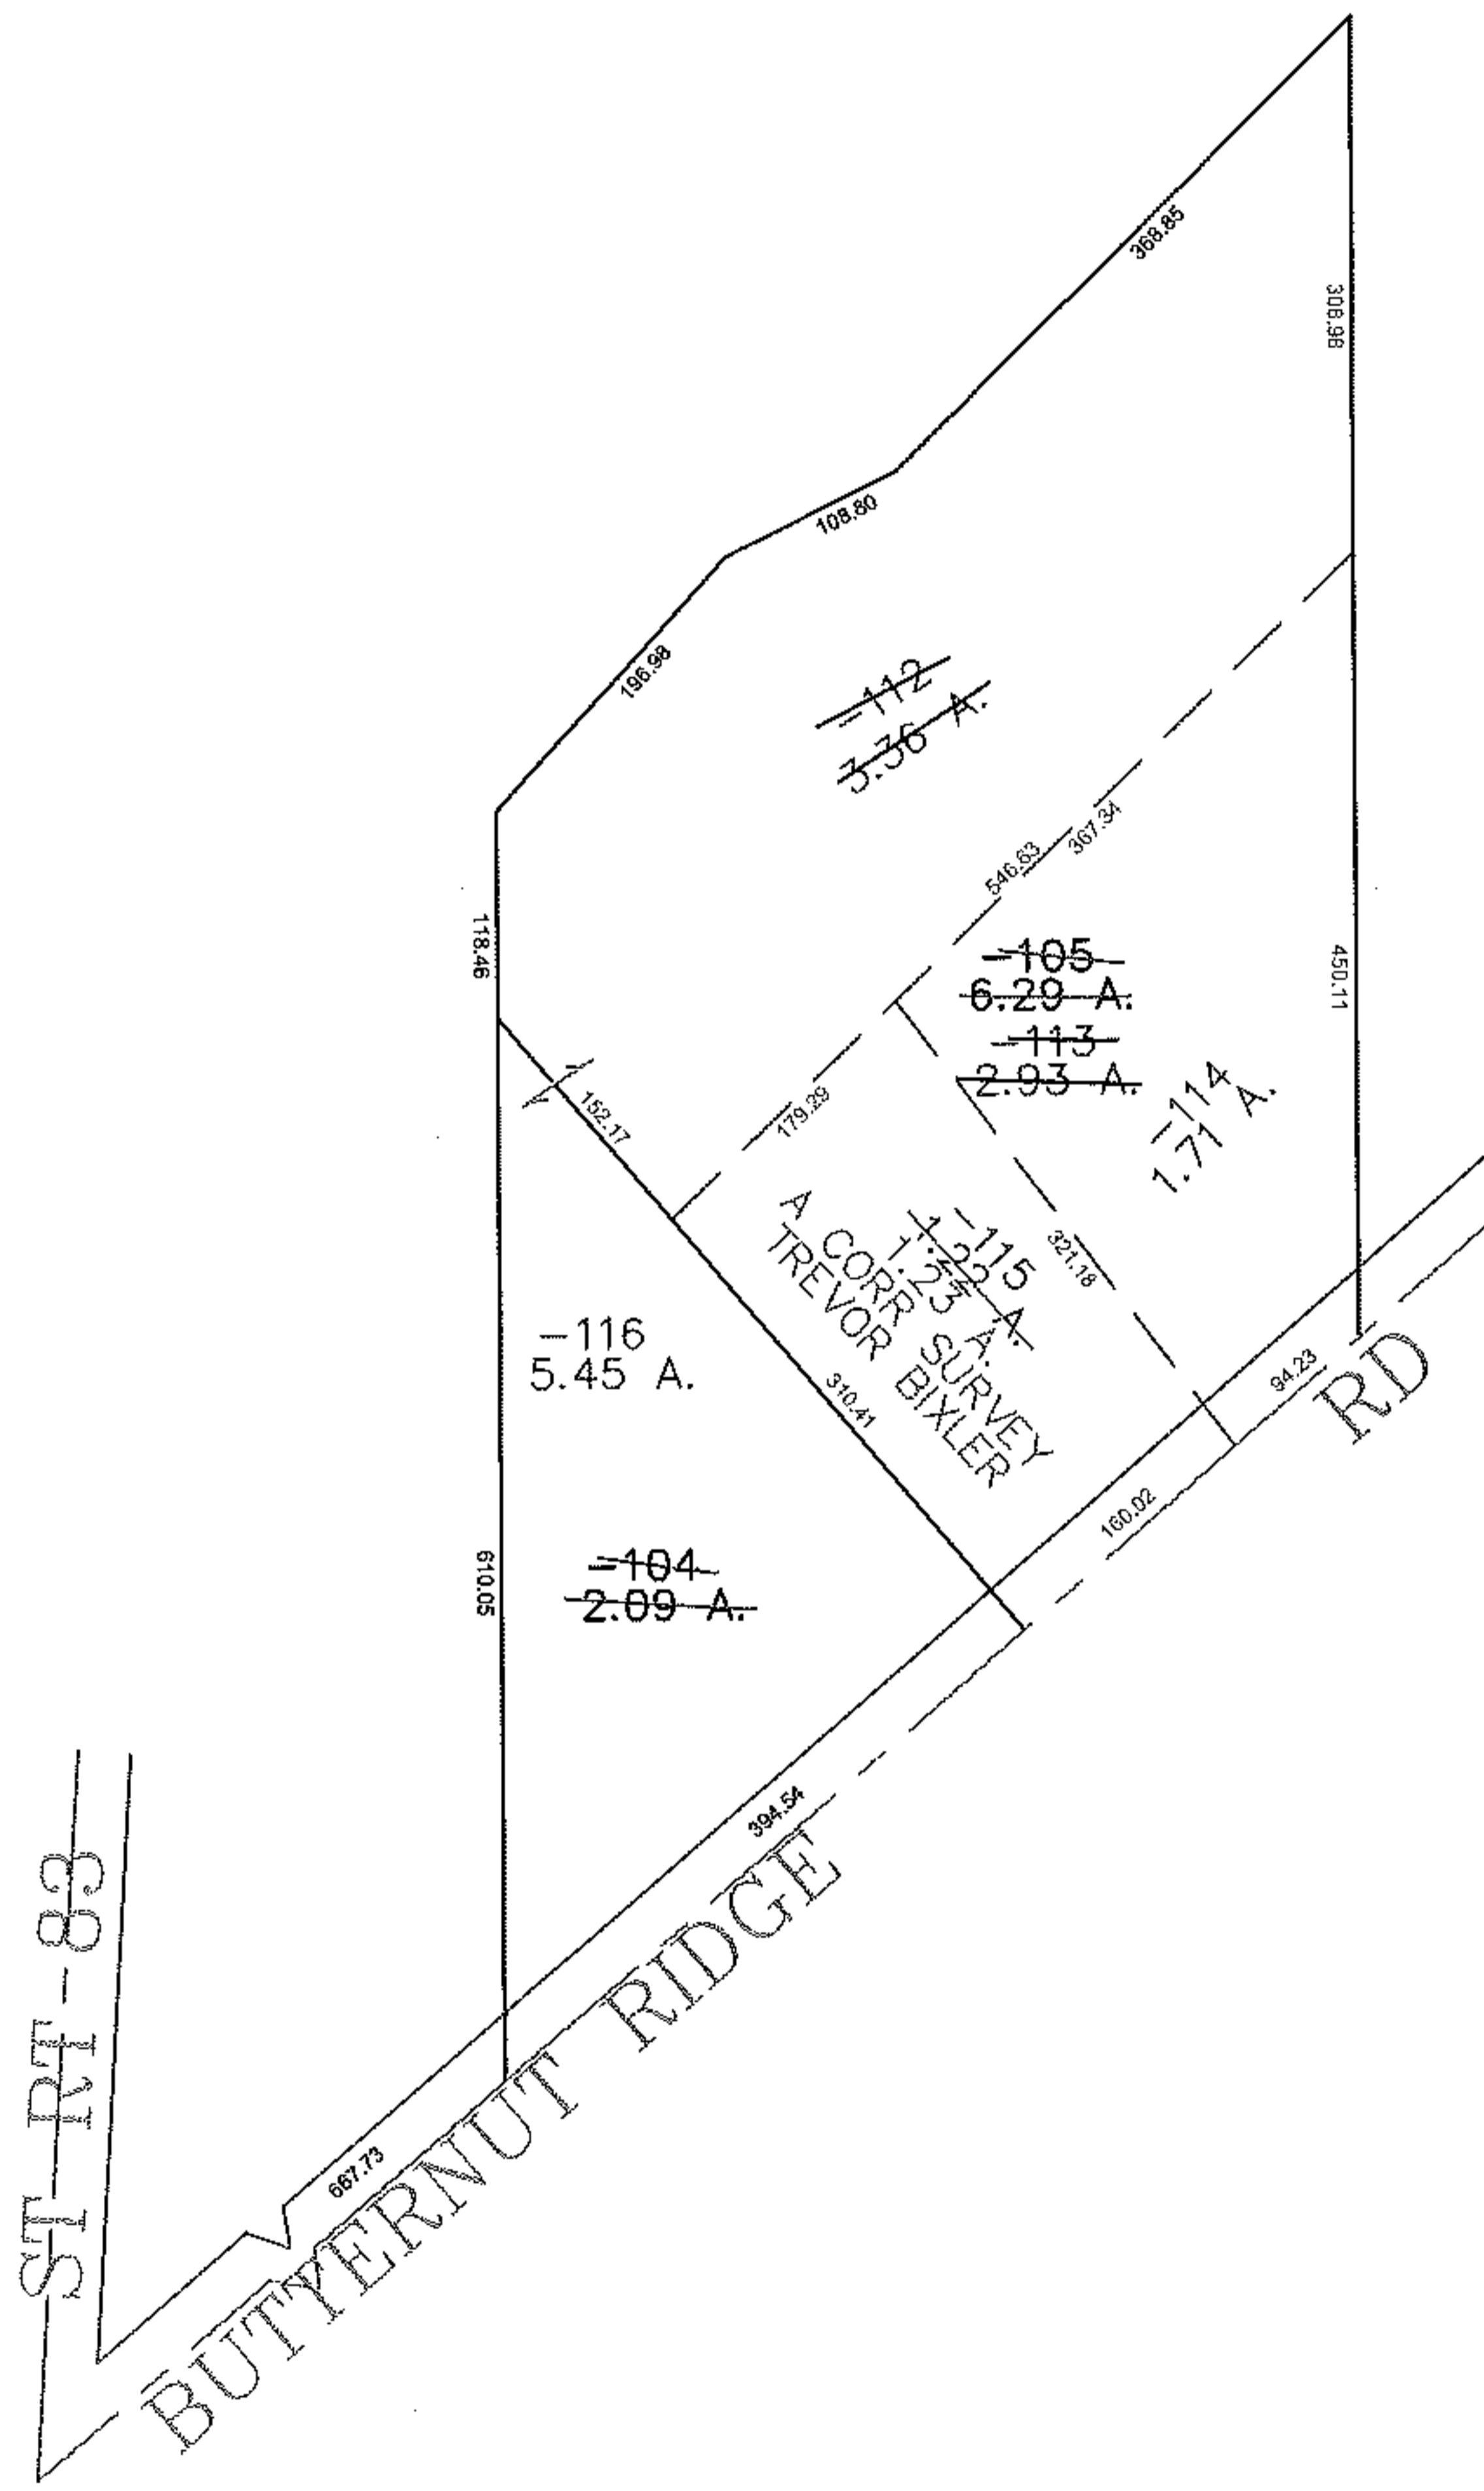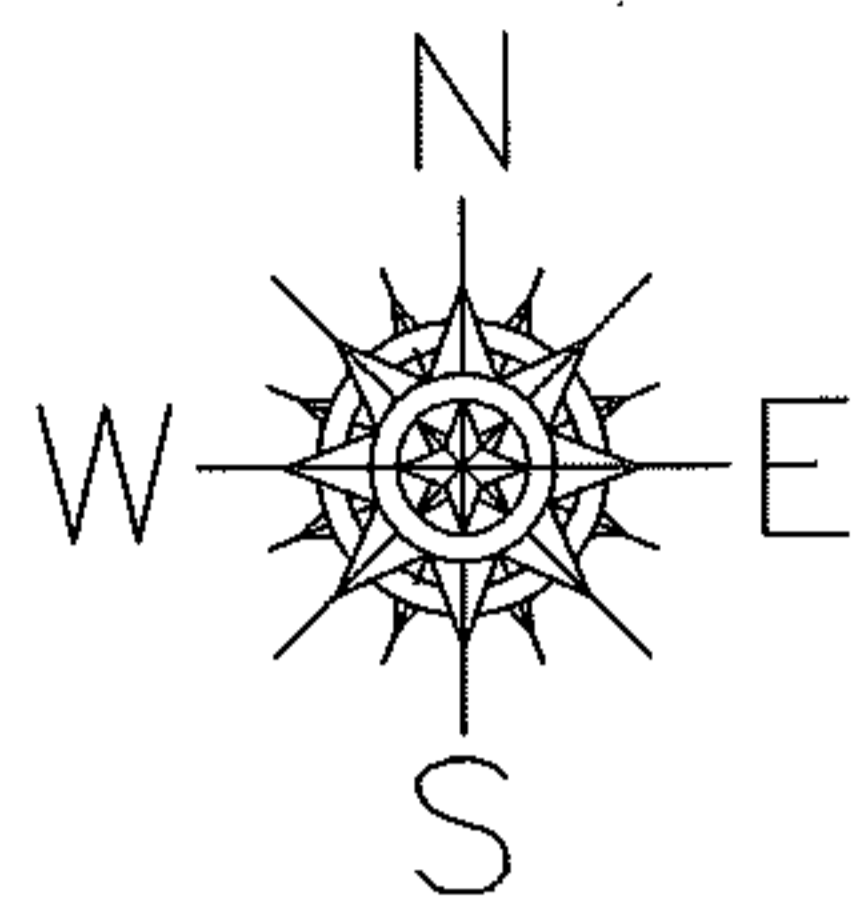

SPLITS/DEEDS PROCESSED
LORAIN COUNTY TAX MAP DEPARTMENT
226 MIDDLE AVE. ELYRIA, OHIO

SURVEYED BY: TREVOR BIXLER
CLOSURE: 0.00 : 10.000
MAP PAGE(S): 07-00-024-C
APPROVED BY: JAH DATE: 10-4-2012
SCALE: 1" = 200' PRIOR INSTRUMENT: 20000719377