
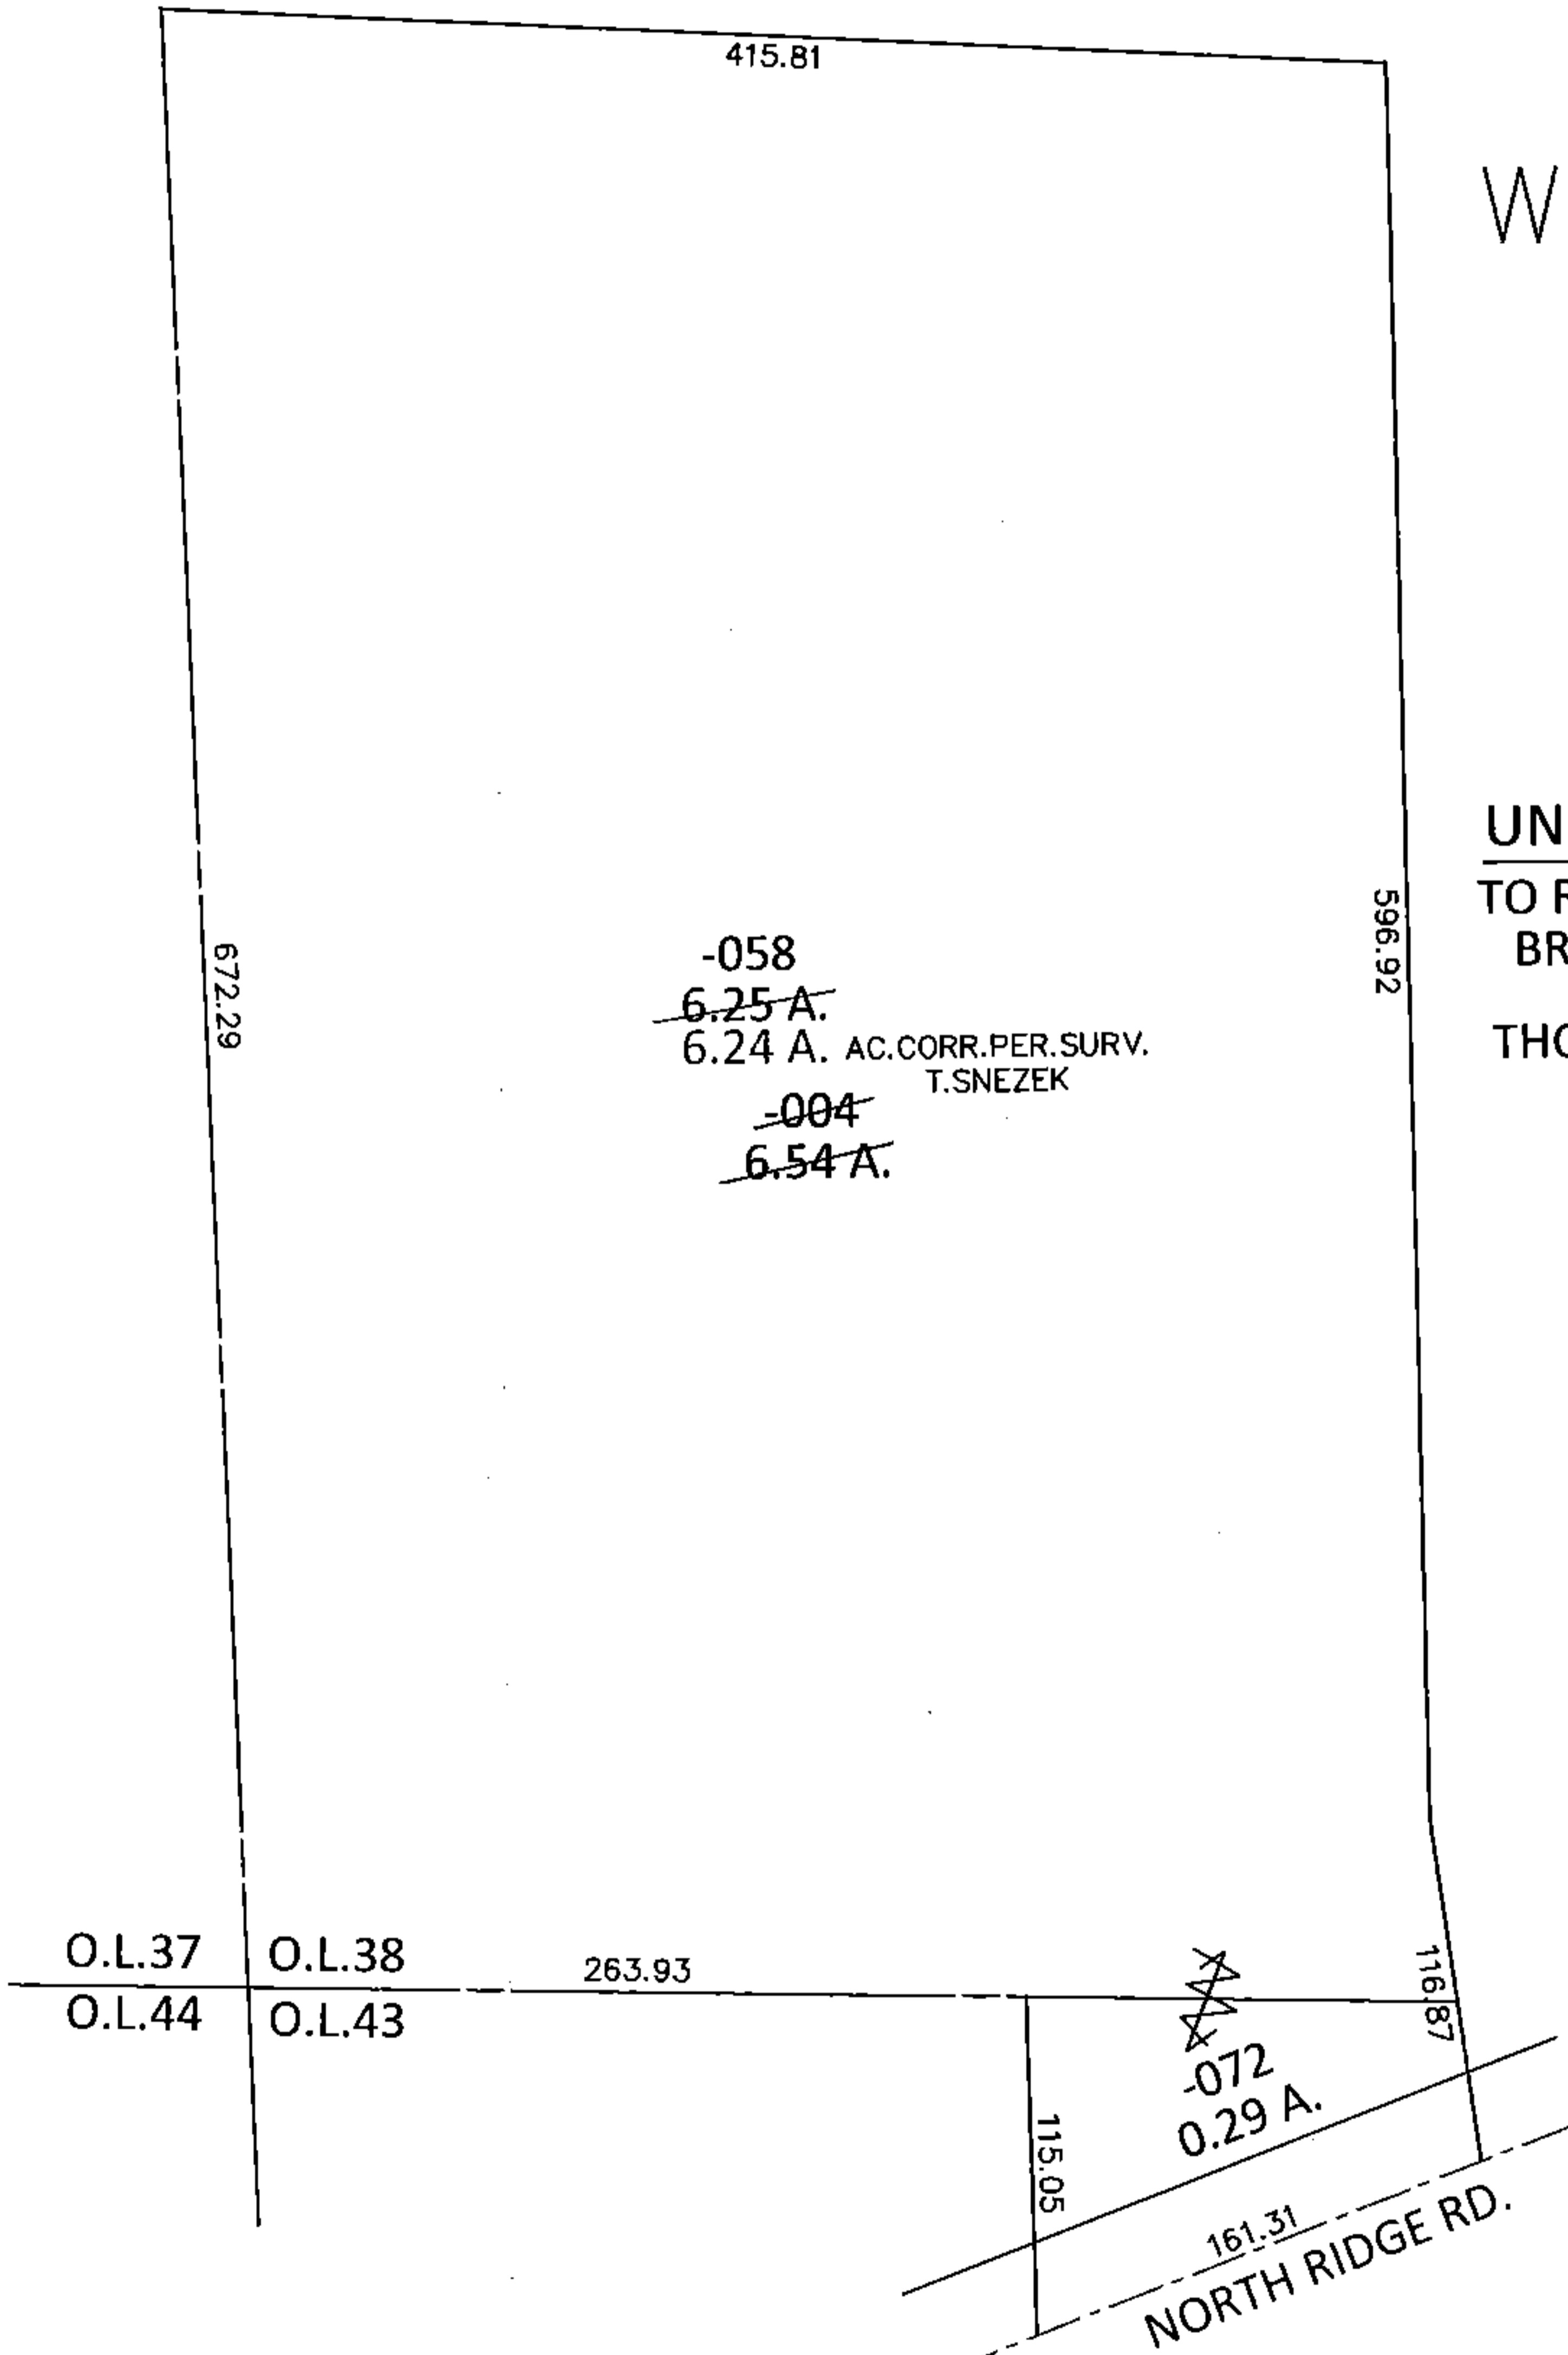


PARENT PARCEL: 01-00-038-000-004


CHILD PARCEL: 01-00-038-000-058, 01-00-043-000-072

STARTING POINT: SOUTHWEST CORNER OF O.L.38

14-03075-D

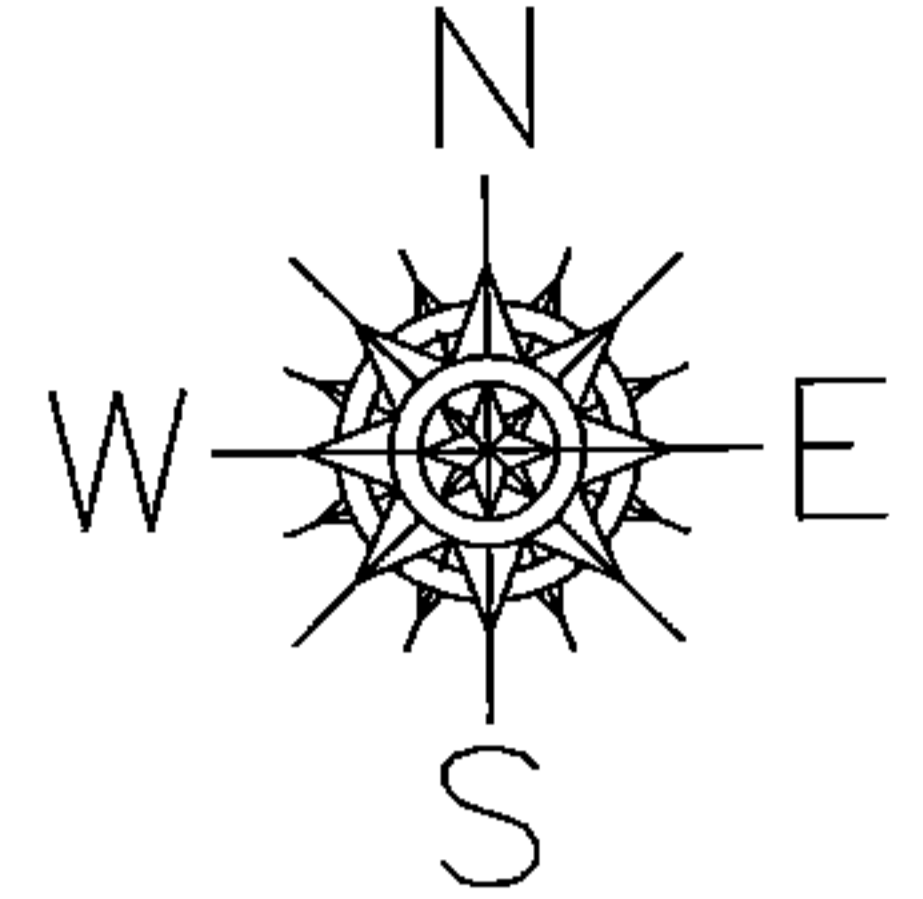

UNCOMBINATION
TO REFLECT ACREAGE
BREAKDOWN PER.
SURVEY BY
THOMAS M. SNEZEK

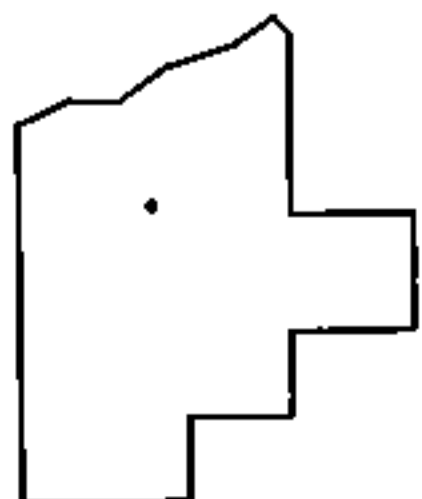

SPLITS/DEEDS PROCESSED

LORAIN COUNTY TAX MAP DEPARTMENT
226 MIDDLE AVE. ELYRIA, OHIO

SURVEYED BY: THOMAS M. SNEZEK

CLOSURE: .01:10,000

MAP PAGE(S): 1-G

APPROVED BY: RRM DATE: 12-19-14

SCALE: 1"= 100 PRIOR INST.: 20110360364