
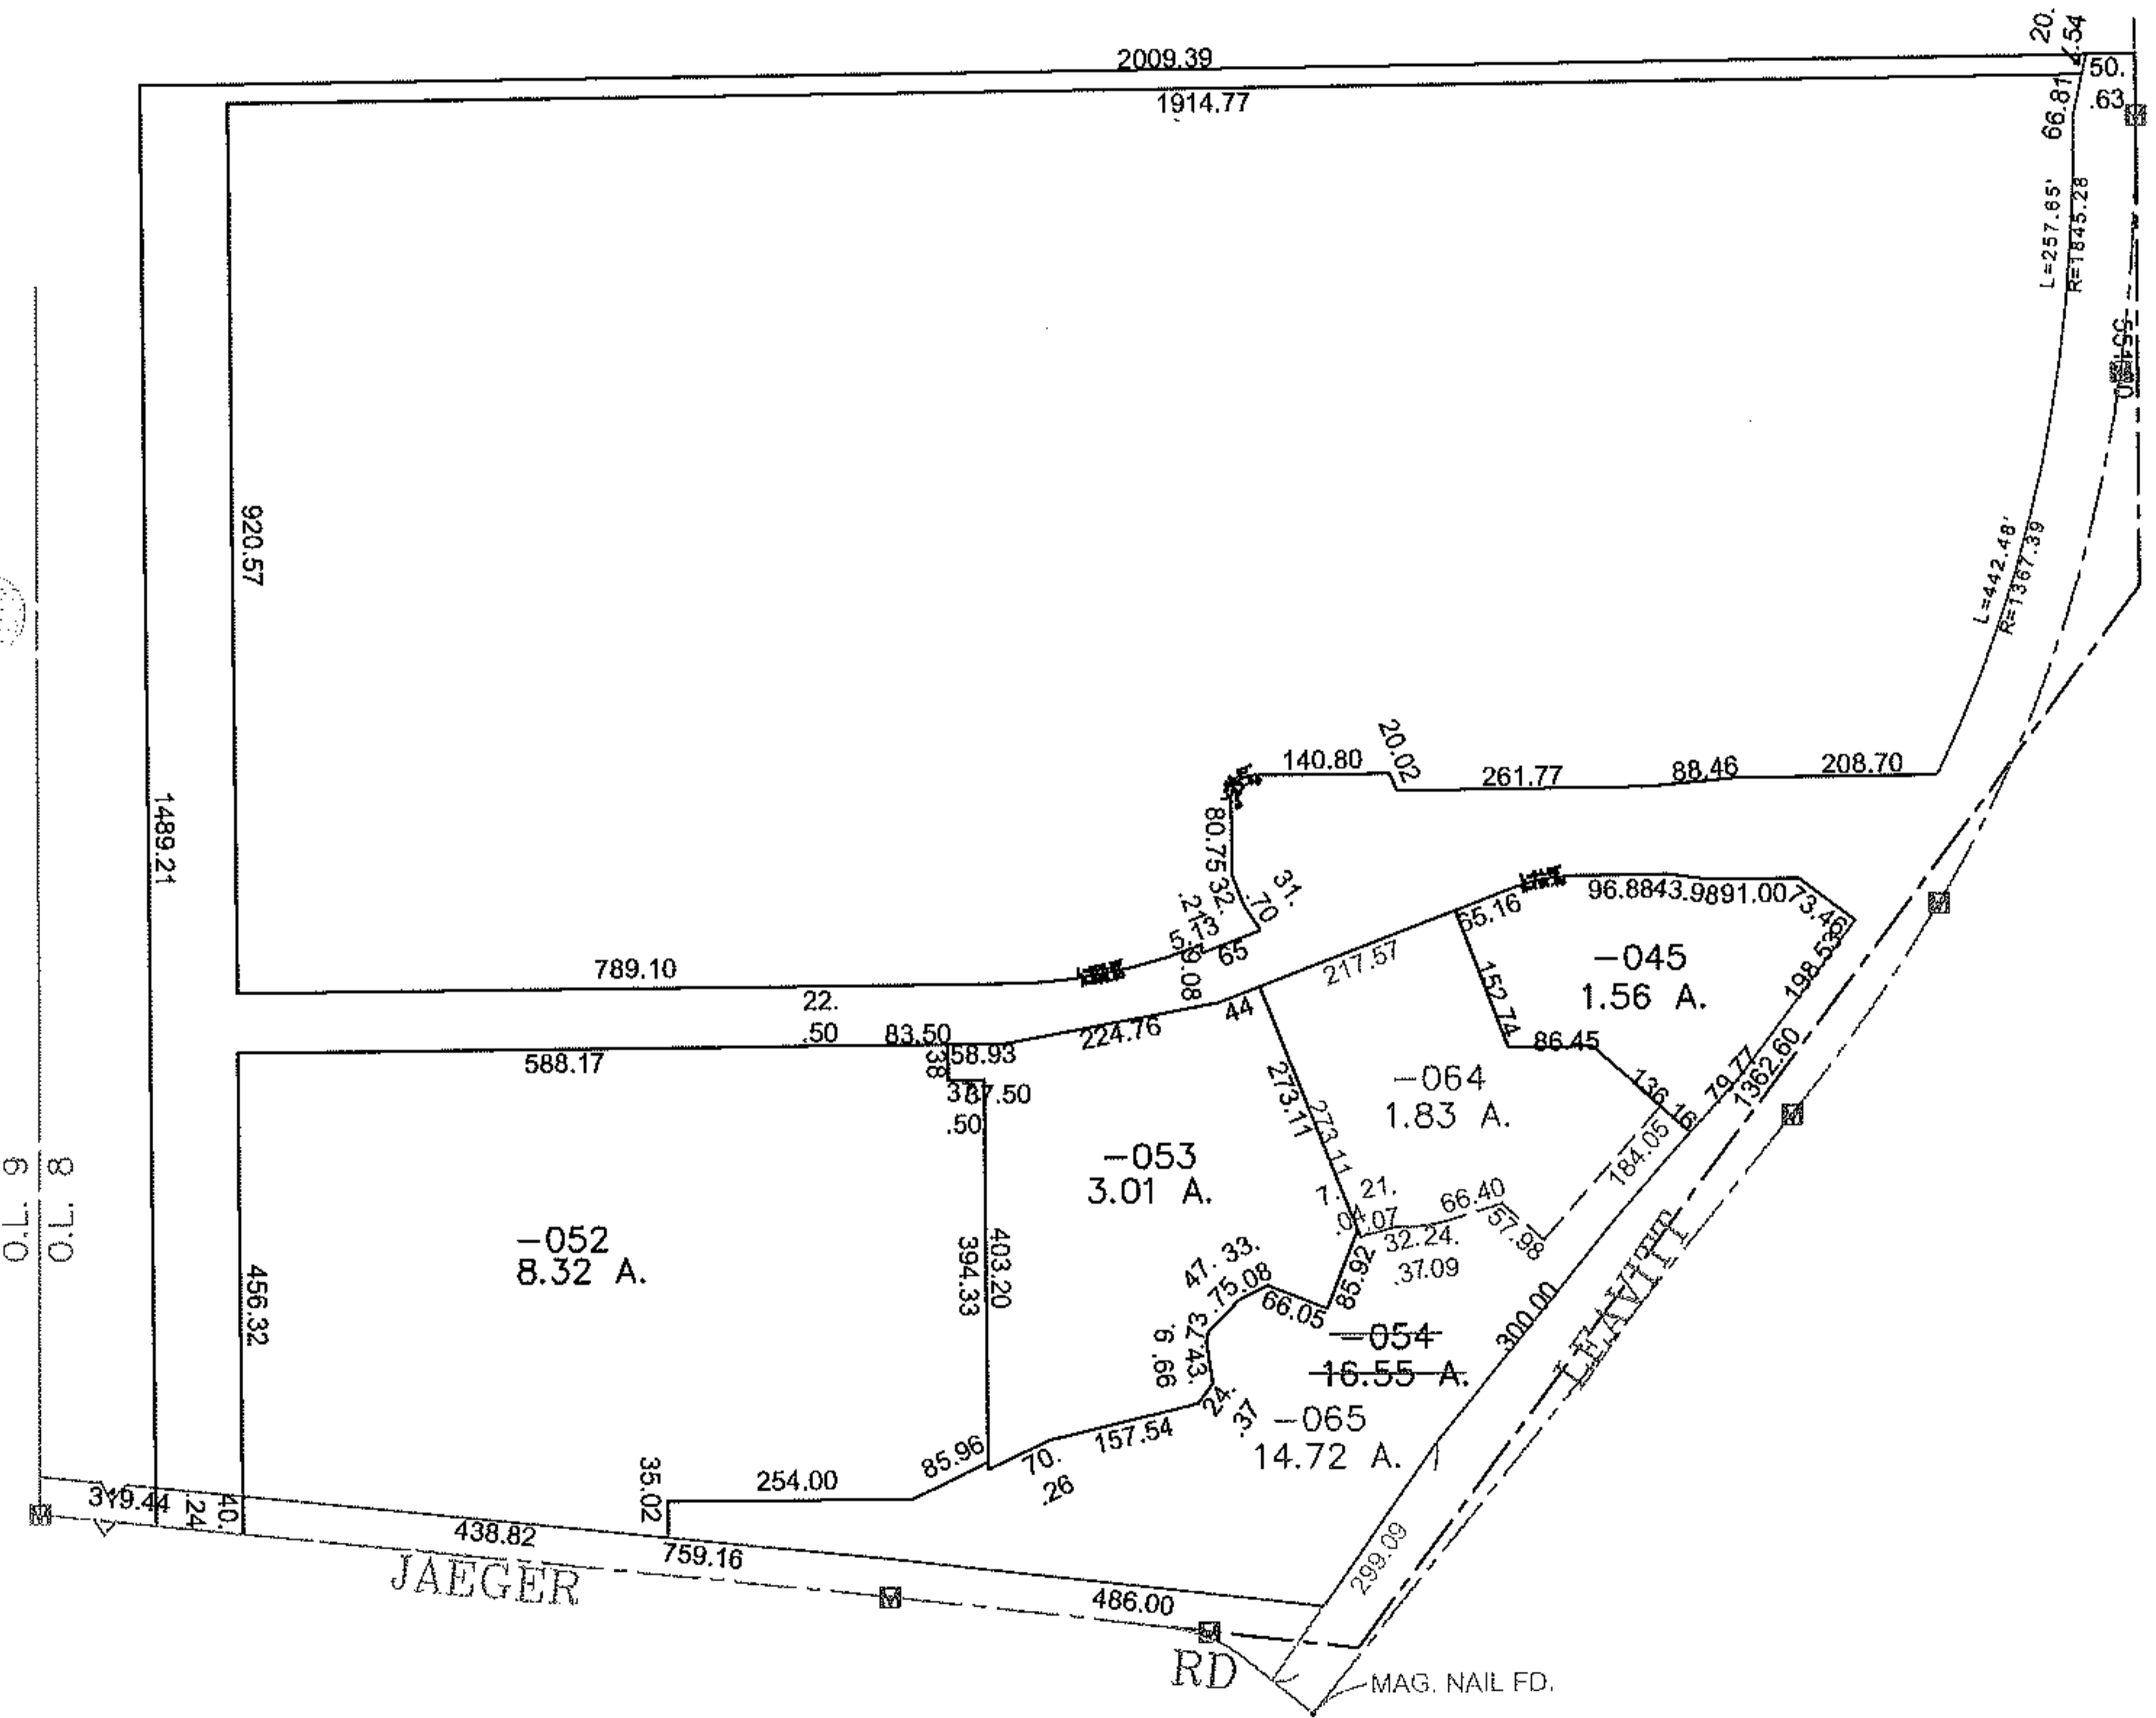


PARENT PARCEL: 02-02-008-107-054

CHILD PARCEL: 02-02-008-107-064, -065

STARTING POINT: CENTERLINE OF JAEGER RD & O.L. 8

12-03075

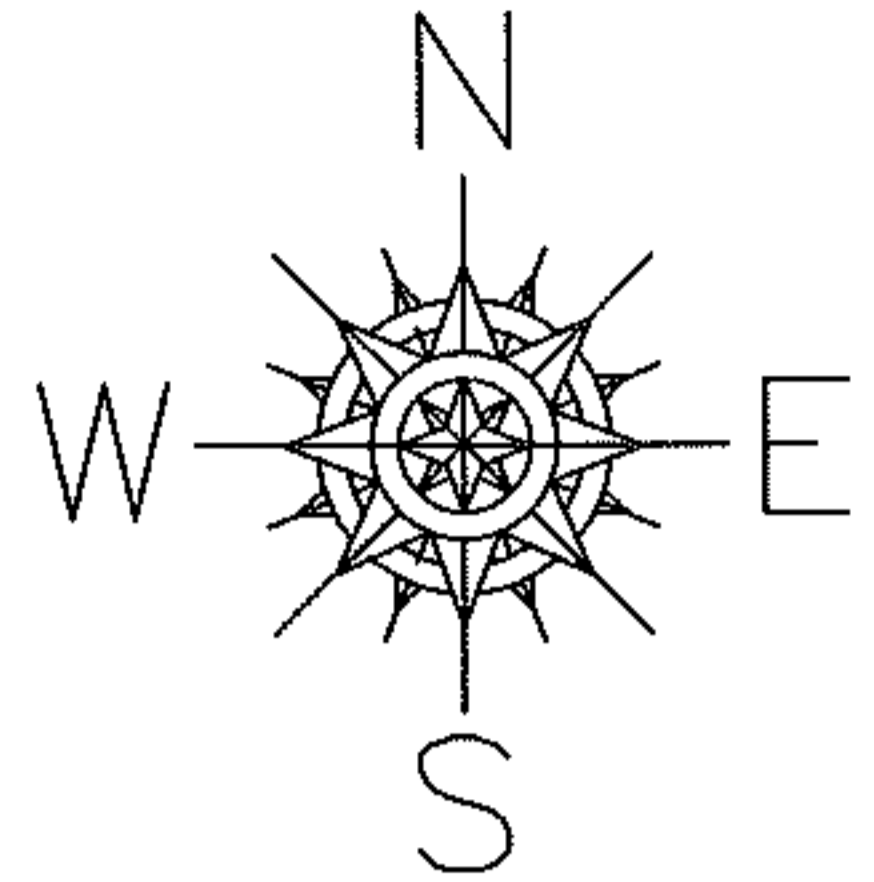

SPLITS/DEEDS PROCESSED

LORAIN COUNTY TAX MAP DEPARTMENT
226 MIDDLE AVE. ELYRIA, OHIO

SURVEYED BY: TREVOR BIXLER
 CLOSURE: 0.00 : 10,000
 MAP PAGE(S): 02-02-008-A, B
 APPROVED BY: JAH DATE: 10/10/2012
 SCALE: 1" = 300 PRIOR INSTRUMENT: 20090290055