
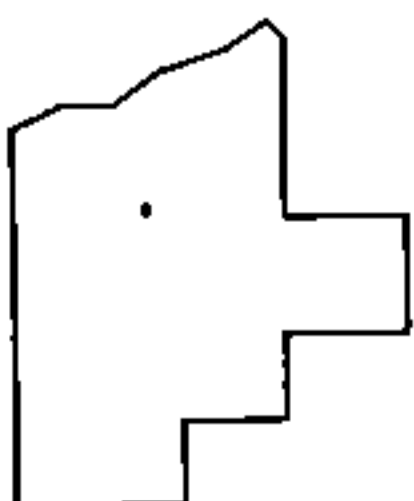
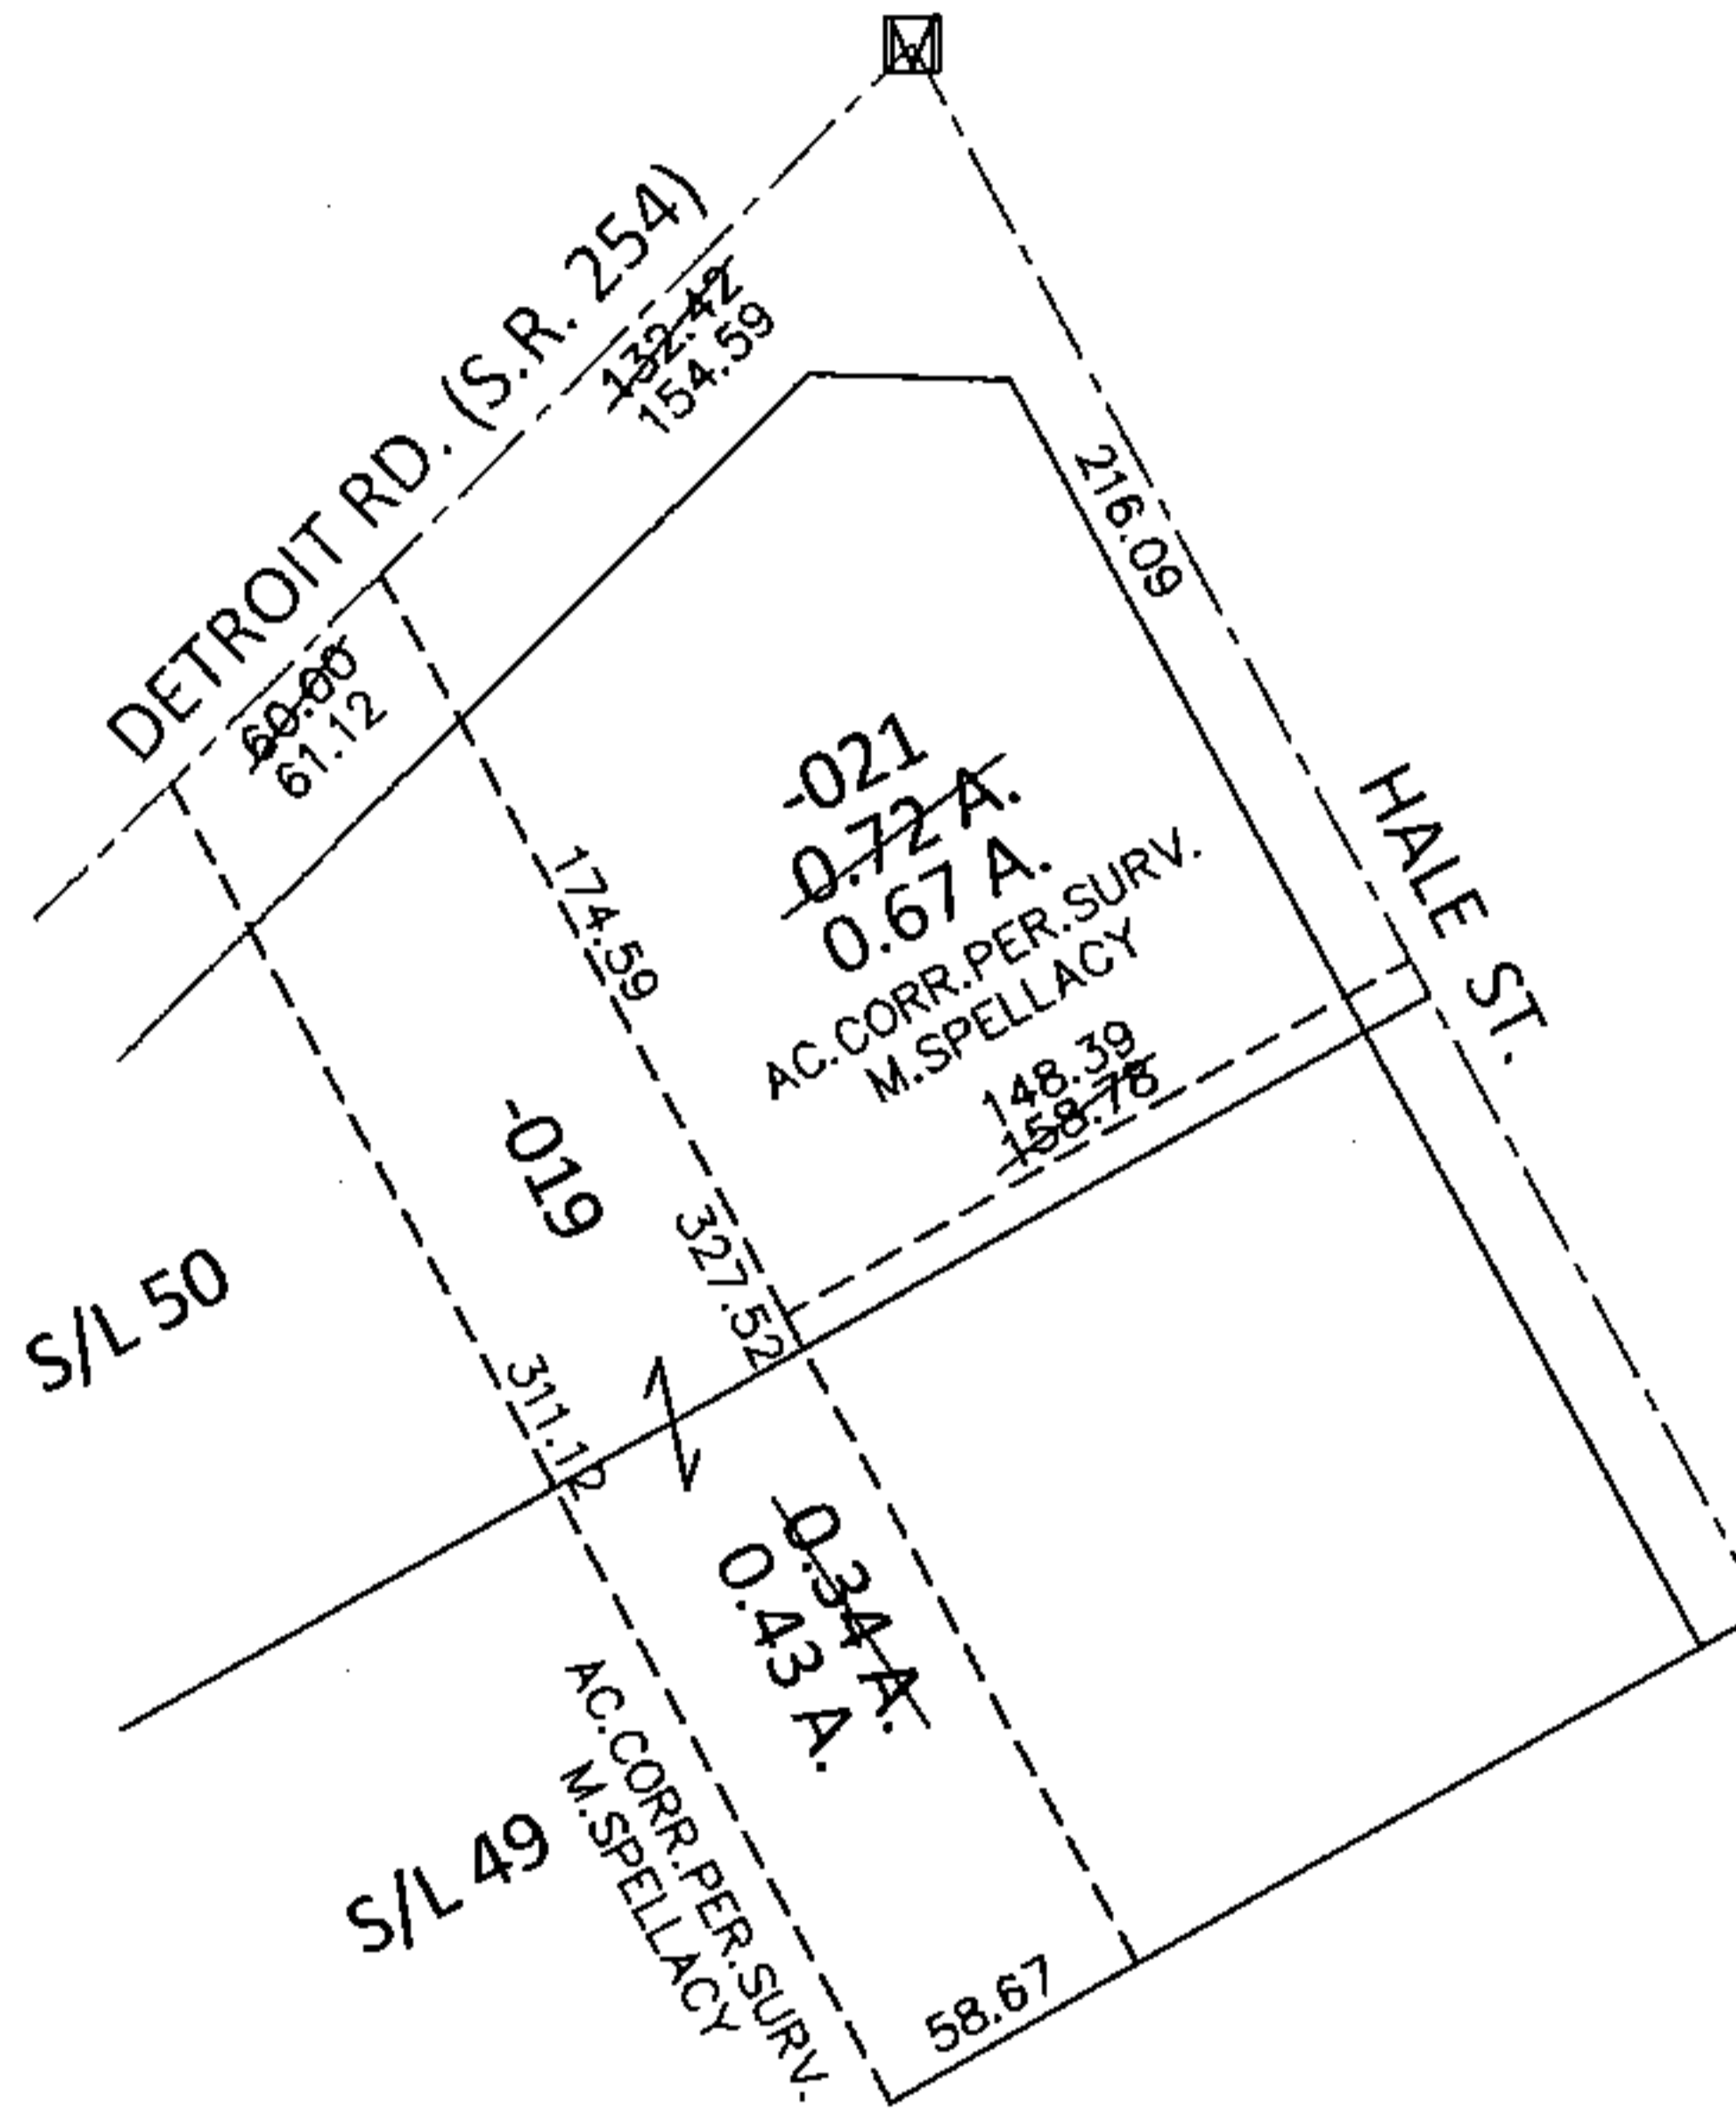


PARENT PARCEL: 04-00-010-116-019, -021

CHILD PARCEL: _____

STARTING POINT: AT A MON BOX AT THE INTERSECTION OF C/L OF HALE ST. AND C/L OF S.R.254

14-03077-C

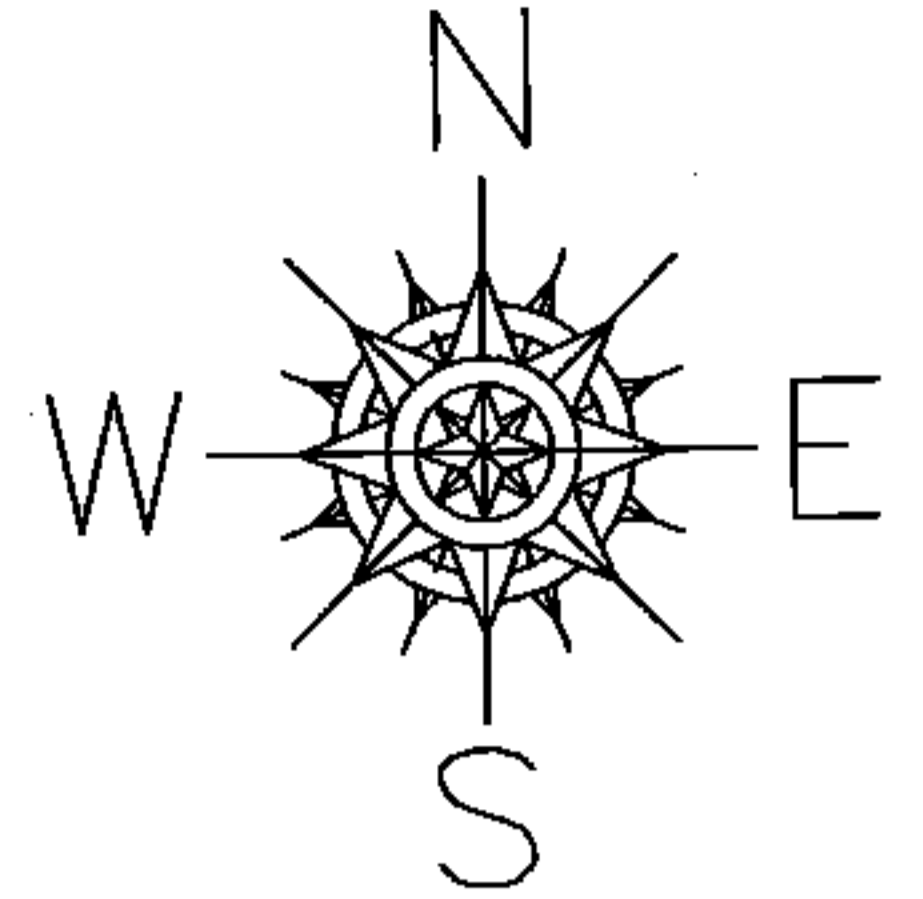

SPLITS/DEEDS PROCESSED

LORAIN COUNTY TAX MAP DEPARTMENT
226 MIDDLE AVE. ELYRIA, OHIO

SURVEYED BY: MICHAEL P. SPELLACY

CLOSURE: .01:10,000

MAP PAGE(S): 4-00-010-G

APPROVED BY: RRM DATE: 12-26-14

SCALE: 1"= 100 PRIOR INST.: 20070199764