
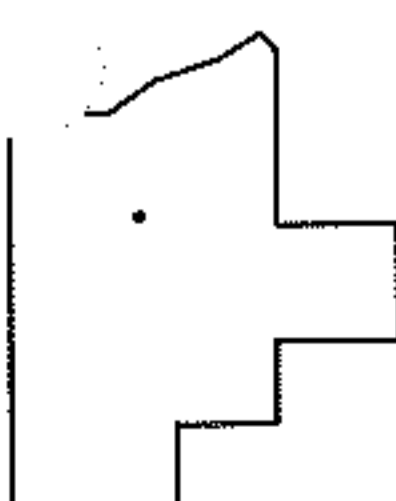
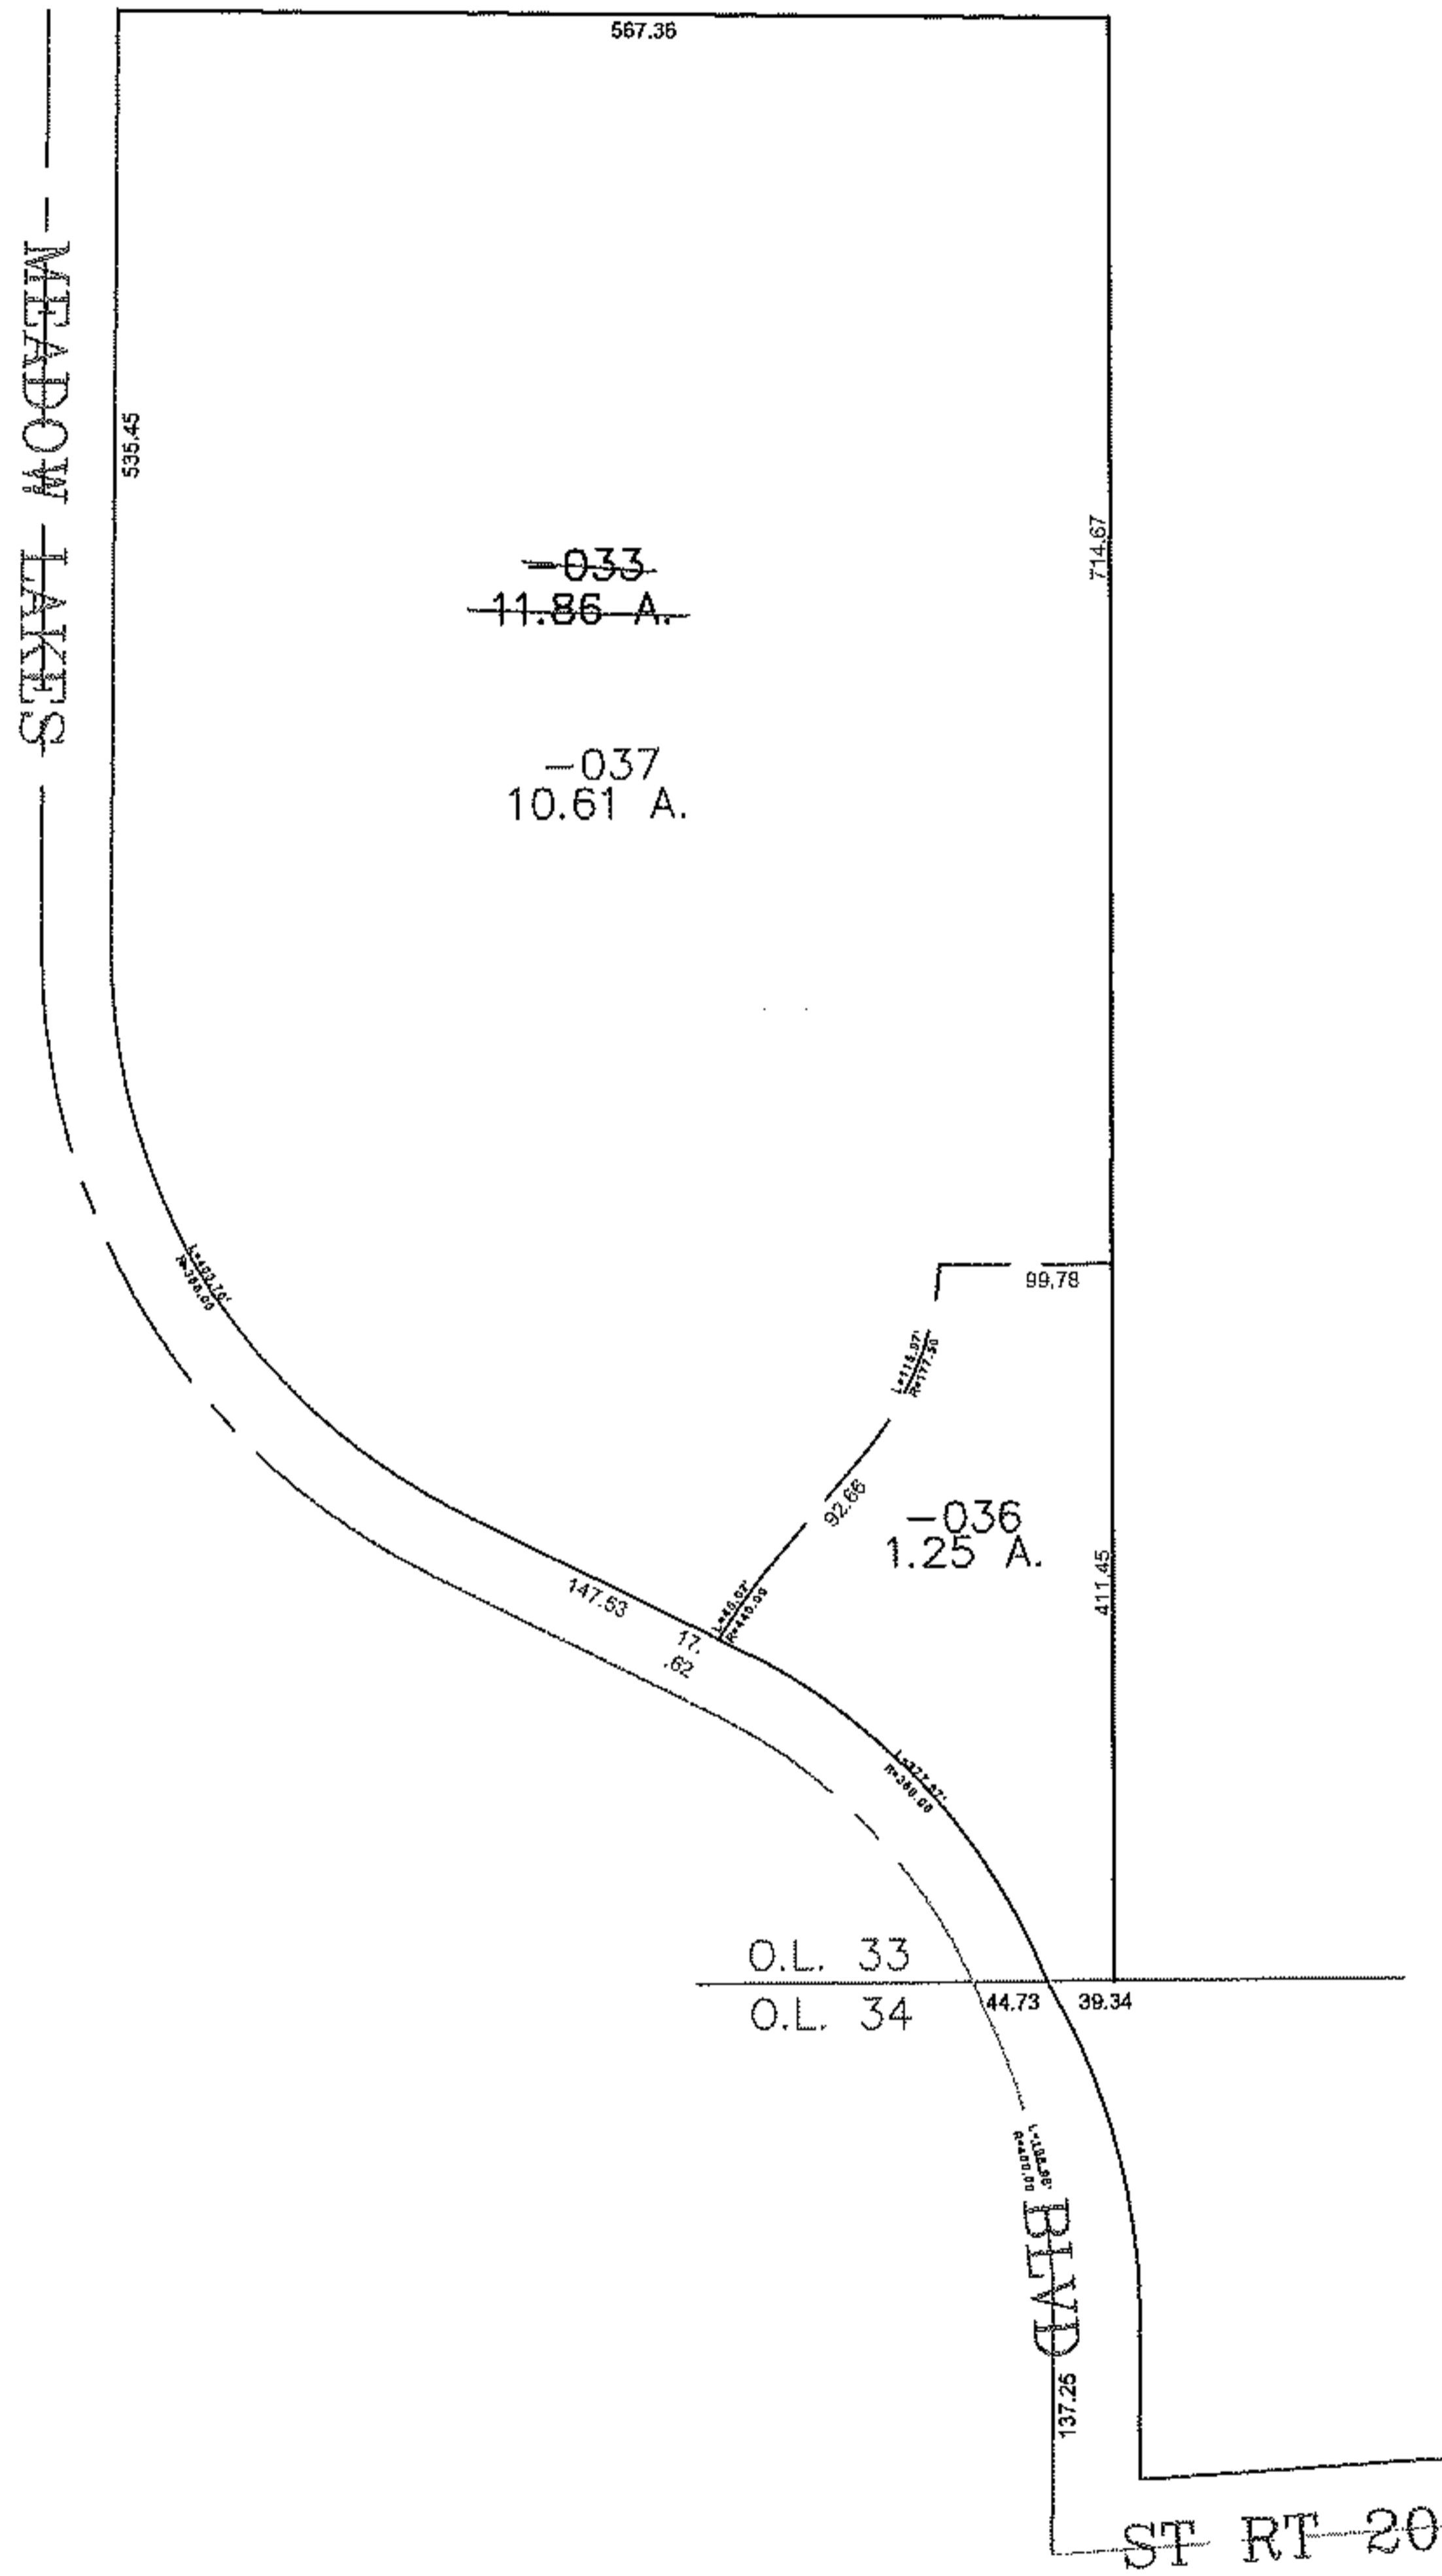


PARENT PARCEL: 07-00-033-101-033

CHILD PARCEL: 07-00-033-101-036, -037

12-03077

STARTING POINT: CENTERLINE OF MEADOW LAKES BLVD & ST RT 20

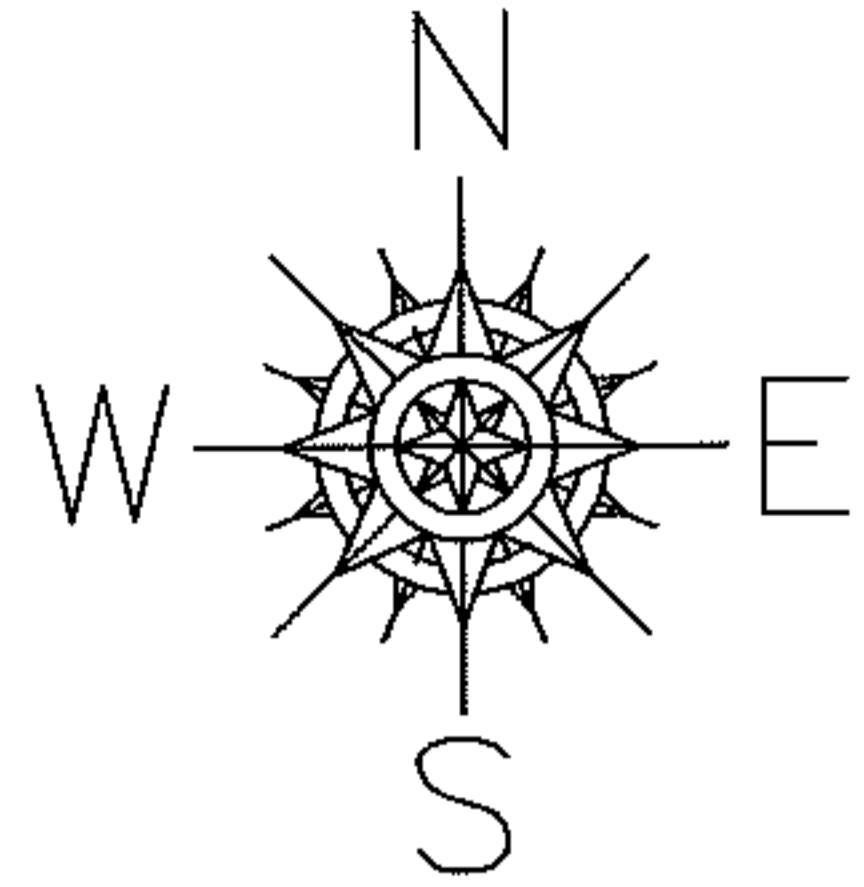

SPLITS/DEEDS PROCESSED
 LORAIN COUNTY TAX MAP DEPARTMENT
 226 MIDDLE AVE. ELYRIA, OHIO

SURVEYED BY: BRENT ANDERSON
 CLOSURE: 0.00 : 10.000
 MAP PAGE(S): 07-00-033
 APPROVED BY: JAH DATE: 10-15-2012
 SCALE: 1" = 200 PRIOR INSTRUMENT: 20110381380