

PARENT PARCEL: 06-26-051-000-016 & -017

CHILD PARCEL: XX-XX-XXX-XXX-XXX

STARTING POINT: N.E. CORNER OF S/L 280

14-03080-C

MAP CORRECTION FRONTAGE & DEPTH CORR.

06-26-051-000-016

~~156.42 X 82~~

156.48 X 83.06




PER SURV. J.W. WARDEN
PER DV 81/312

06-26-051-000-017

~~82.50 X 132~~

83.06 X 156.45

PER SURV. J.W. WARDEN
PER OR 67/161

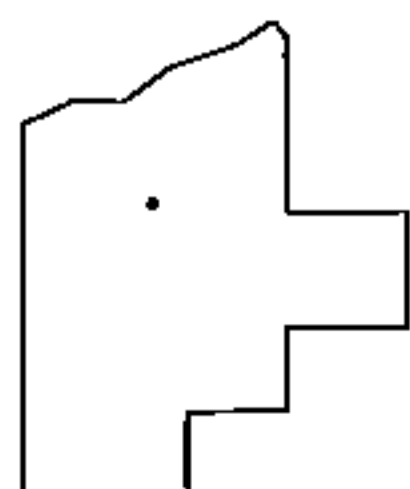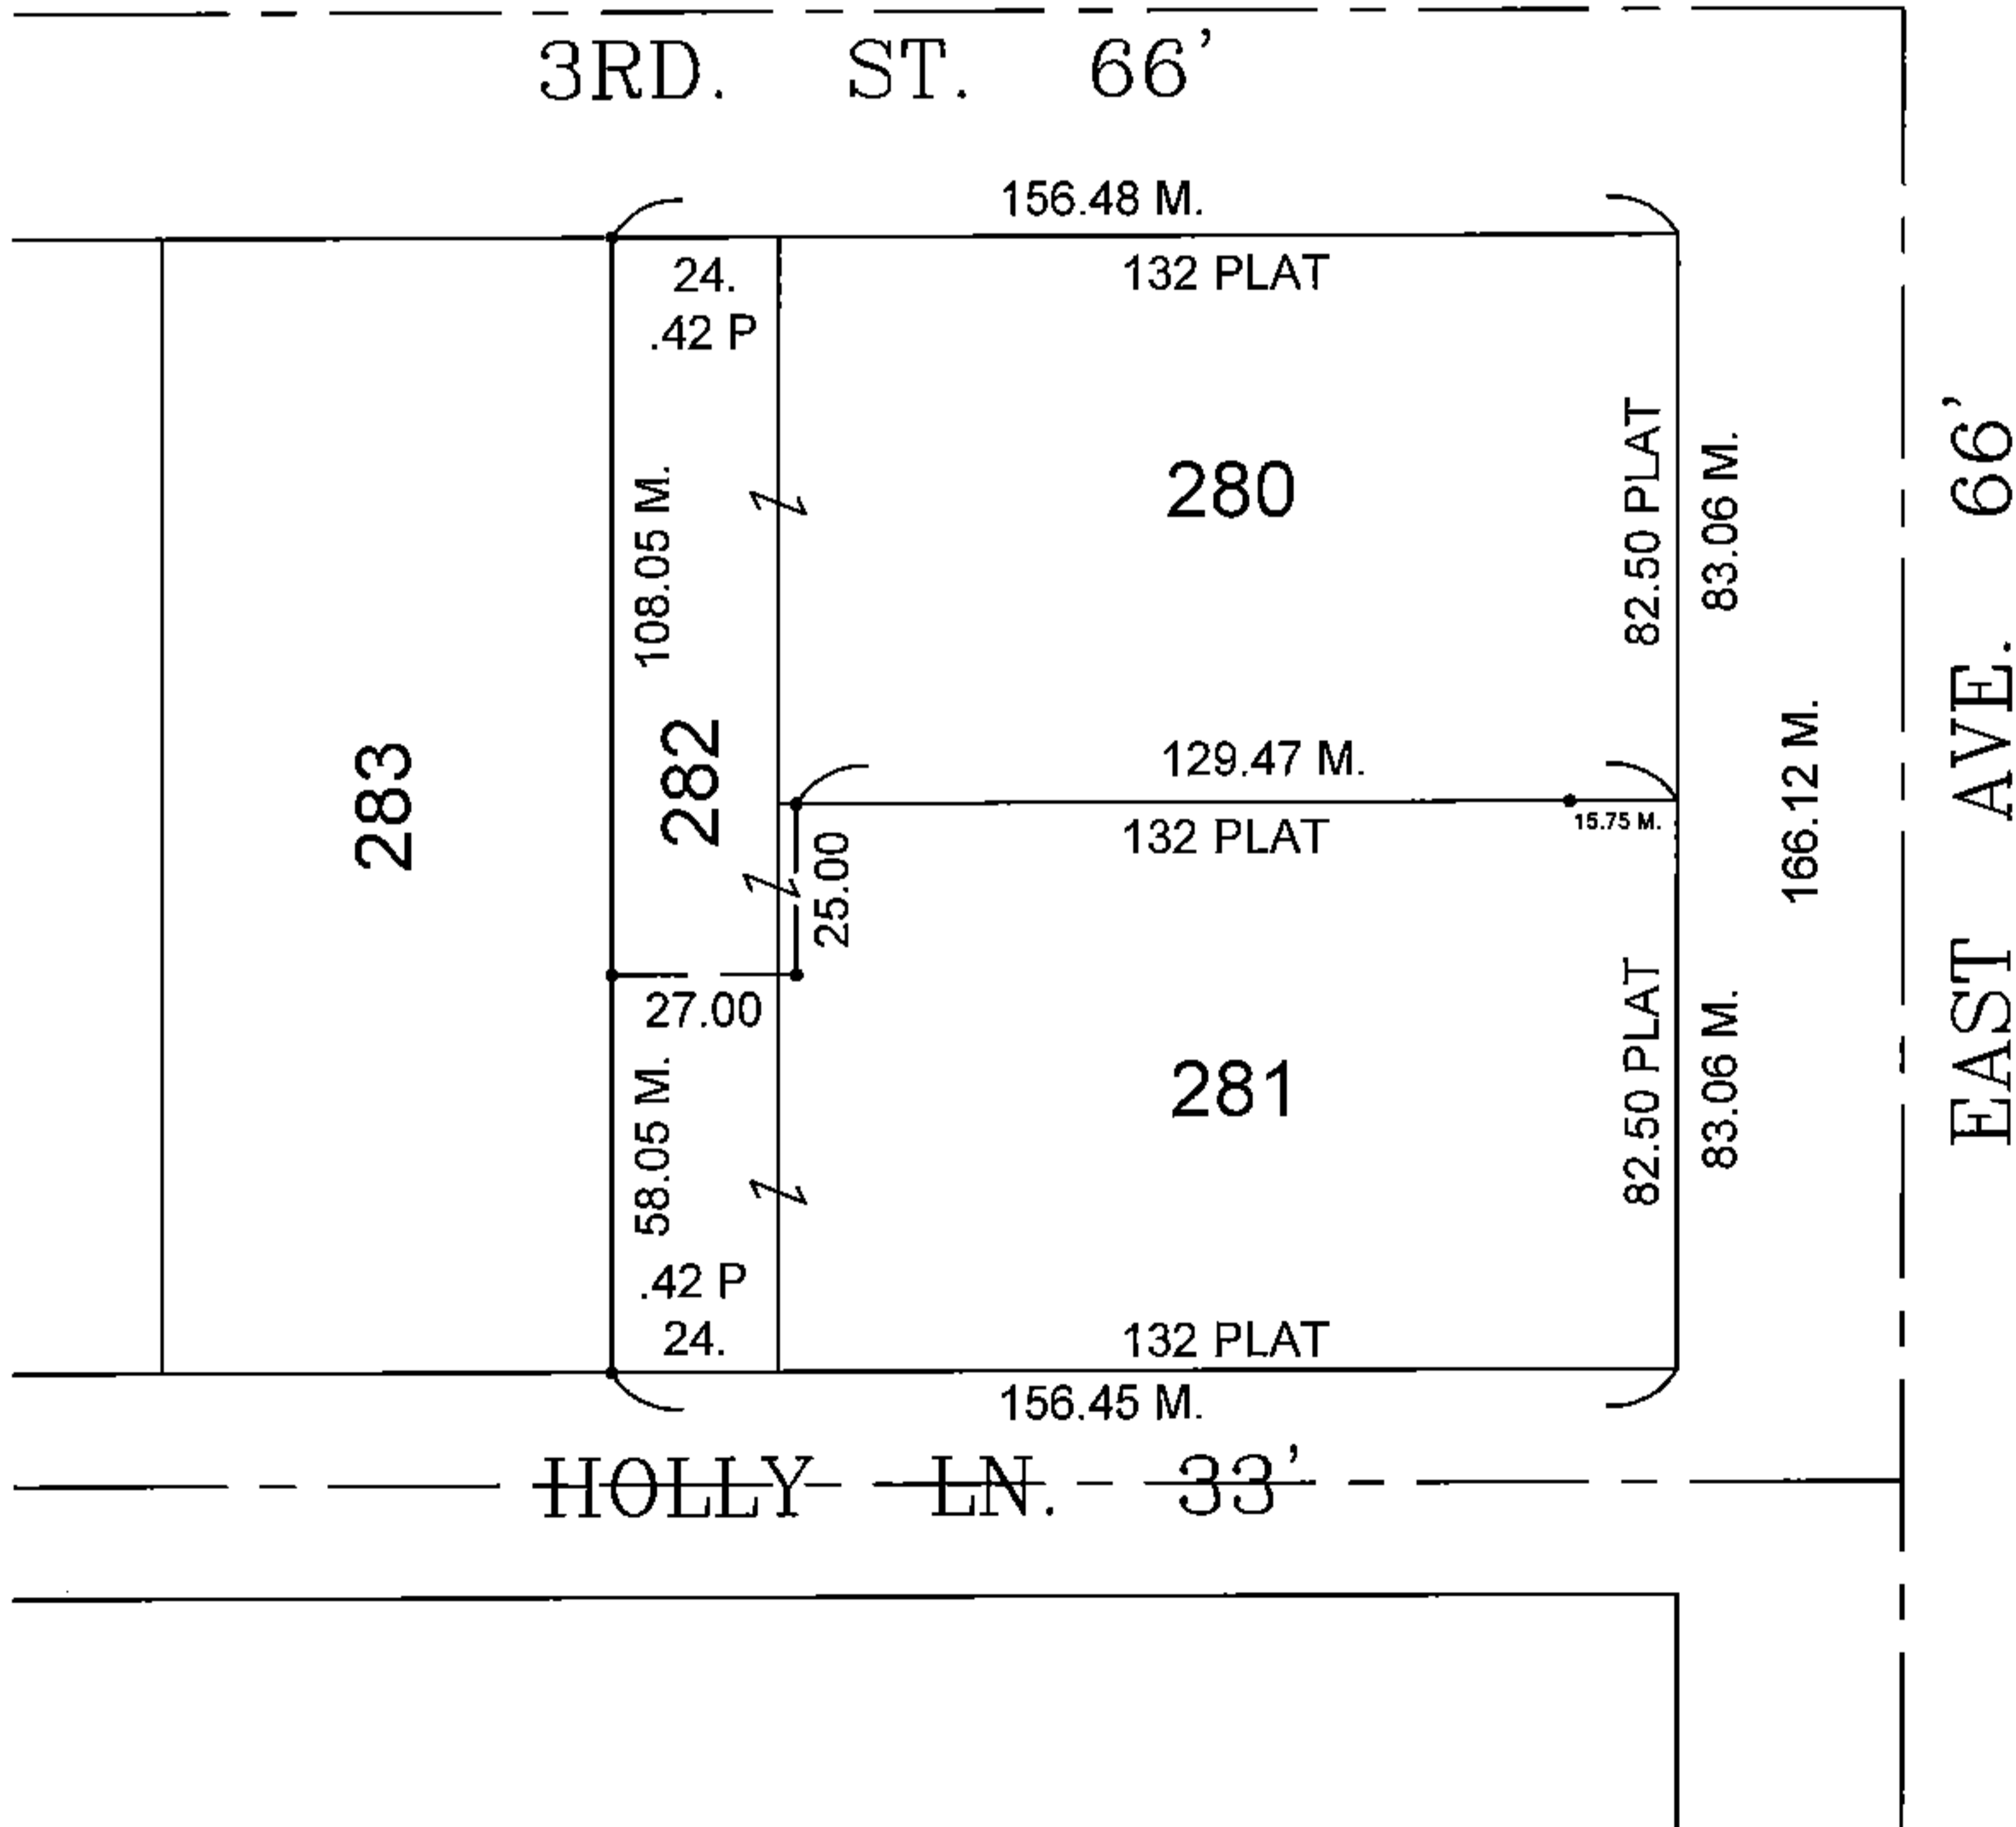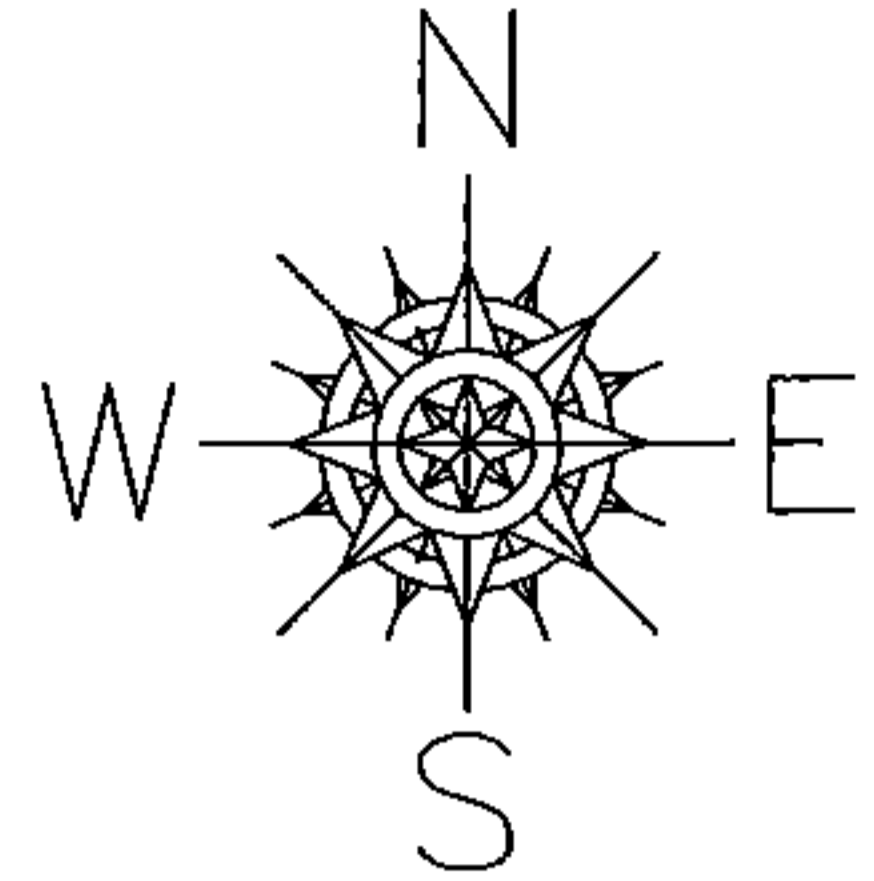

SPLITS/DEEDS PROCESSED

LORAIN COUNTY TAX MAP DEPARTMENT
226 MIDDLE AVE. ELYRIA, OHIO

SURVEYED BY: J.W. WARDEN

CLOSURE: 0.01 : 10,000

MAP PAGE(S): 06-26-051

APPROVED BY: TJS DATE: 12/29/14

SCALE: 1"= 50' PRIOR INST.: DV XXXX/XXX