


PARENT PARCEL: 16-00-060-900-001 & ADD TO DUPLICATE
CHILD PARCEL: 15-00-050-900-001
STARTING POINT: SOUTH R.O.W. OF S.R. 303 & WEST LINE OF O.L. 60

15-03085-A

ADD TO DUPLICATE



15-00-050-900-001
0.02 A.

PER UNRECORDED
DEDICATION PLAT
ENGINEER ROAD RECORD
NO. 4 PG. 404
SEE TAX MAP SURVEY FILE
#48532

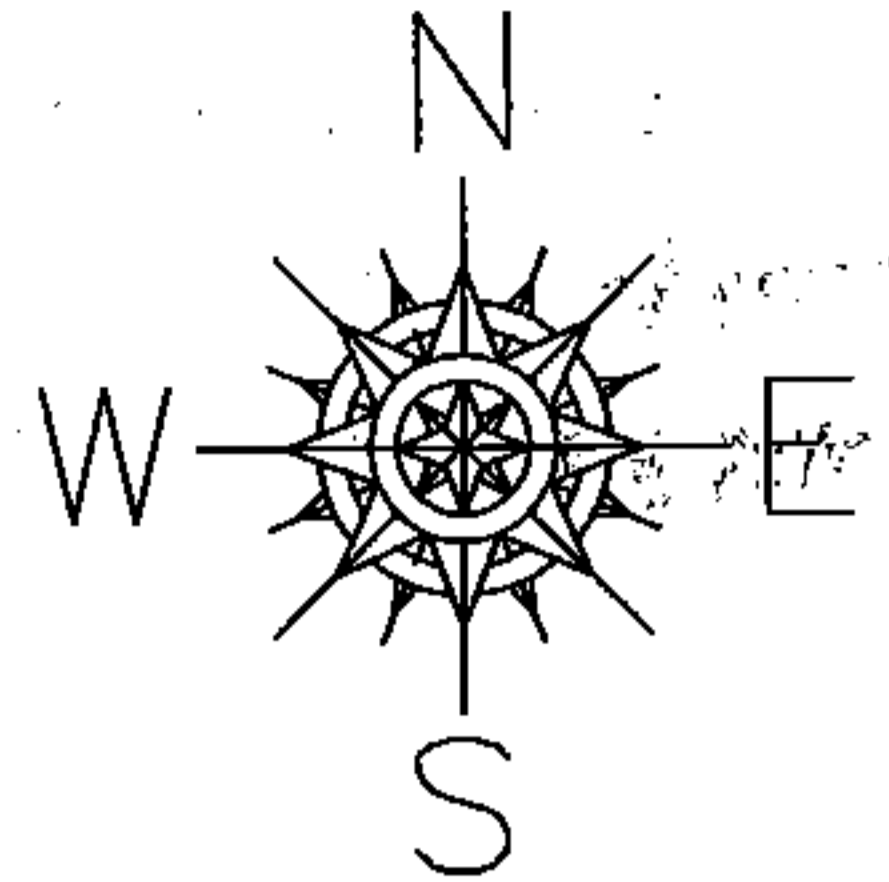

ACREAGE CORRECTION

16-00-060-900-001
~~0.28 A.~~
0.26 A.

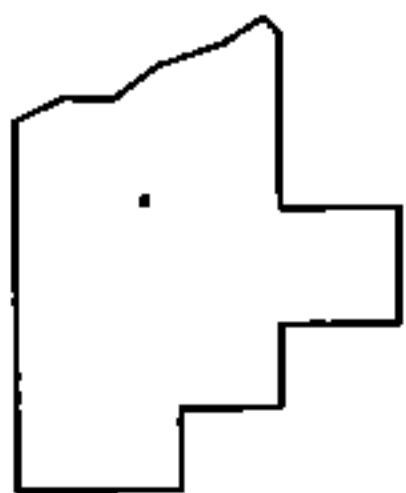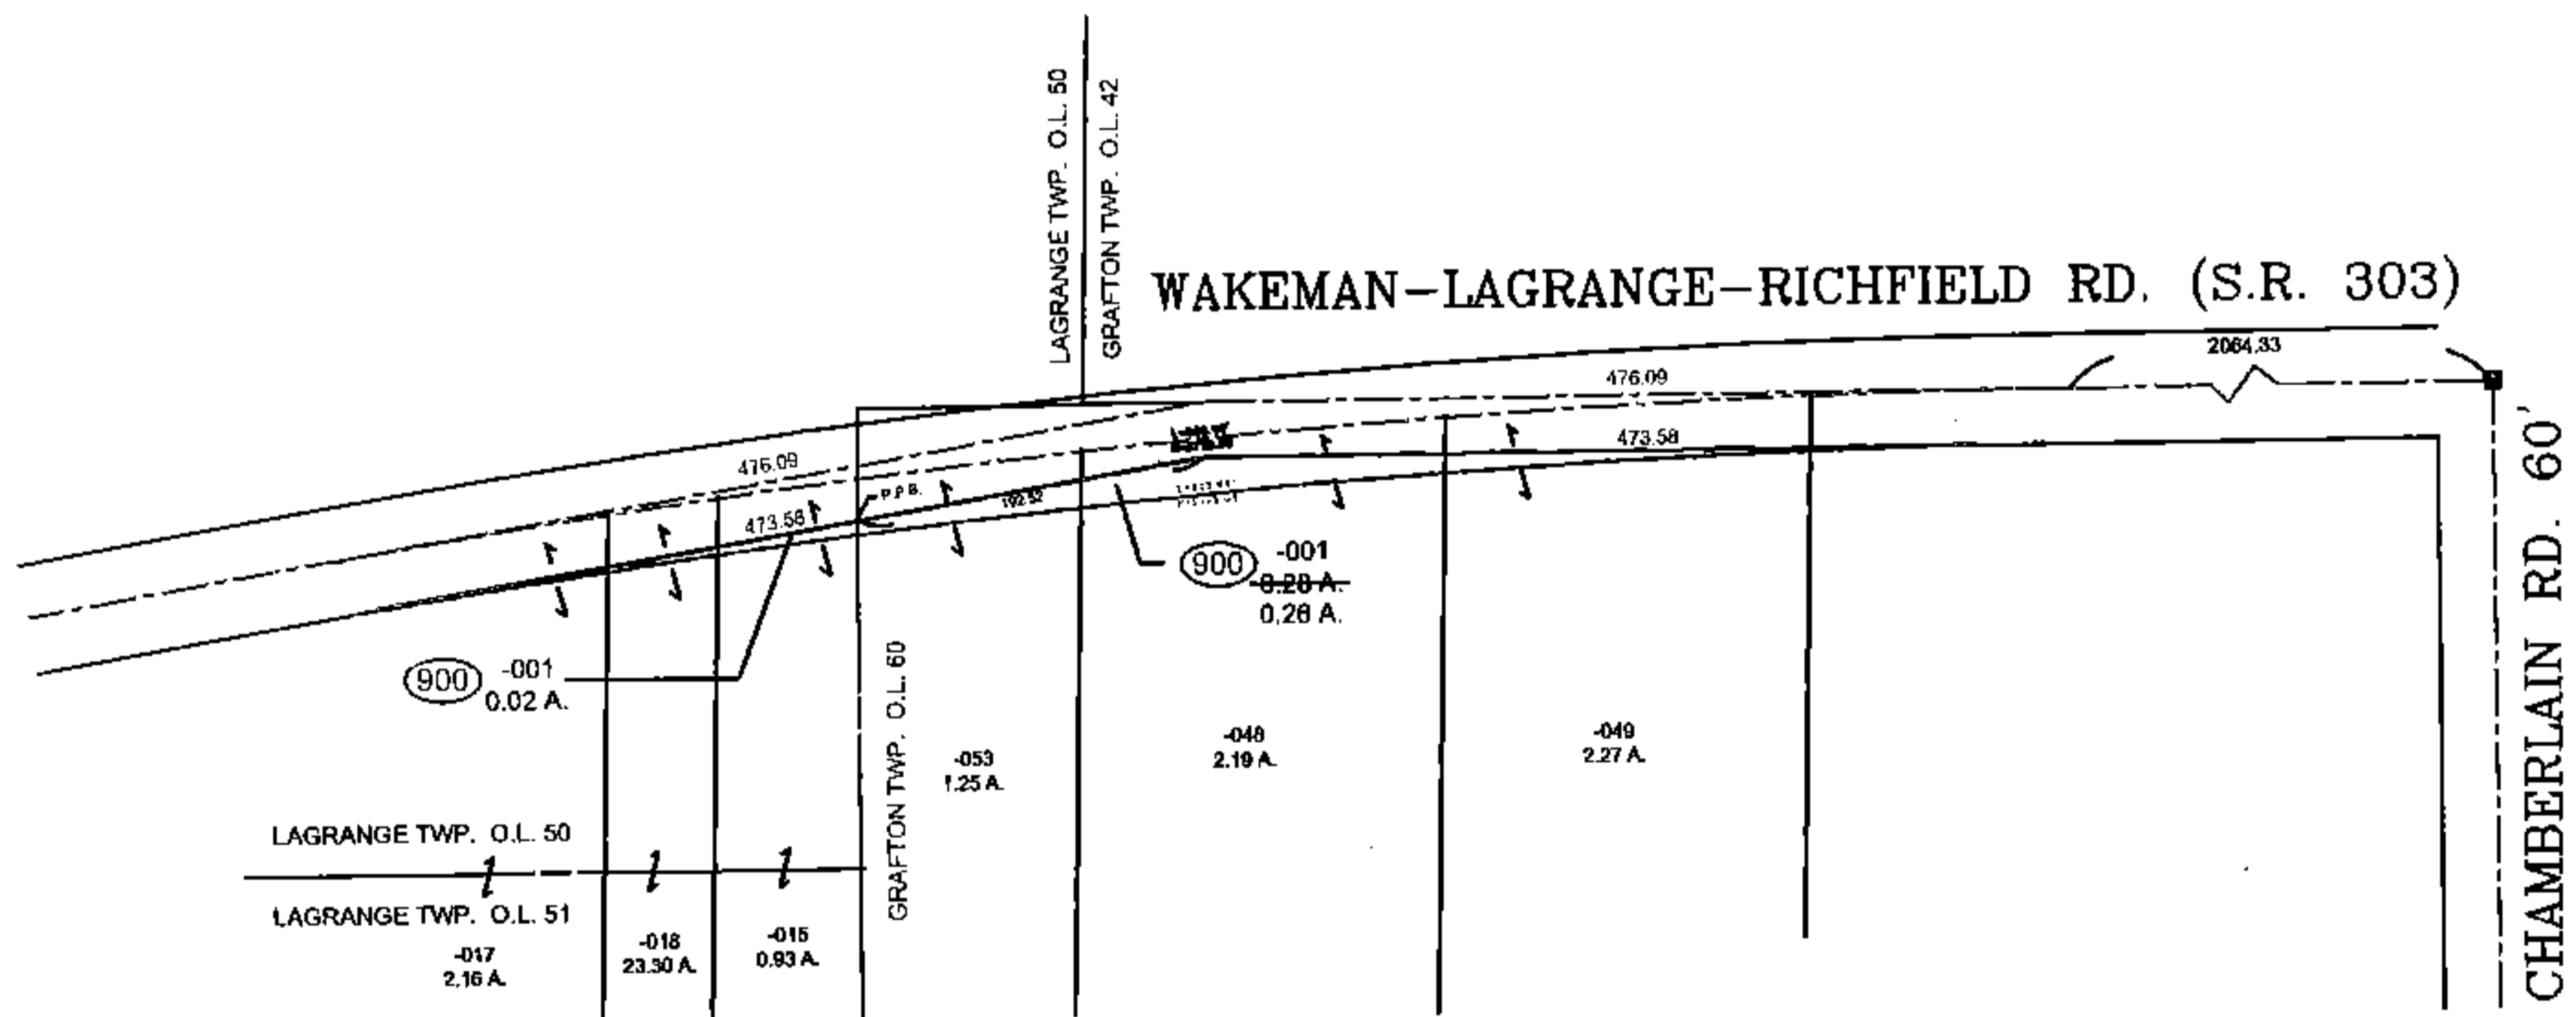

SPLITS/DEEDS PROCESSED
LORAIN COUNTY TAX MAP DEPARTMENT
226 MIDDLE AVE. ELYRIA, OHIO

SURVEYED BY: C.T. BIGGS
CLOSURE: 0.01 : 10,000
MAP PAGE(S): 16-00-060 & 15-00-050
APPROVED BY: TJS DATE: 1/7/15
SCALE: 1" = 200 PRIOR INSTRUMENT: DV XXXX/XXX