

PARENT PARCEL: 02-02-025-117-031 & -032

CHILD PARCEL: 02-02-025-117-039

STARTING POINT: XXXXXX

15-03086-C

DROP FROM DUPLICATE

02-02-025-117-031

80 X 70

&

02-02-025-117-032

27 X 70

PER OR 206/264

ADD TO DUPLICATE

02-02-025-117-039

7.50 X 216.65

PER ORD. 5503 & 4127
OR 206/264



FR. & DEPTH CORR.

02-02-025-117-033

~~105.00 X 150.00 IRR.~~

105.00 X 157.50

PER ORD. 5503
OR 206/264

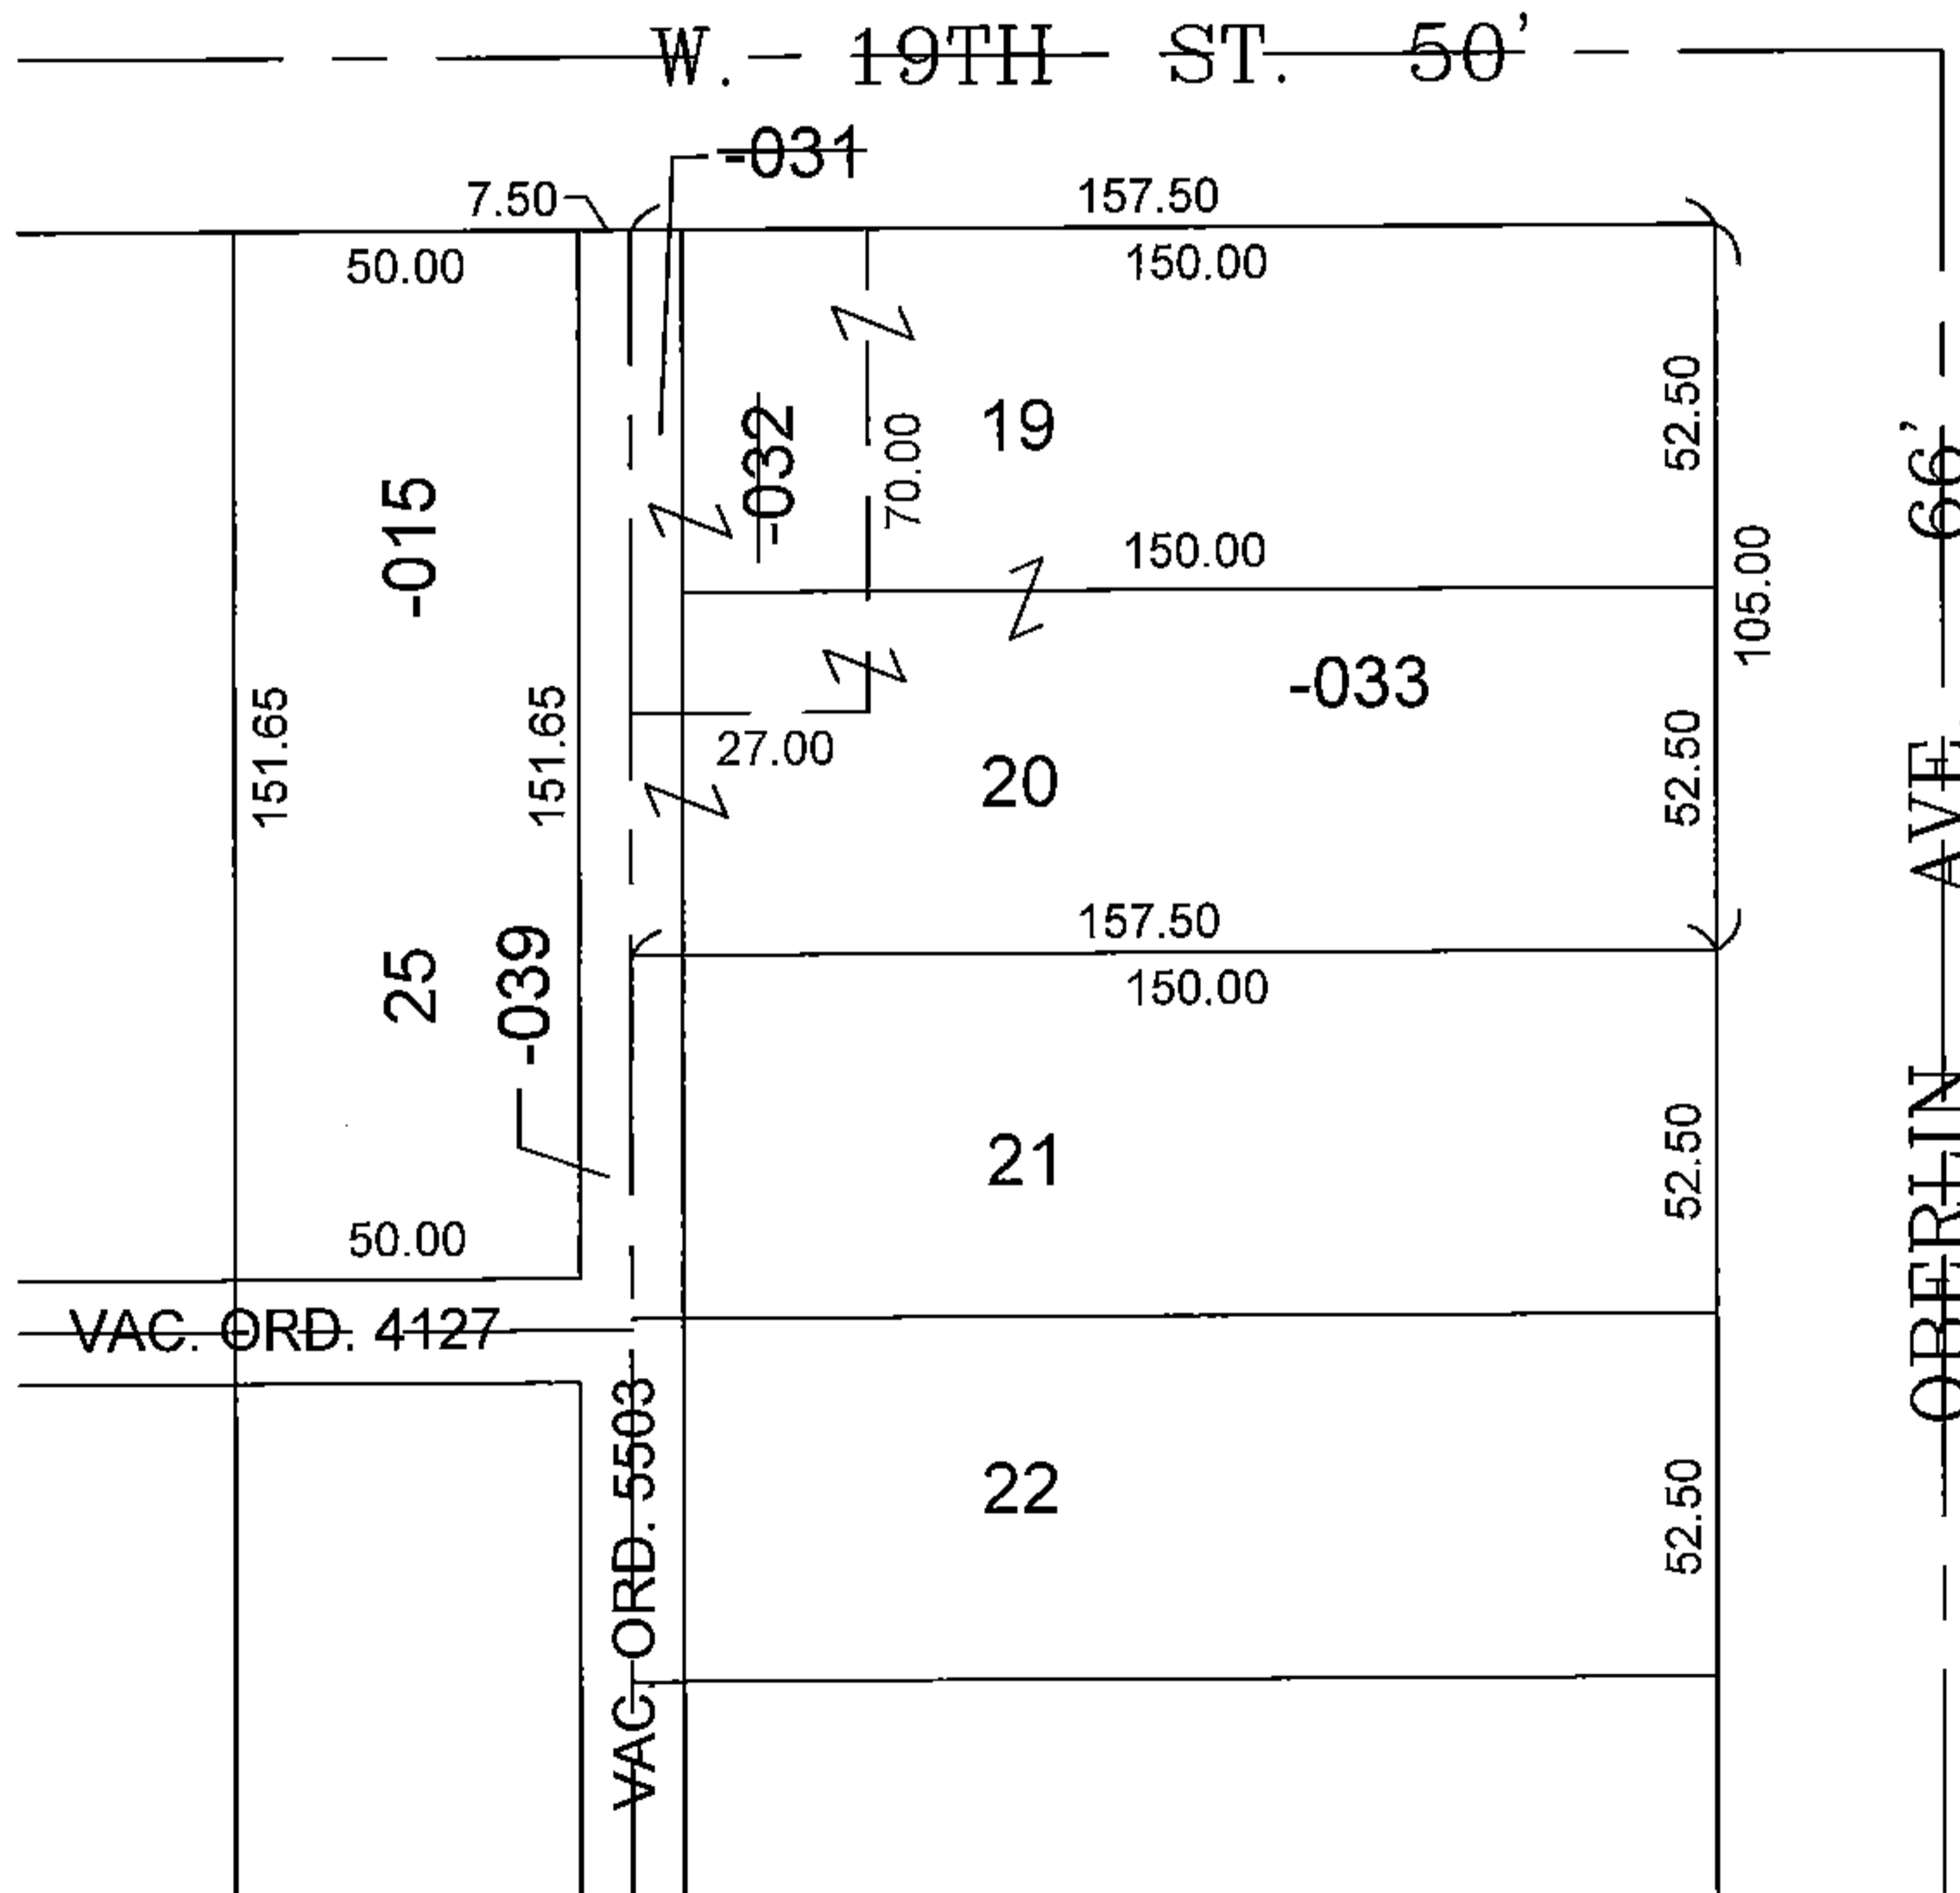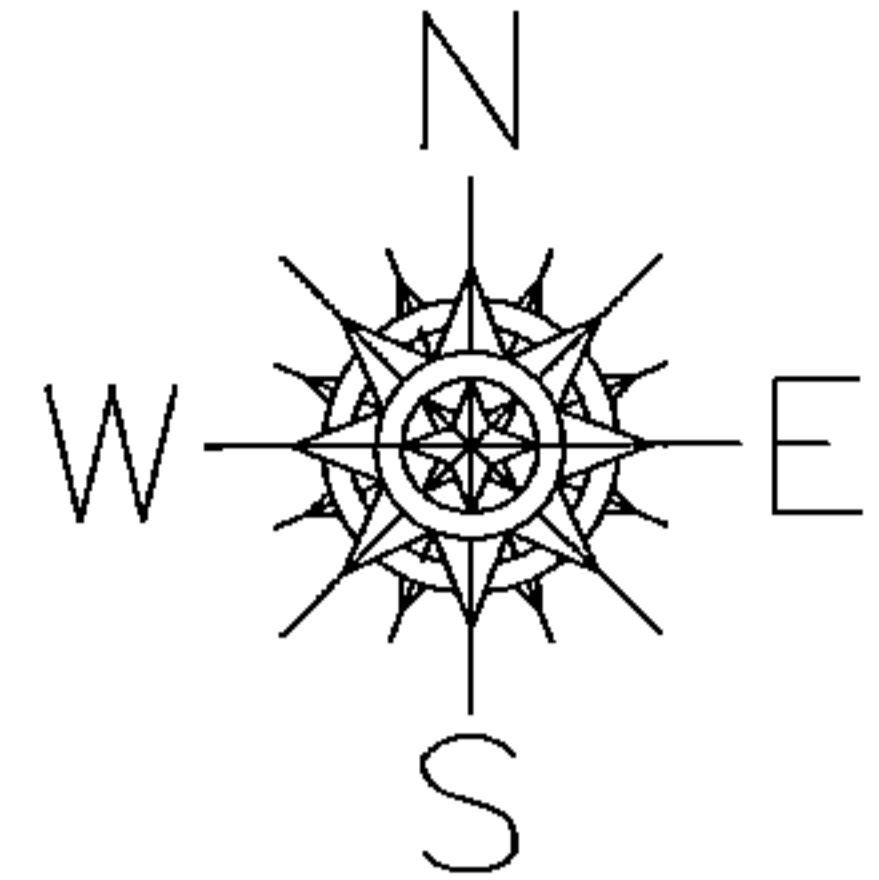

SPLITS/DEEDS PROCESSED

LORAIN COUNTY TAX MAP DEPARTMENT
226 MIDDLE AVE. ELYRIA, OHIO

SURVEYED BY: NA

CLOSURE: NA

MAP PAGE(S): 02-02-025

APPROVED BY: TJS DATE: 1/12/15

SCALE: 1" = 50' PRIOR INST.: OR 206/264