
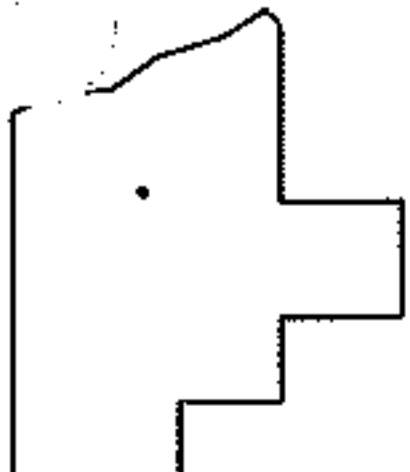
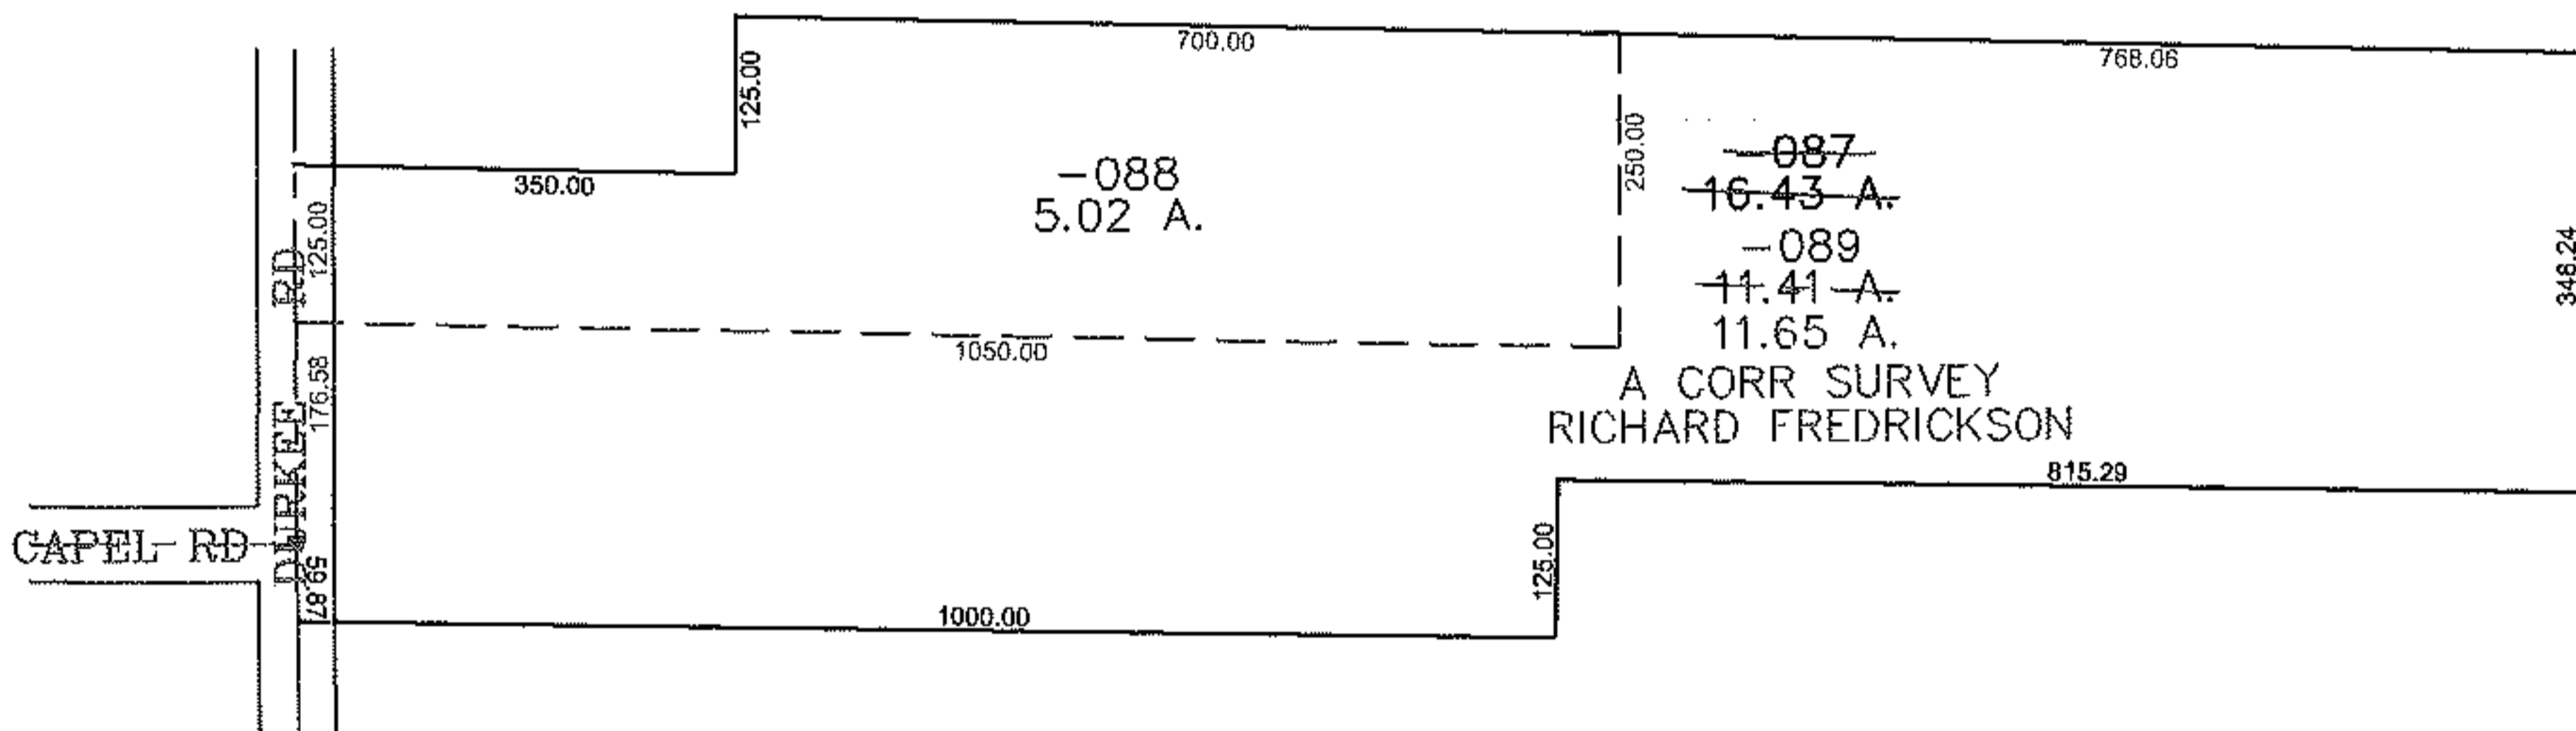


PARENT PARCEL: 11-00-077-000-087

CHILD PARCEL: 11-00-077-000-088, -089

STARTING POINT: CENTERLINE OF DURKEE RD & CAPEL RD

12-03088

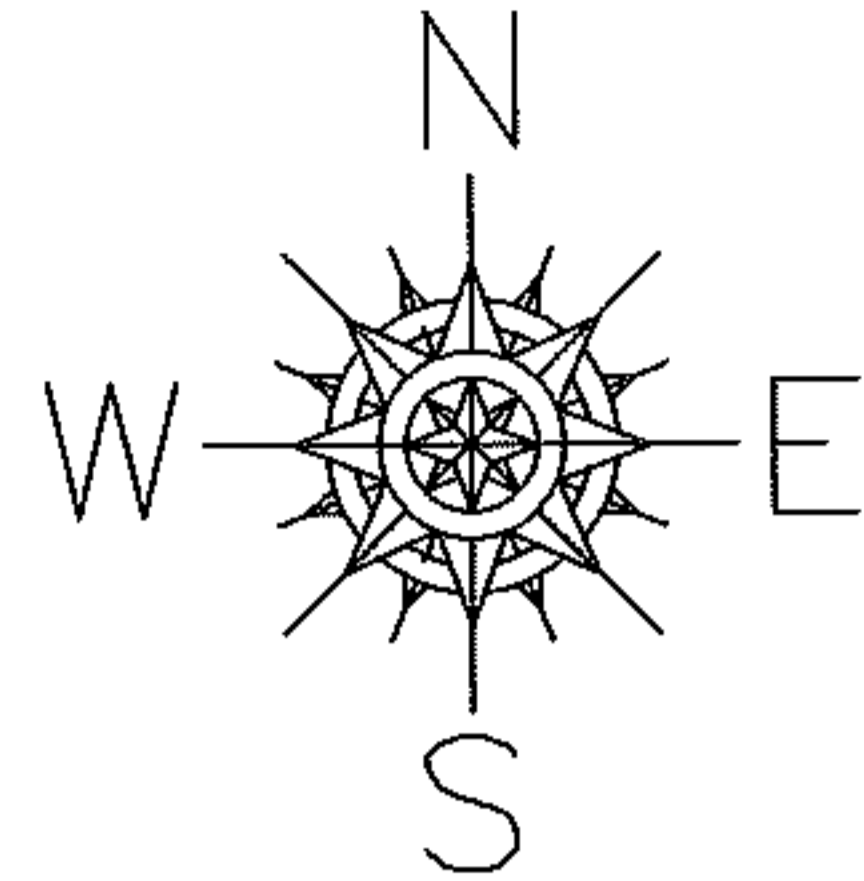

**SPLITS/DEEDS PROCESSED**  
 LORAIN COUNTY TAX MAP DEPARTMENT  
 226 MIDDLE AVE. ELYRIA, OHIO

SURVEYED BY: RICHARD FREDRICKSON  
 CLOSURE: 0.00 : 10,0000  
 MAP PAGE(S): 11-00-077-A  
 APPROVED BY: JAH DATE: 10/19/2012  
 SCALE: 1" = 300 PRIOR INSTRUMENT: 20000669979