
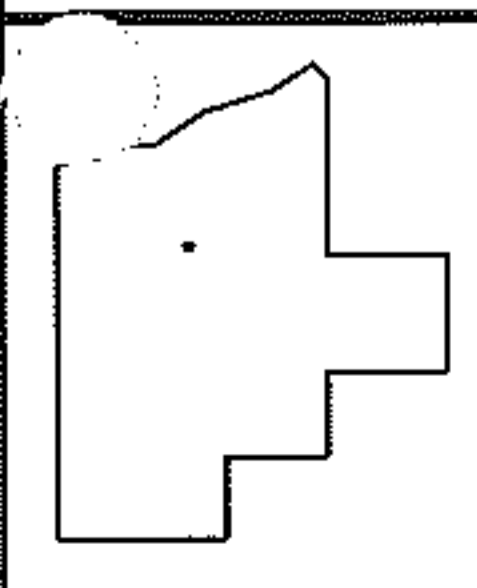


PARENT PARCEL: 12-00-021-105-028, 12-00-020-101-003
 CHILD PARCEL: 12-00-021-105-029, -030 12-00-020-101-004, -005
 STARTING POINT: CENTERLINE OF REDFERN RD & EAST RIVER RD

12-03089

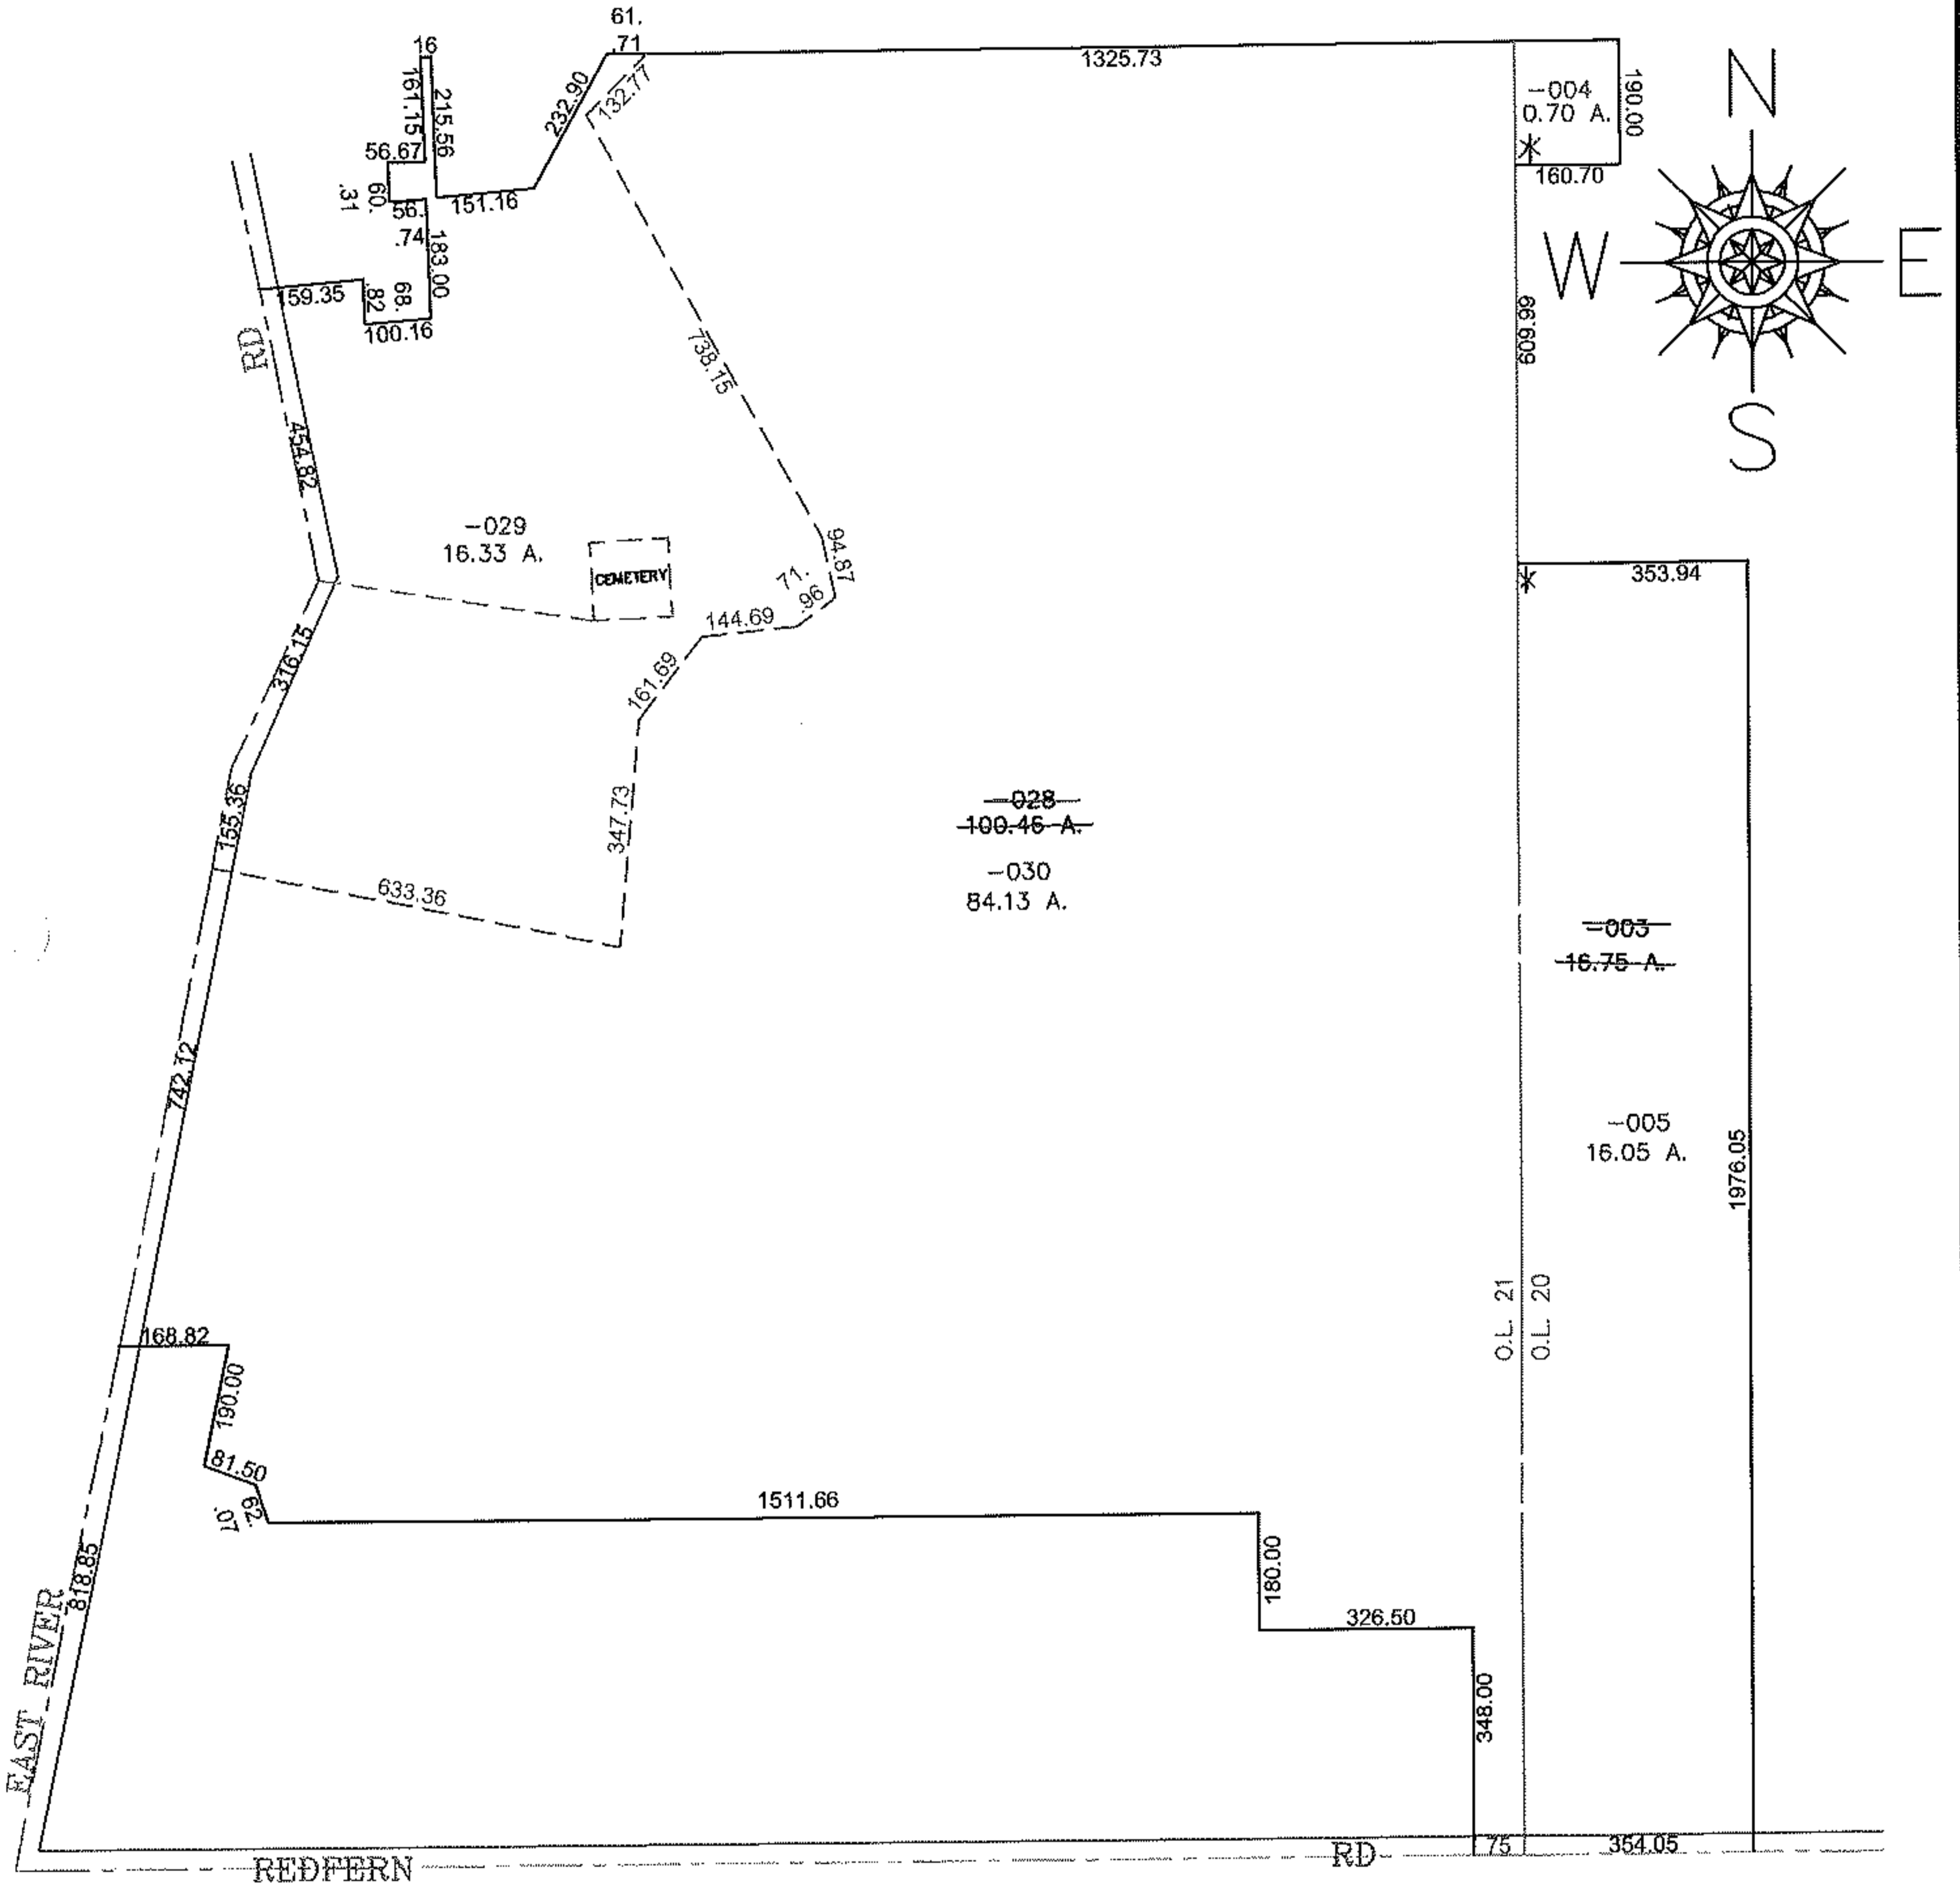

SPLITS/DEEDS PROCESSED
 LORAIN COUNTY TAX MAP DEPARTMENT
 226 MIDDLE AVE. ELYRIA, OHIO

SURVEYED BY: JAMES B ROOT
 CLOSURE: 0.00 : 10,000
 MAP PAGE(S): 12-00-021-A
 APPROVED BY: JAH DATE: 10-23-2012
 SCALE: 1" = 400 PRIOR INST.: OR 302/13