


PARENT PARCEL: 18-00-020-000-082

CHILD PARCEL: XX-XX-XXX-XXX-XXX

STARTING POINT: XXXXXX

15-03092-C

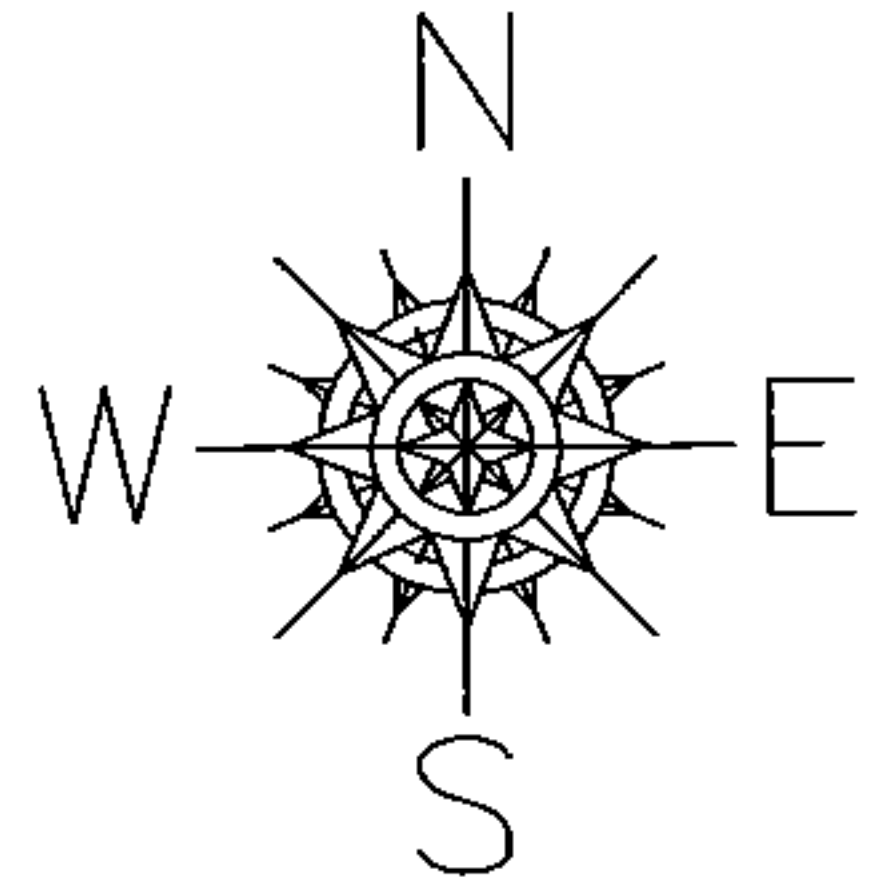

ACREAGE CORRECTION

18-00-020-000-082

~~2.77 A.~~

3.51 A.

CORR. PER DV 972/985


CORR. PER SURV.

C.E. PENFOUND


SURVEY BEFORE NEXT TRANSFER

DOESN'T CLOSE 1 : 3400

ASHLAND-OBERLIN RD. (S.R. 58)

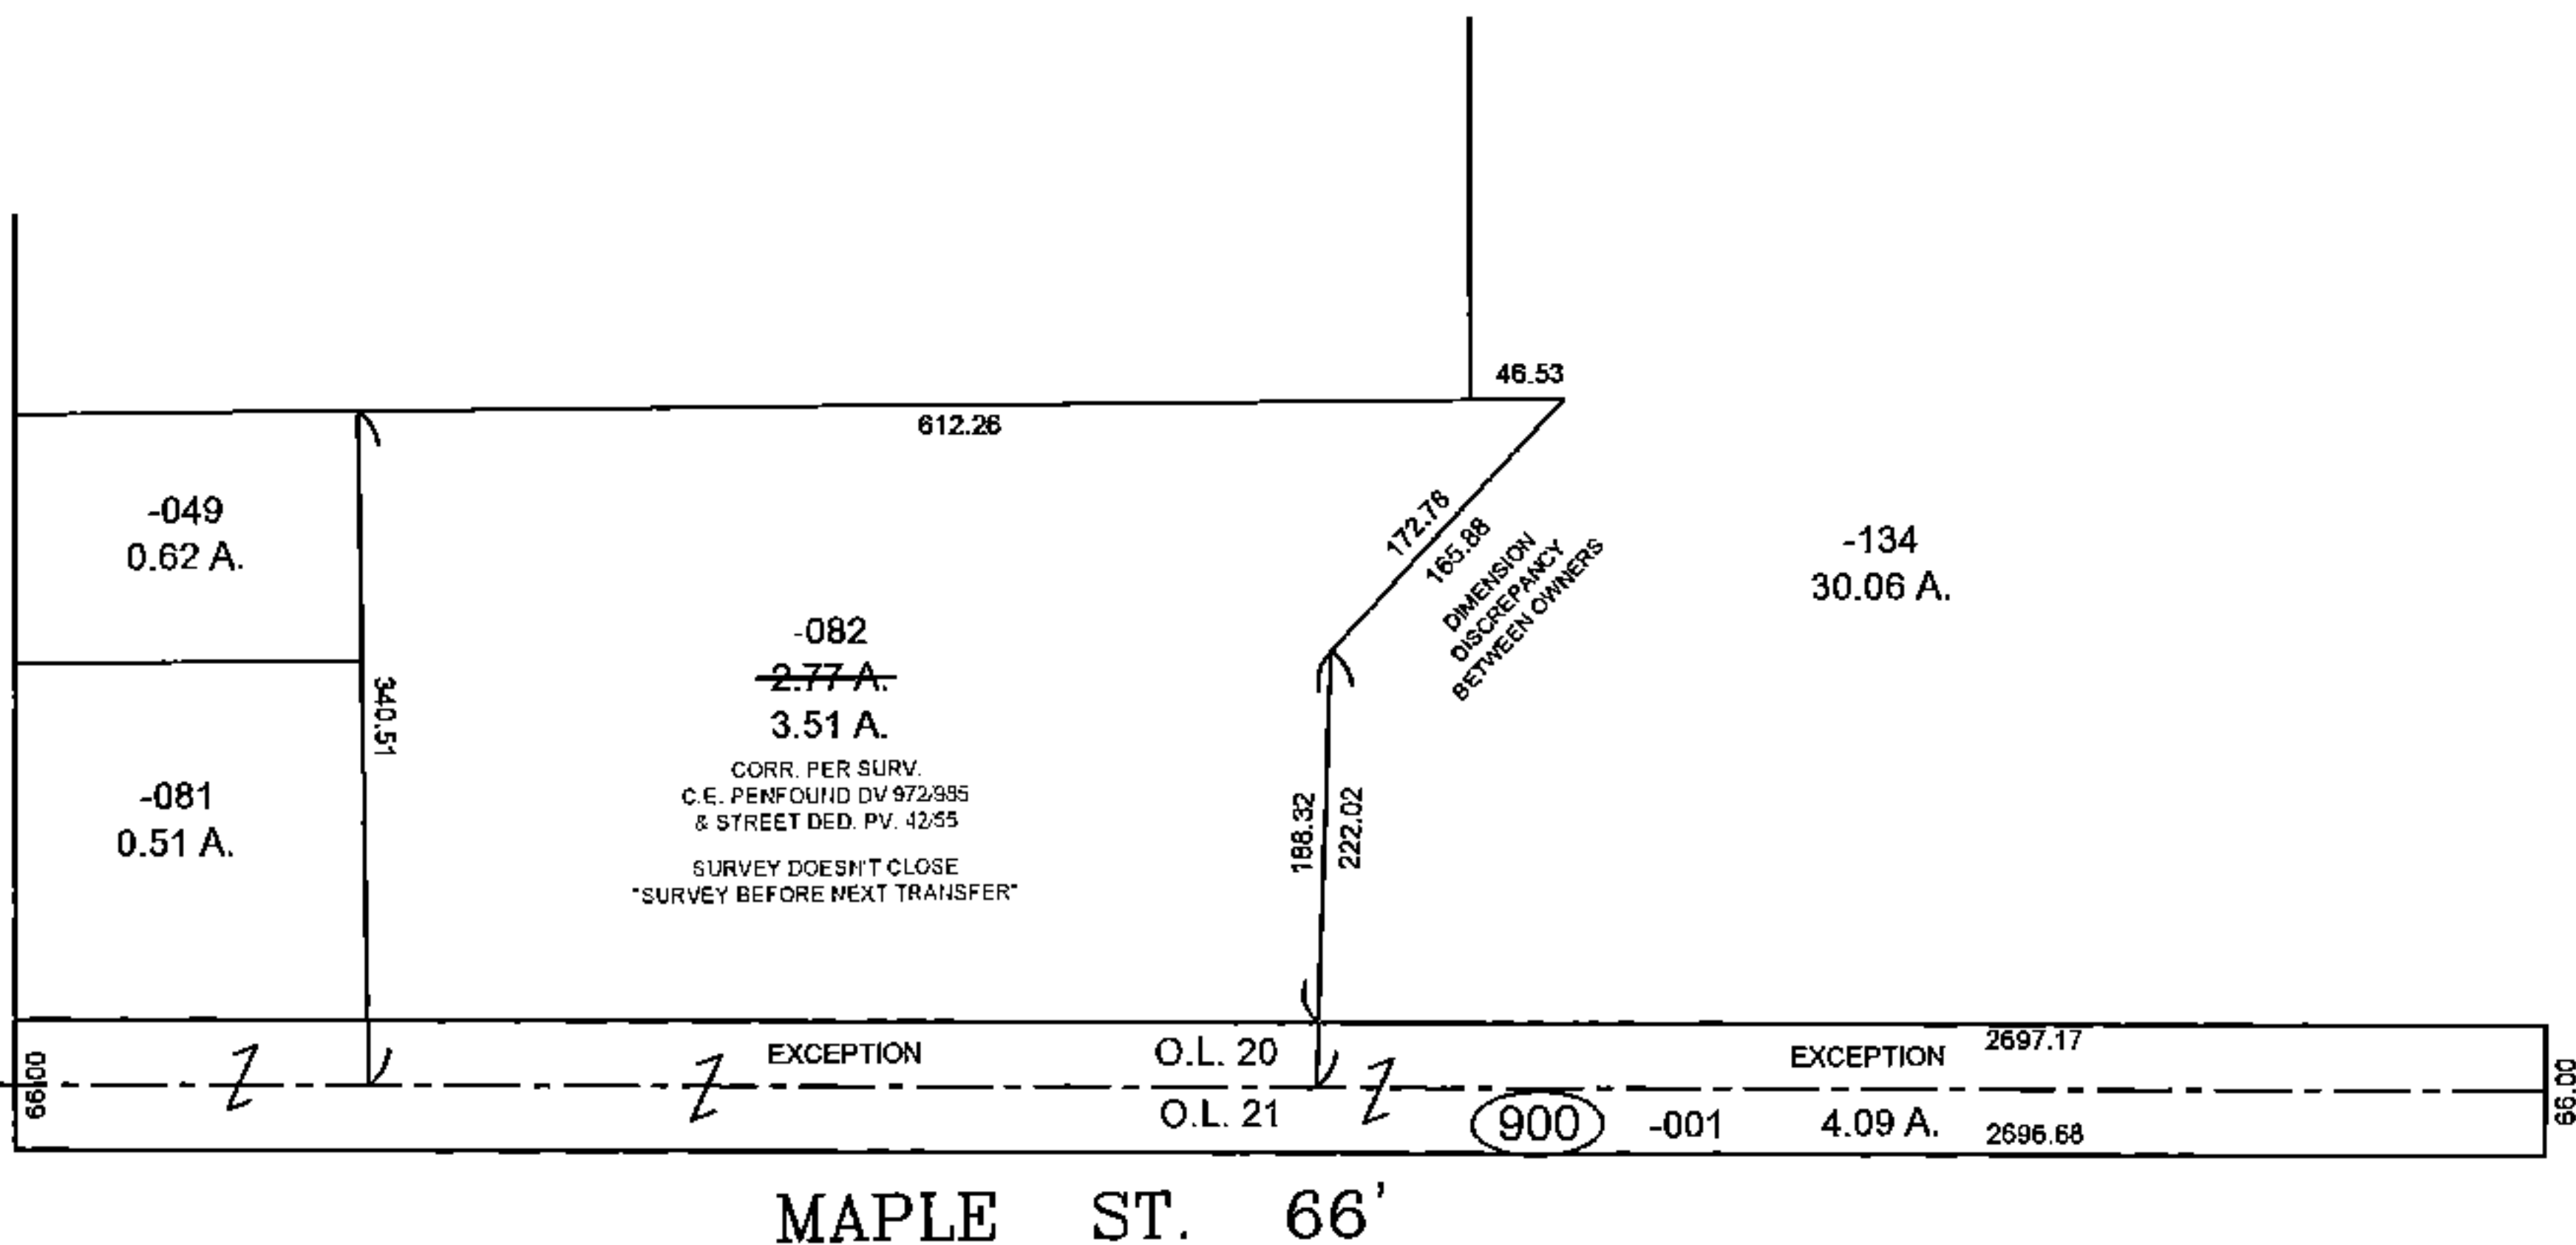

MAPLE ST. 66'

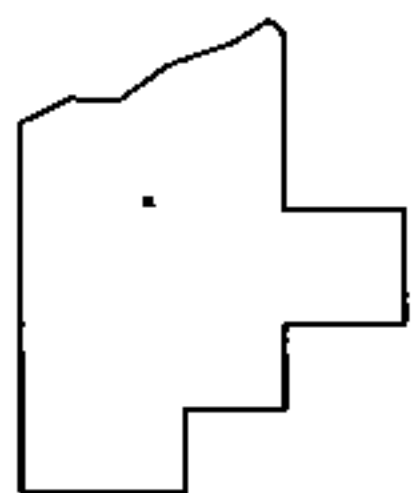

SPLITS/DEEDS PROCESSED
LORAIN COUNTY TAX MAP DEPARTMENT
226 MIDDLE AVE. ELYRIA, OHIO

SURVEYED BY: C.E. PENFOUND

CLOSURE: 1 : 3400 DOESN'T CLOSE

MAP PAGE(S): 18-00-020

APPROVED BY: TJS DATE: 1/16/15

SCALE: 1" = 200 PRIOR INSTRUMENT: DV 972/985