
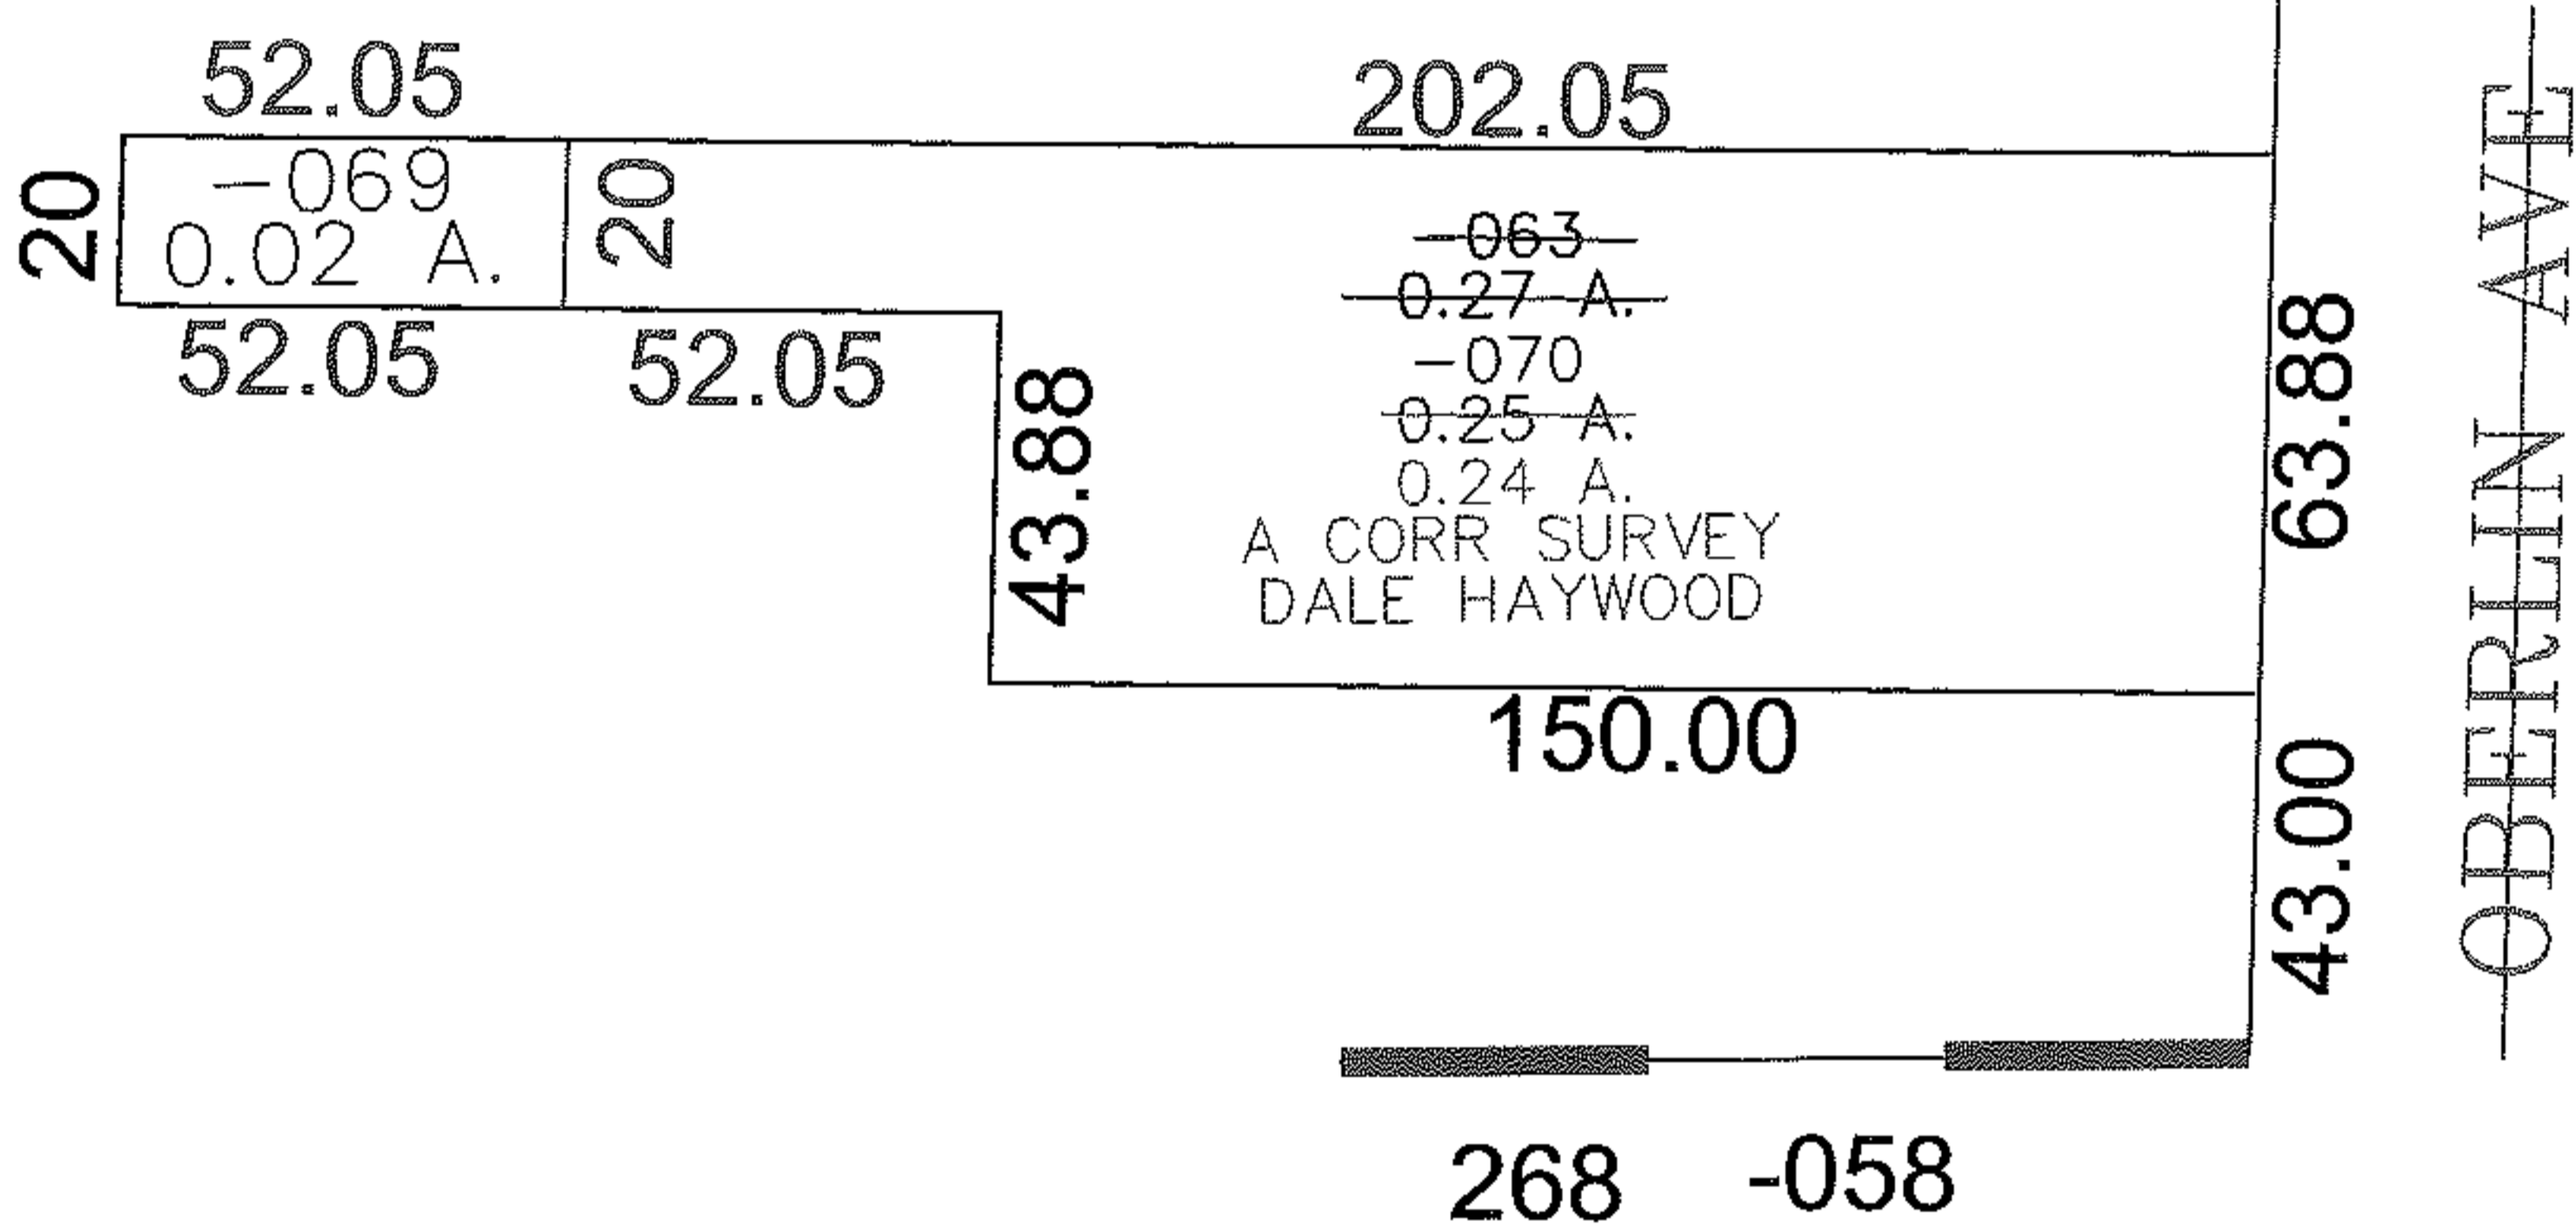


PARENT PARCEL: 02-02-016-109-063

CHILD PARCEL: 02-02-016-109-069, -070

STARTING POINT: SIDELINE OF OBERLIN AVE & NORTH LINE OF S/L 268

12-03094

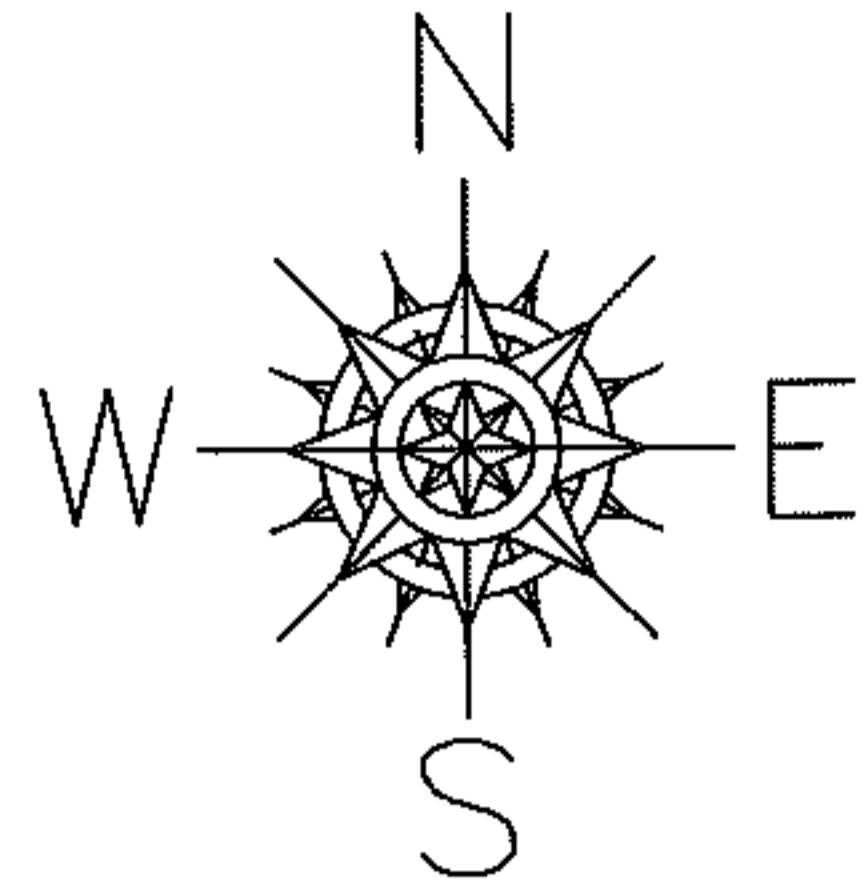

SPLITS/DEEDS PROCESSED

LORAIN COUNTY TAX MAP DEPARTMENT  
226 MIDDLE AVE. ELYRIA, OHIO

SURVEYED BY: DALE HAYWOOD

CLOSURE: 0.00 : 10,000

MAP PAGE(S): 02-02-016-B

APPROVED BY: JAH DATE: 11-15-2012

SCALE: 1" = 50' PRIOR INST.: 20110381729